




PLAT OF SUEVEY OF LOT 12 BLK "H" OF UNITS
OF COUNTRY CLUB ESTATES IN THE VILLAGE OF
FONTANA-ON-GENEVA-LAKE, WALWORTH CO., WISC.

10-9-41

Lloyd L Jensen
R.G.

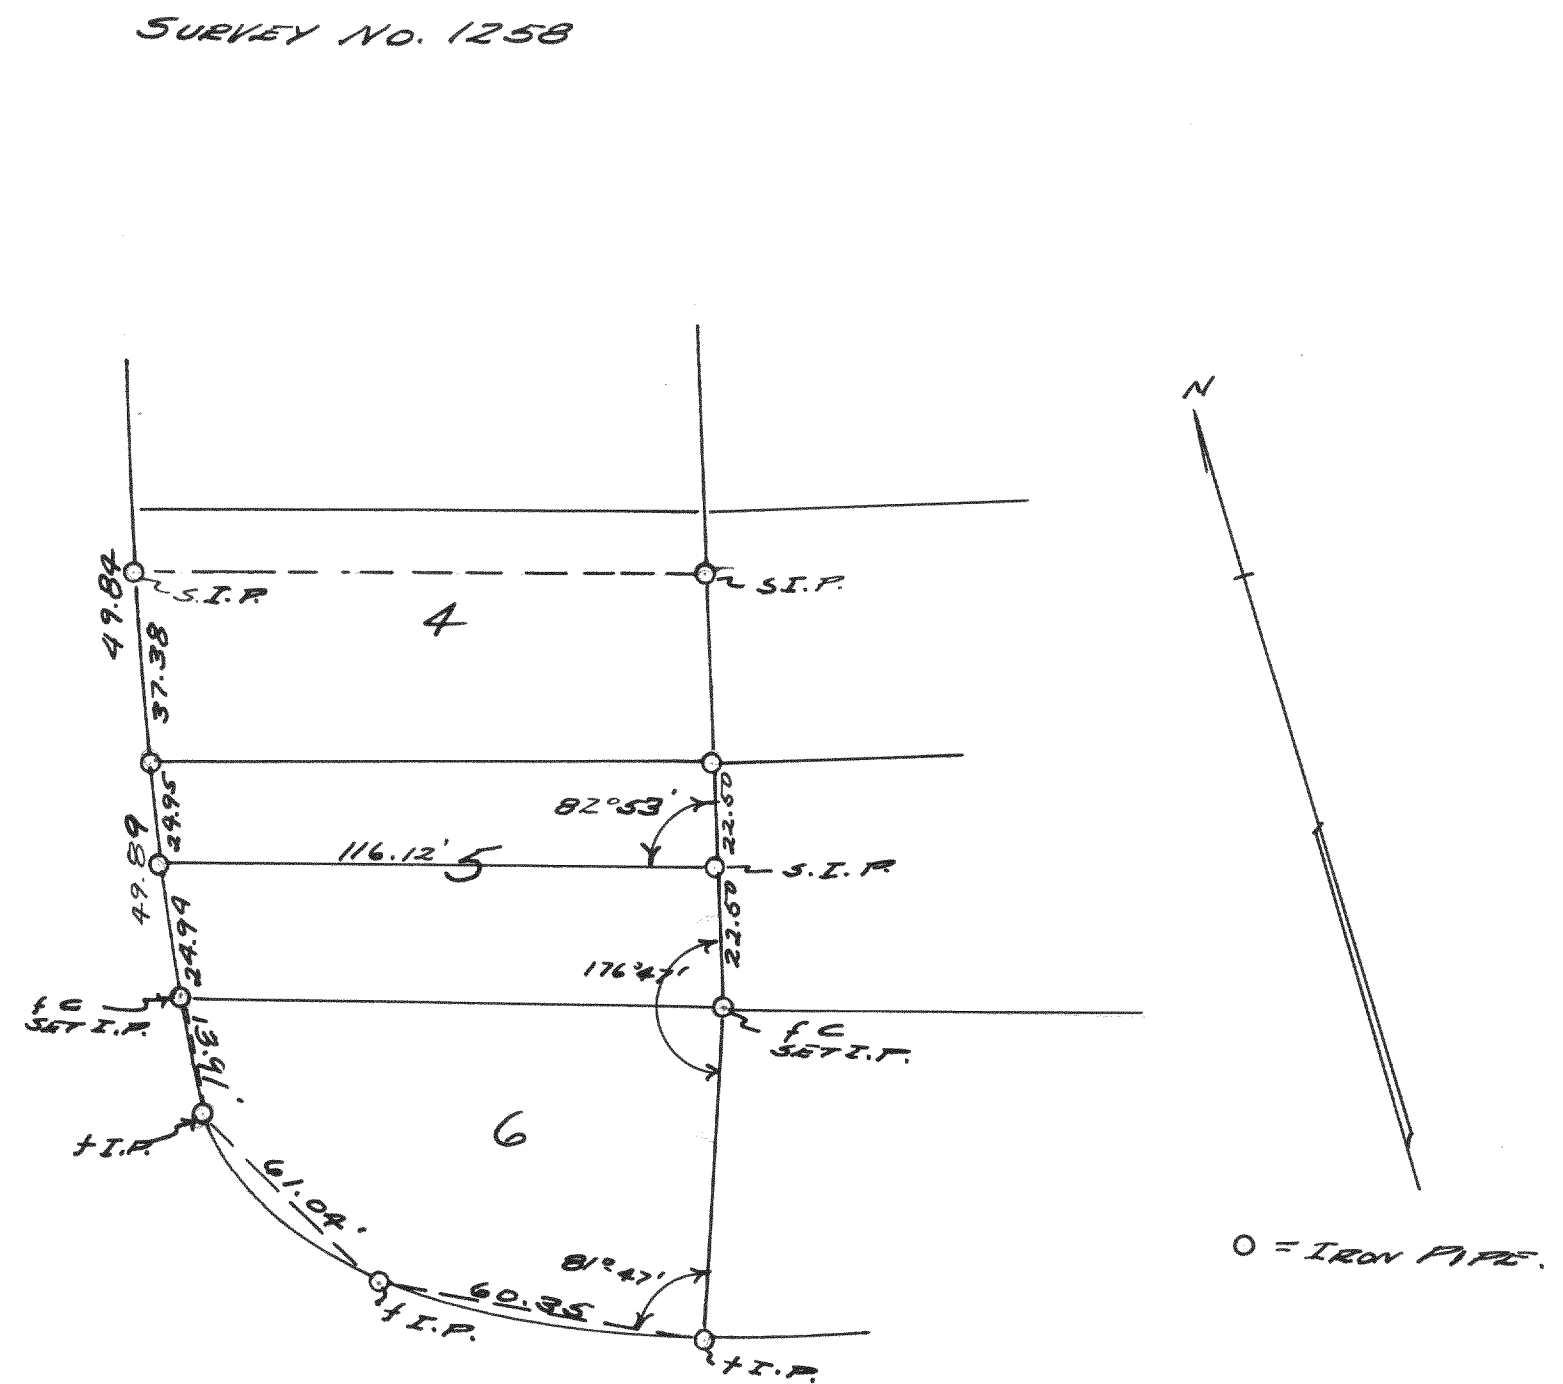

PLAT OF SURVEY OF LOT 6 AND THE SOUTH
HALF OF LOT 5 OF BLOCK 3 OF INDIAN HILLS
SUBDIVISION, FONTANA, WALWORTH CO., WISC.
AUG. 1941

Lloyd L Jensen
W.E.J.