



2002

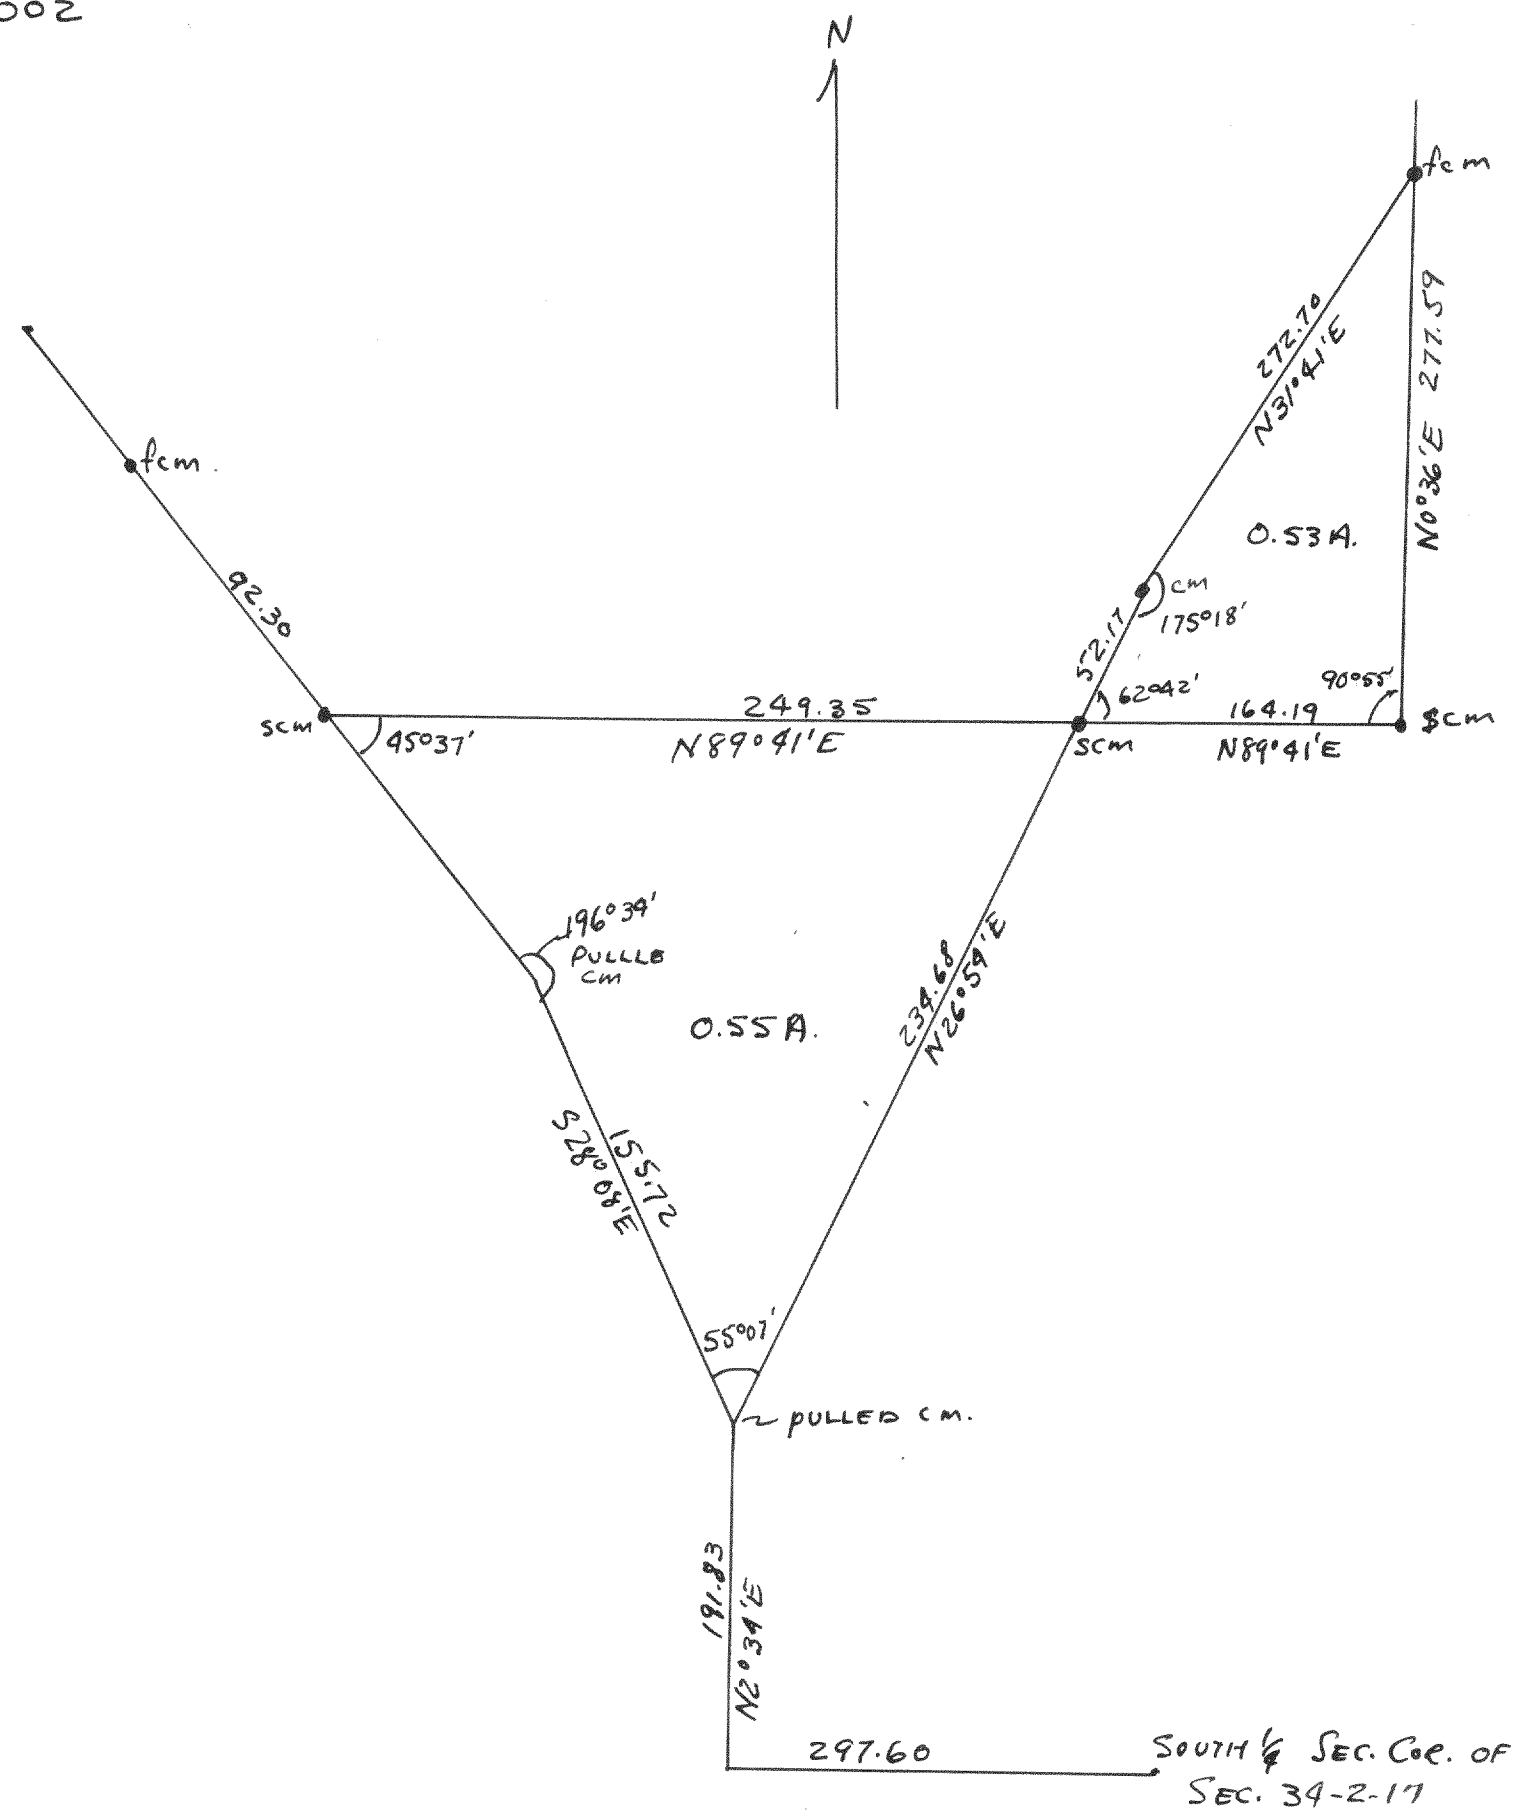

Plat of survey of parcel of land located in Sec. 34, T2N R17E
of Walworth County, Wis.
Jan 1949
Lloyd L. Jensen
County Surveyor
9EB

2003

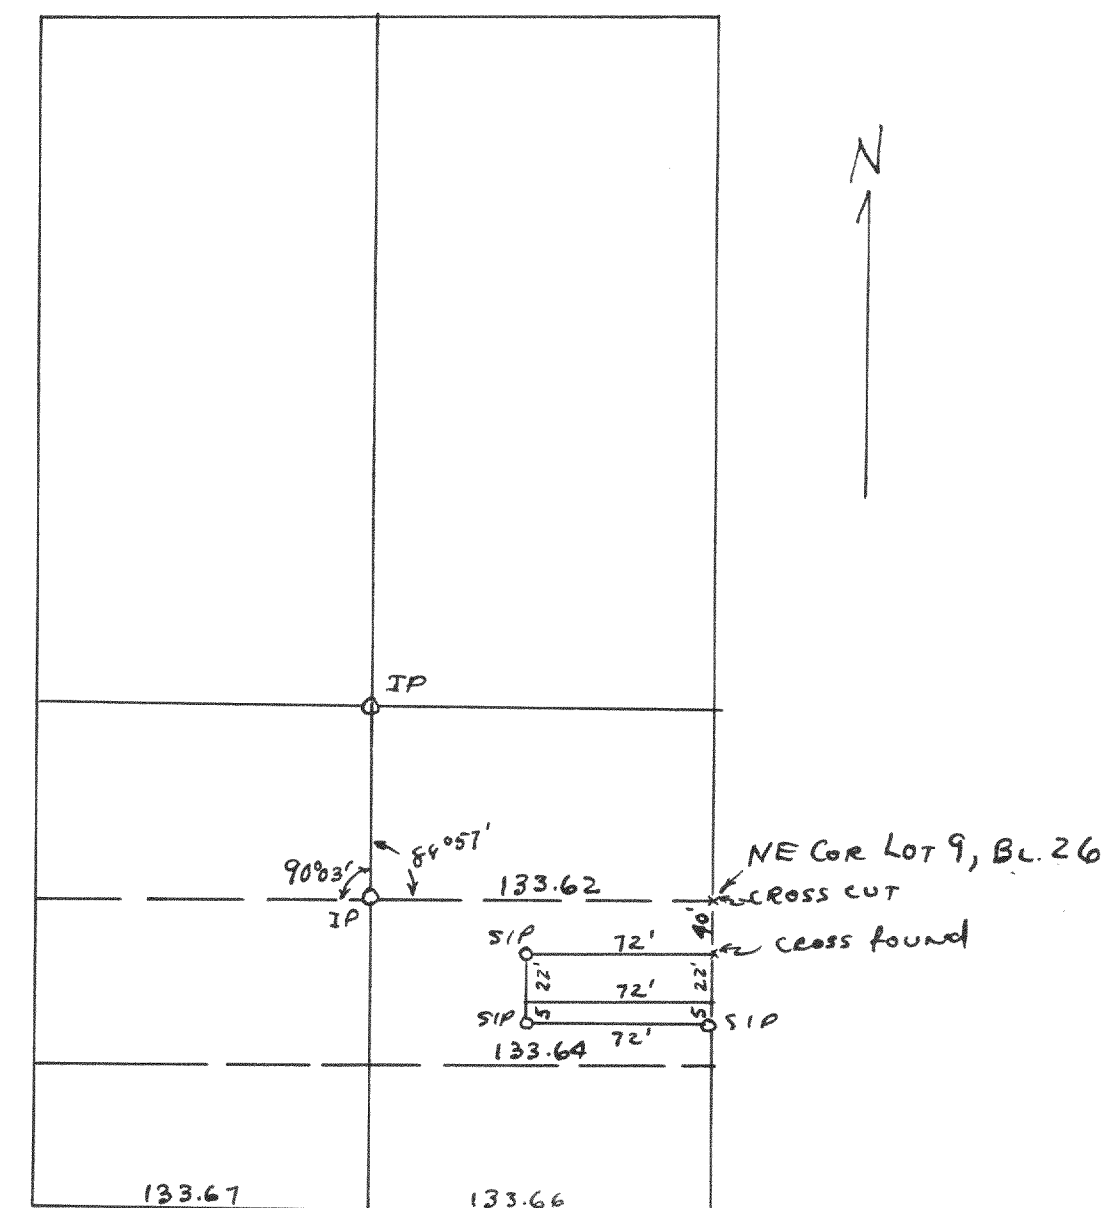

Plat of survey of a part of lot 9, Bl. 26, of the original
plat, City of Elkhorn, Walworth County, Wis.
1948
Lloyd L. Jensen
County Surveyor
9EB