



2008

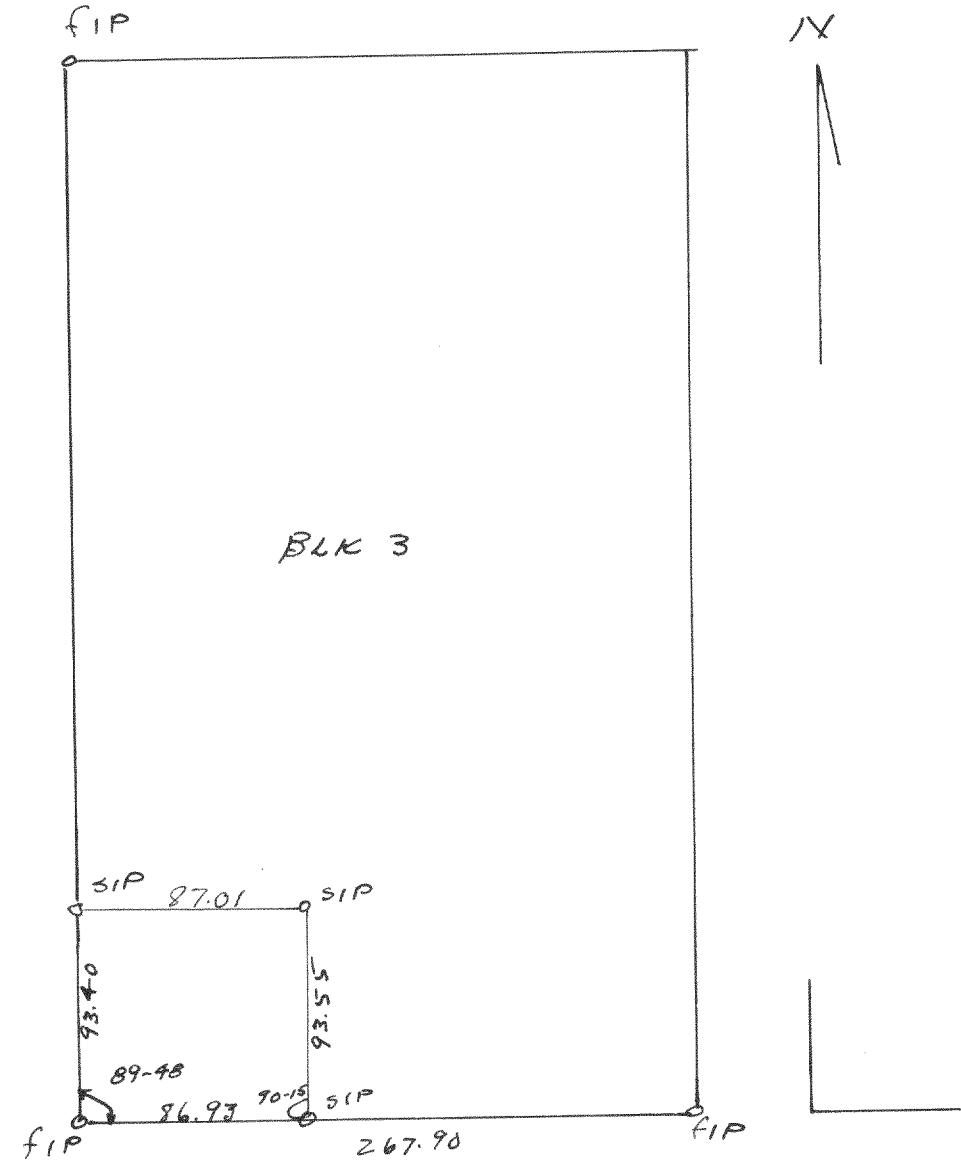

Plot of survey of part of lots 283 Blk 3 of
the original Plat of Elkhorn city of Elkhorn,
Walworth County, Wis
1948
Lloyd L Jensen
cert.

2009

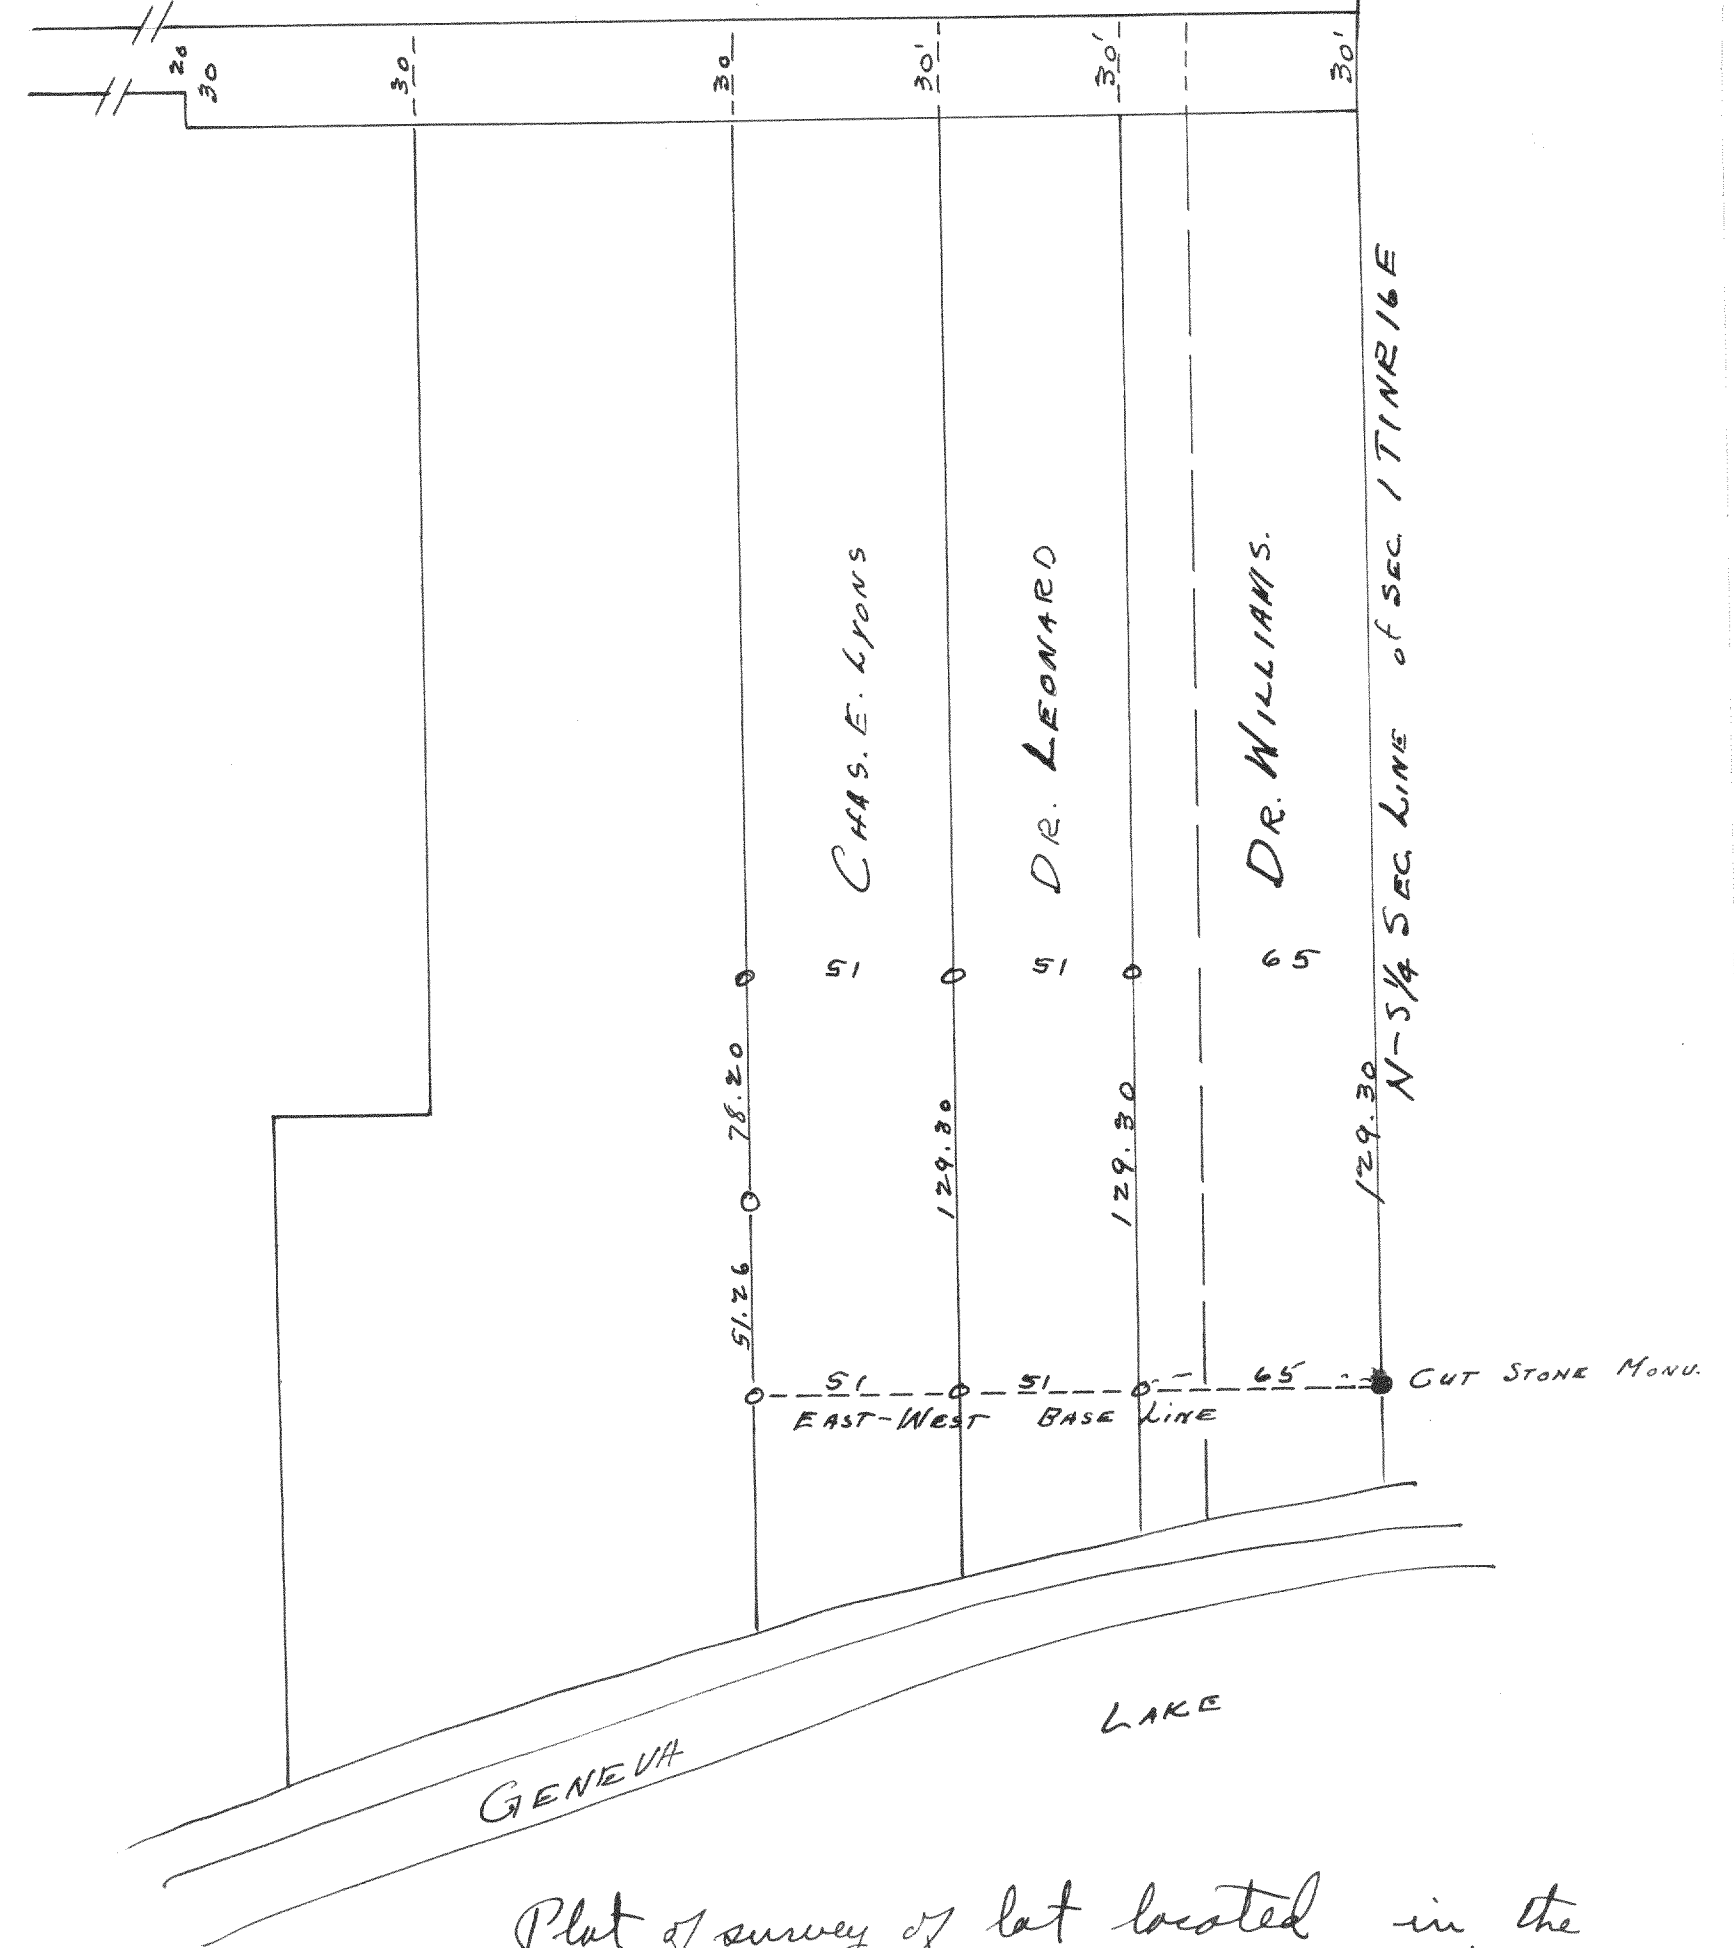

Plot of survey of lot located in the
S.W. 1/4 of section 1 T1N R16 E, Village of
Williams Bay, Walworth County
1948
Lloyd L Jensen
cert.

C.M. 413
S.W. COR. of
UNIV. HTS. SUBD.