



414

2010

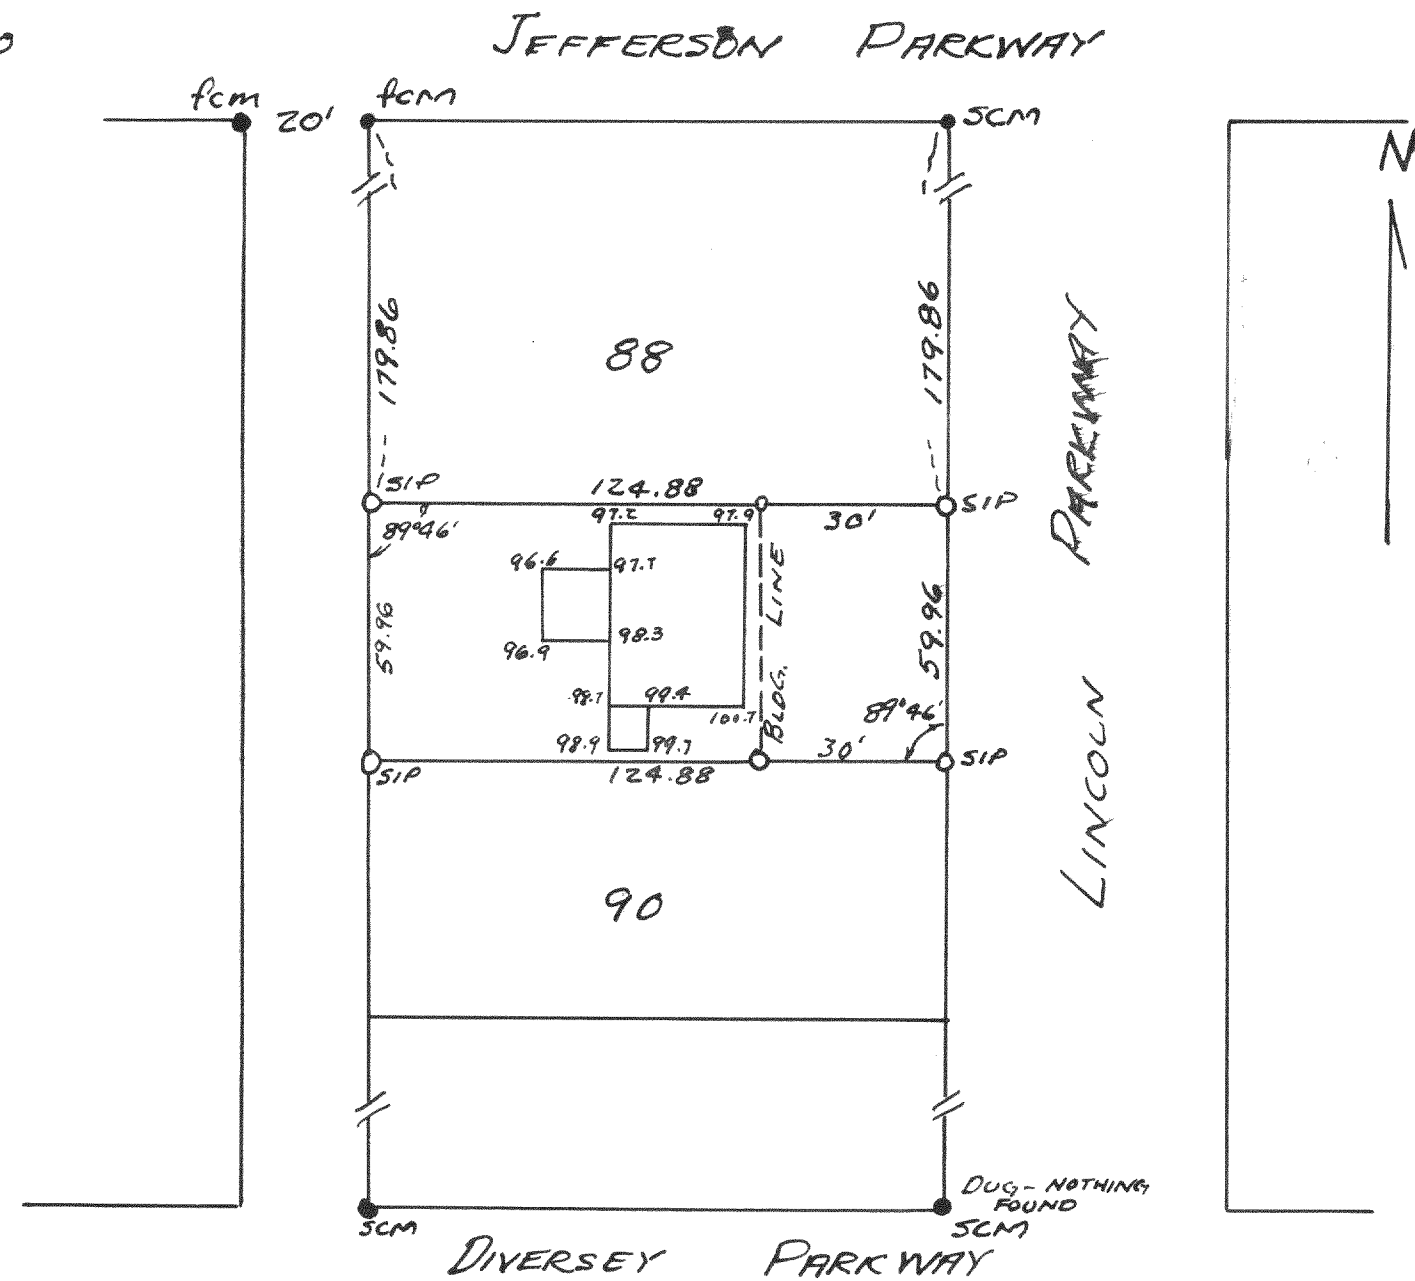

Plat of Survey of Lot 89 in the Original
Cedar Point Park Subdivision in the
Village of Williams Bay, Walworth County
June 23, 1948
Lloyd L. Jensen
946

#2020

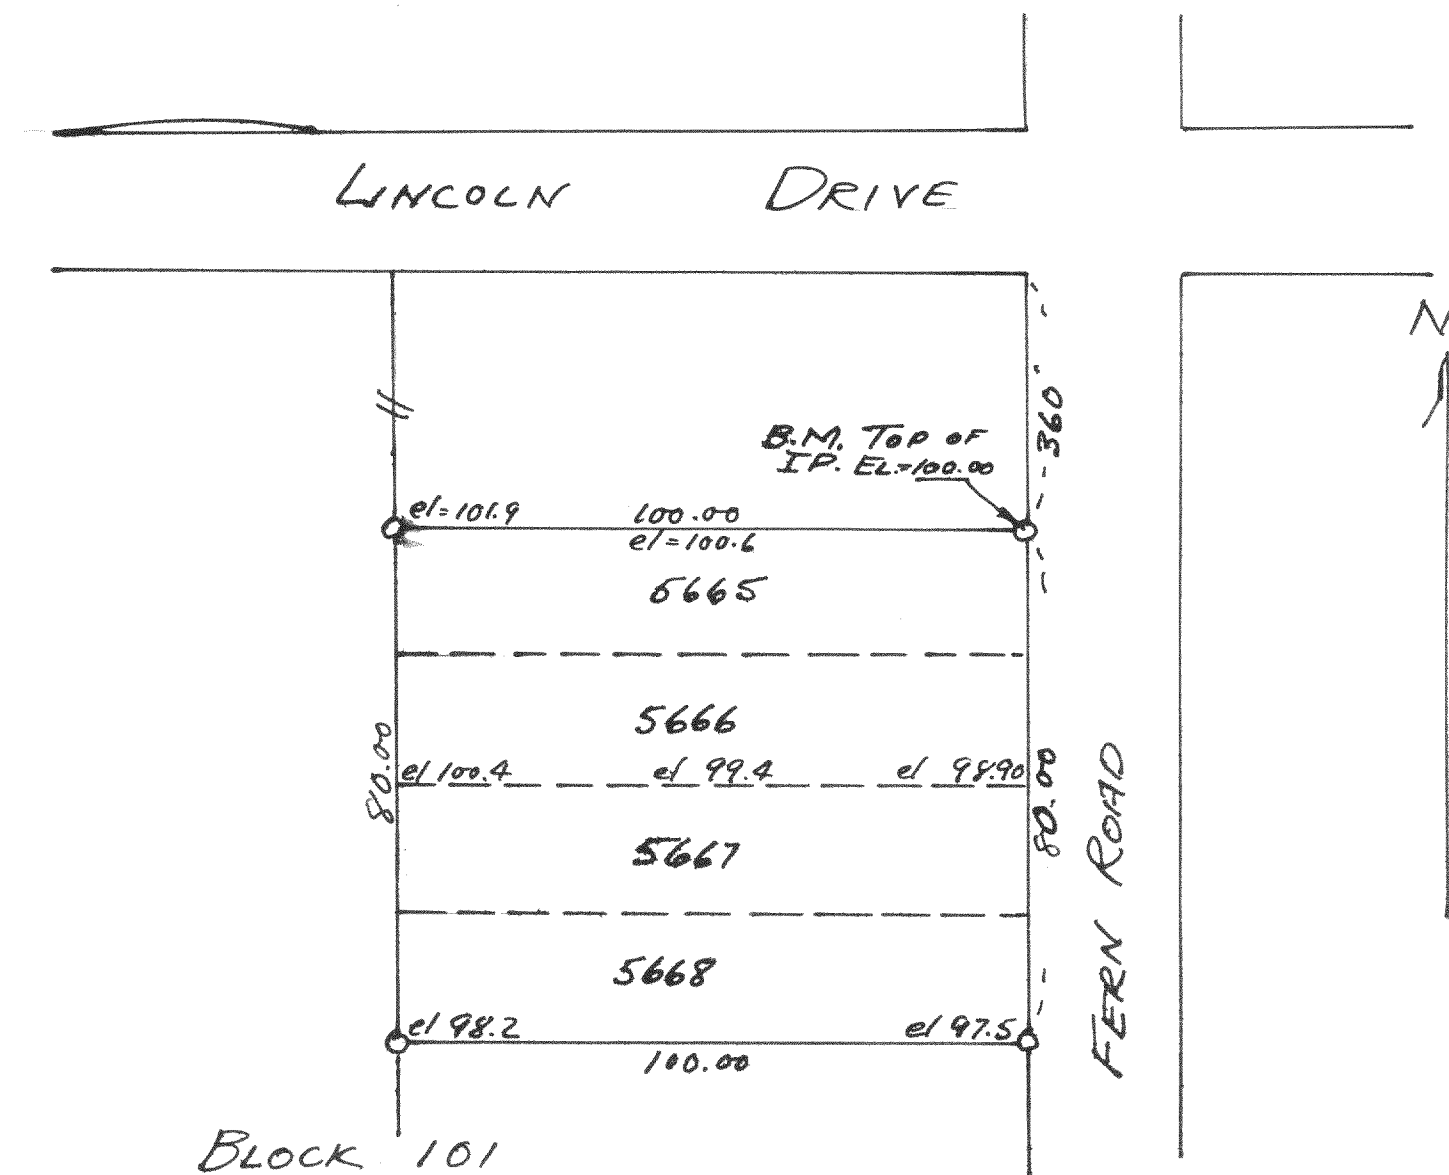

Plat of survey of Lots 5665-5668, Lake Como
Beach Subdivision located in Section 28,
T2N R17E of Walworth County, Wisconsin
Feb 28 1948
Lloyd L. Jensen
County Surveyor