



2025

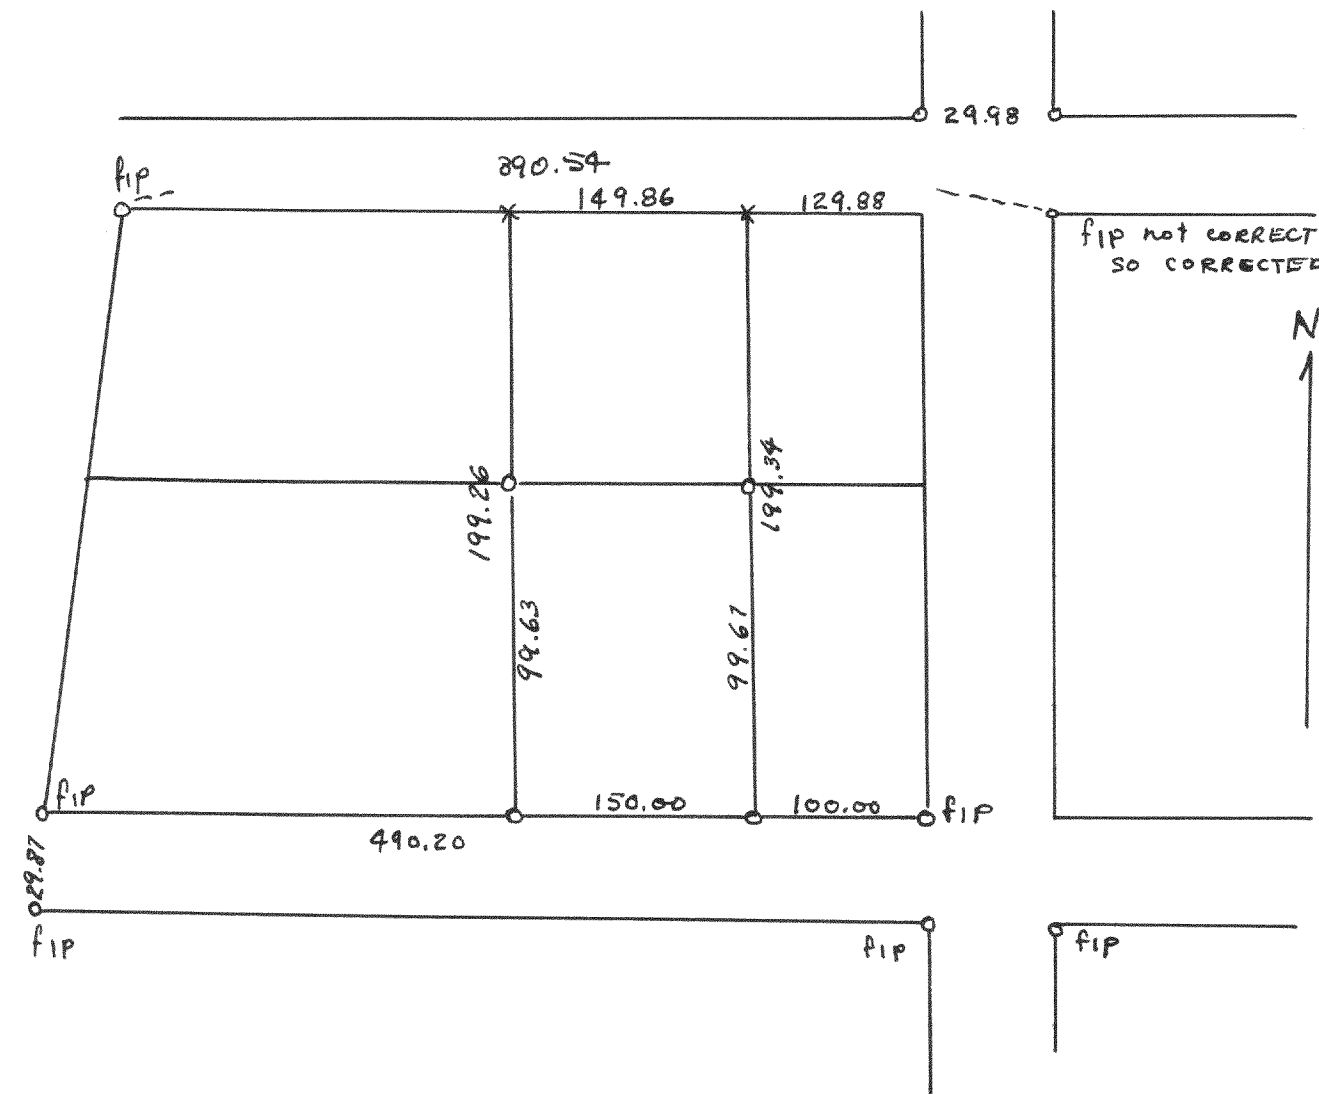

Plat of survey of lots 6-10 Block 14 of Skansen Subdivision located in SW 1/4 Section 9, T3N R15E 1949

Lloyd L. Jensen JRB
County Surveyor


2027

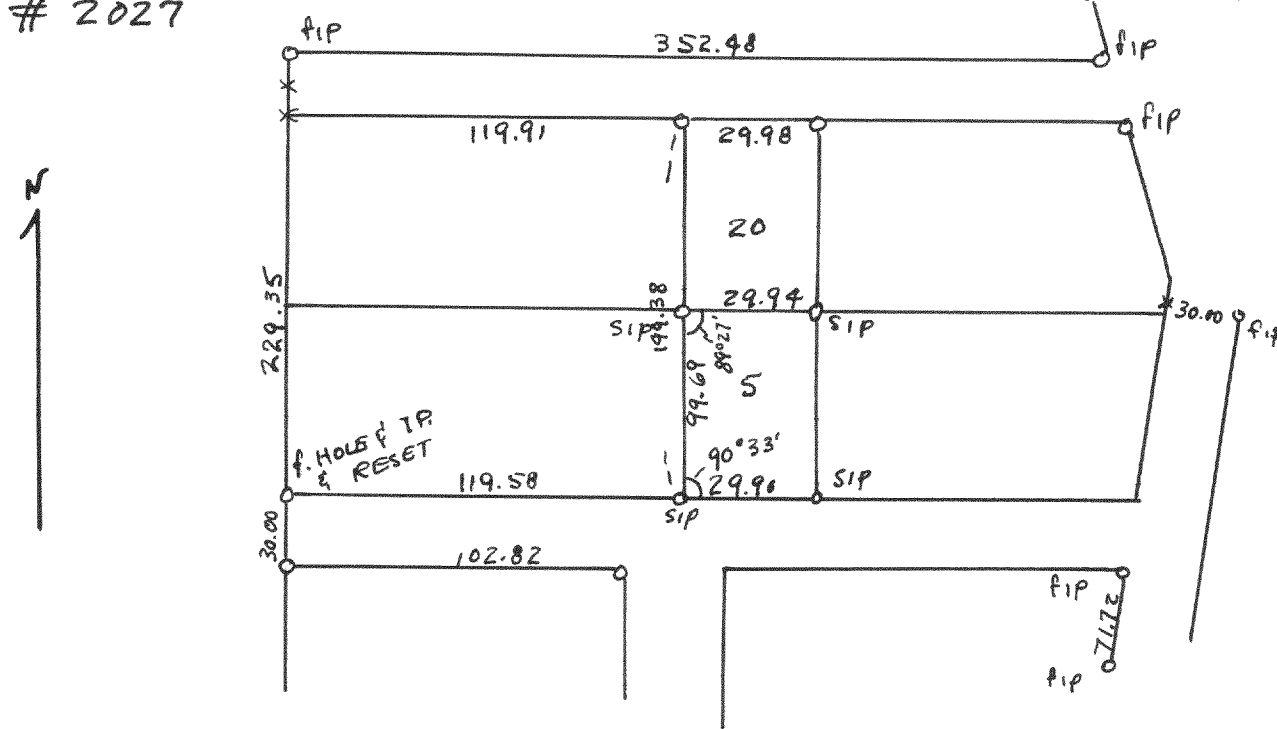

Plat of Survey of lots 5 & 20 Block 10 of Skansen Subd. located in SW 1/4 Sec 9, T3N R15E Sept 13, 1949

Lloyd L. Jensen JRB
County Surveyor


2026

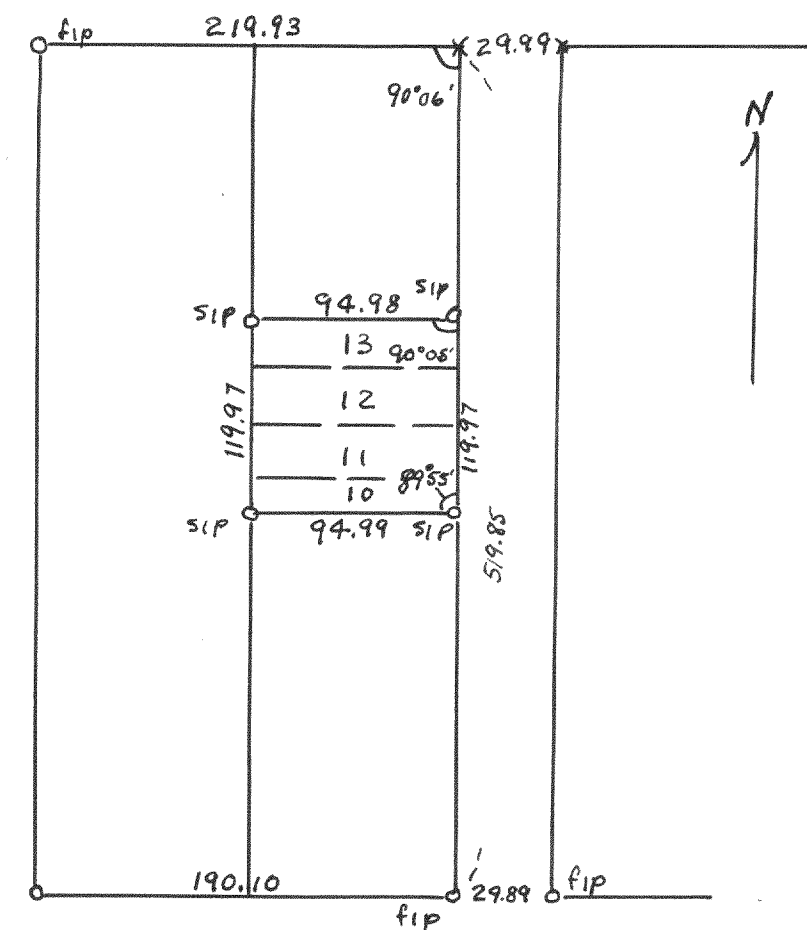

Plat of survey of lots 10-13 BL 17 of Skansen subdivision located in SW 1/4 Sec 9, T3N R15E May 6, 1949

Lloyd L. Jensen JRB
County Surveyor

2028

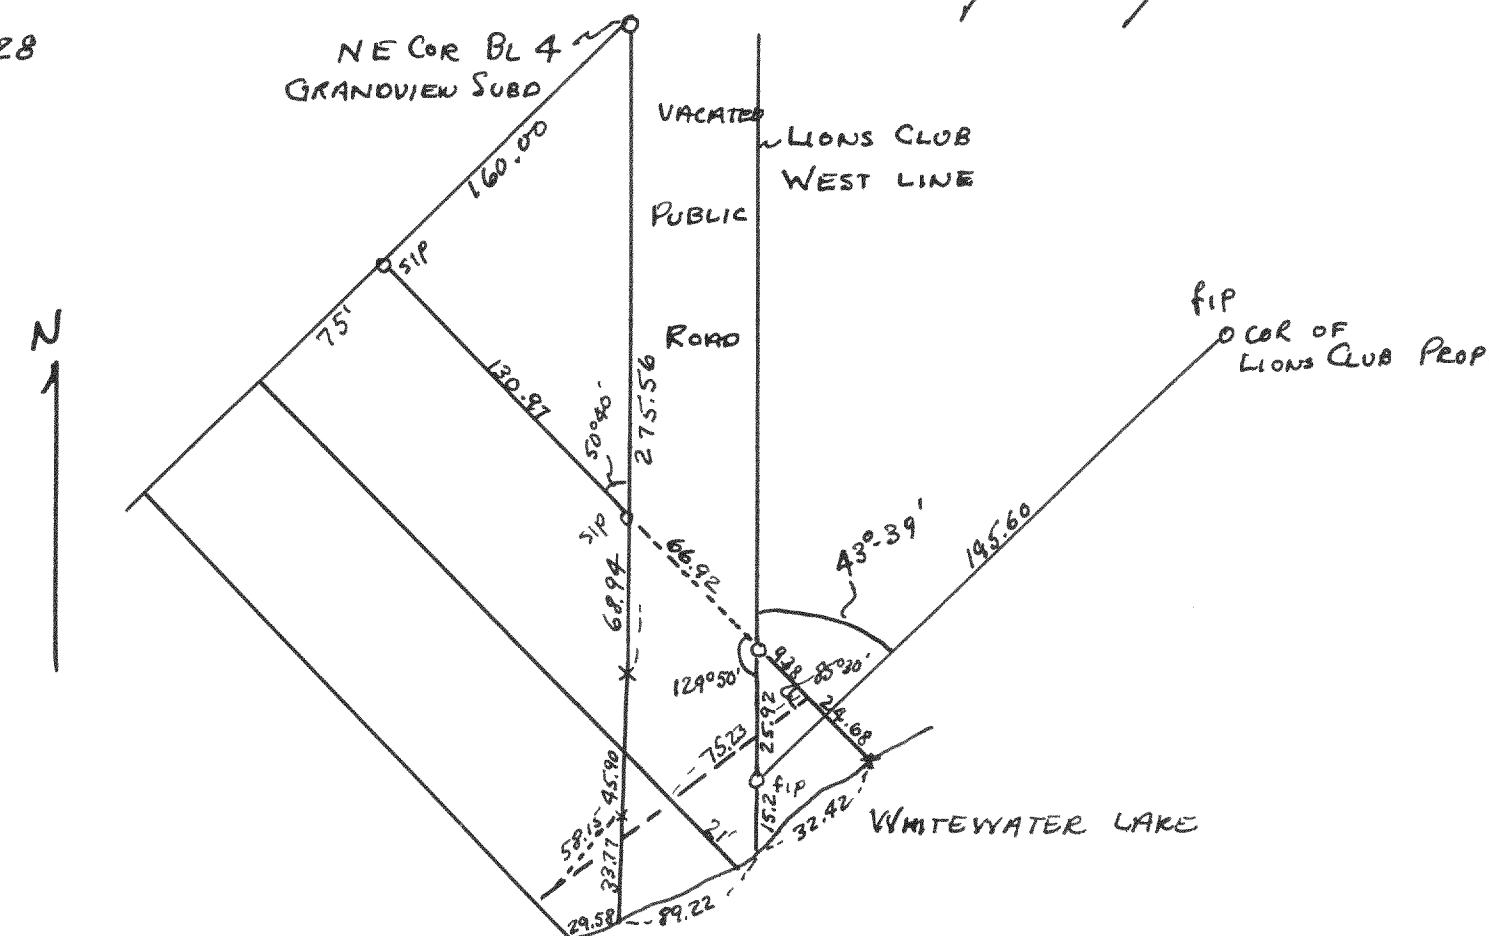

Plat of survey of parcel of land located in the SW 1/4 of Sec. 34, T4N R15E Oct 7, 1949

Lloyd L. Jensen JRB
County Surveyor