



2030

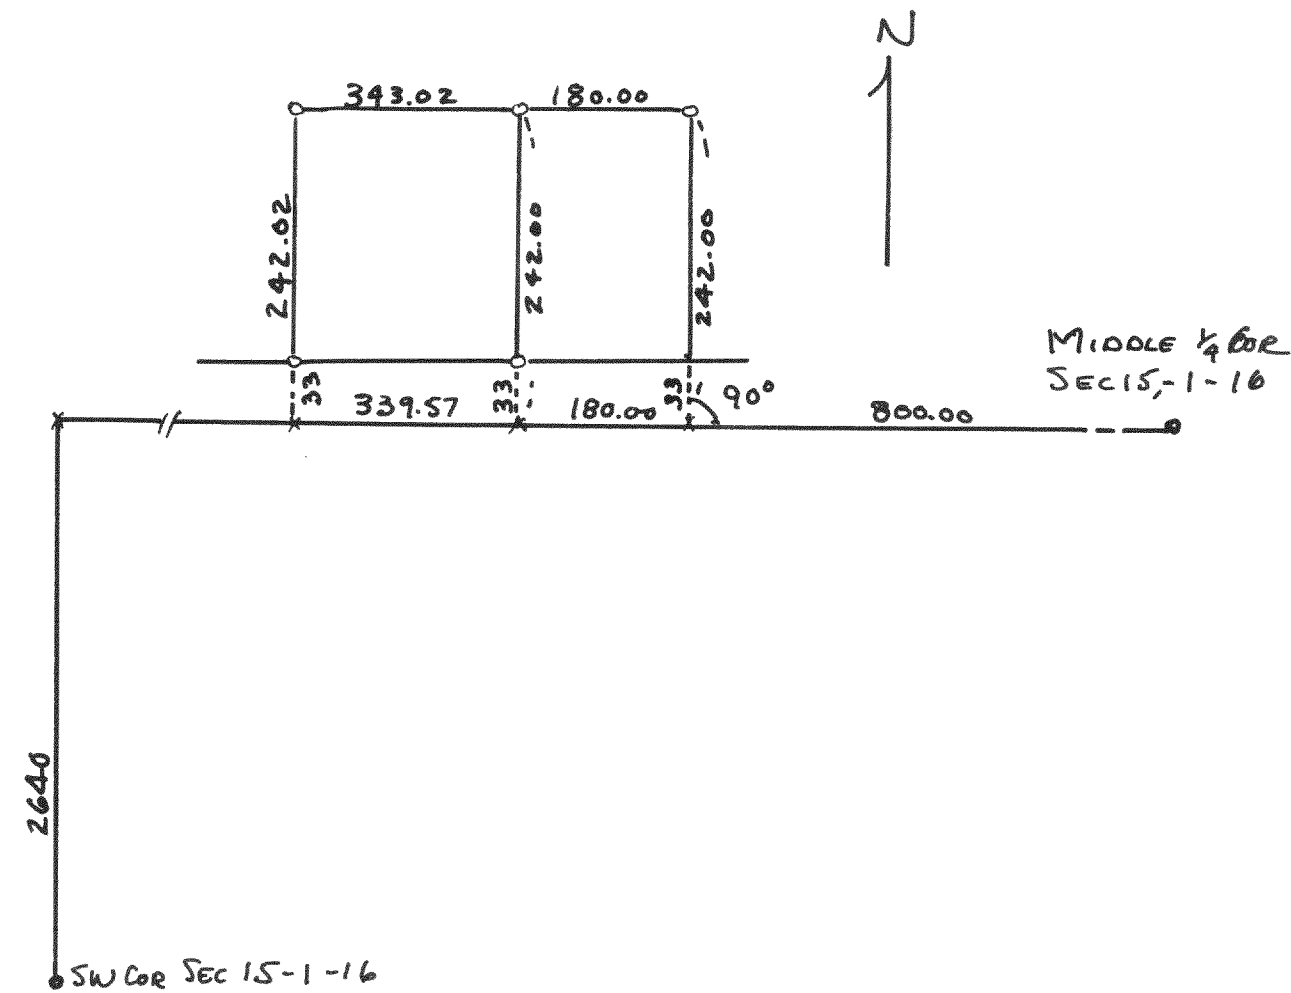

Plat of survey of a parcel of land located in the
NW 1/4 of Sec 15 T14R16E
Jan 7, 1949 Lloyd L. Jensen *LS*

Lloyd L. Jensen ^{per}
County Surveyor


2032

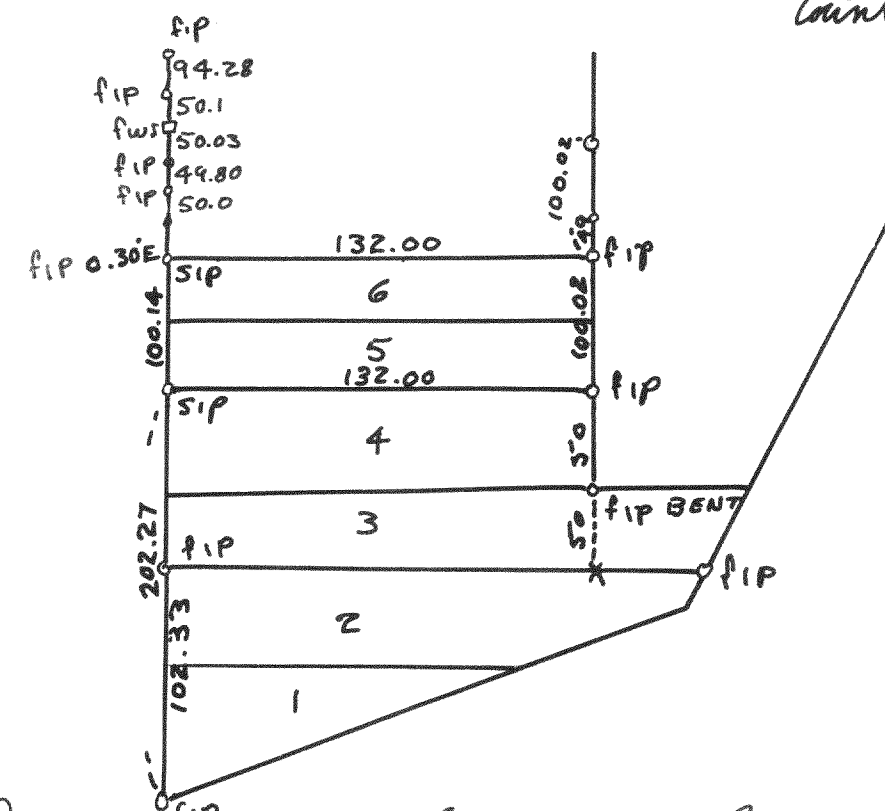

Plat of survey of lots 5 & 6 Block 3 of the Outlet
Oaks Subd. located in Sections 15 & 22, T2N R16E
May, 1949 Lloyd L. Jensen

Lloyd L. Jensen
County Surveyor


2031

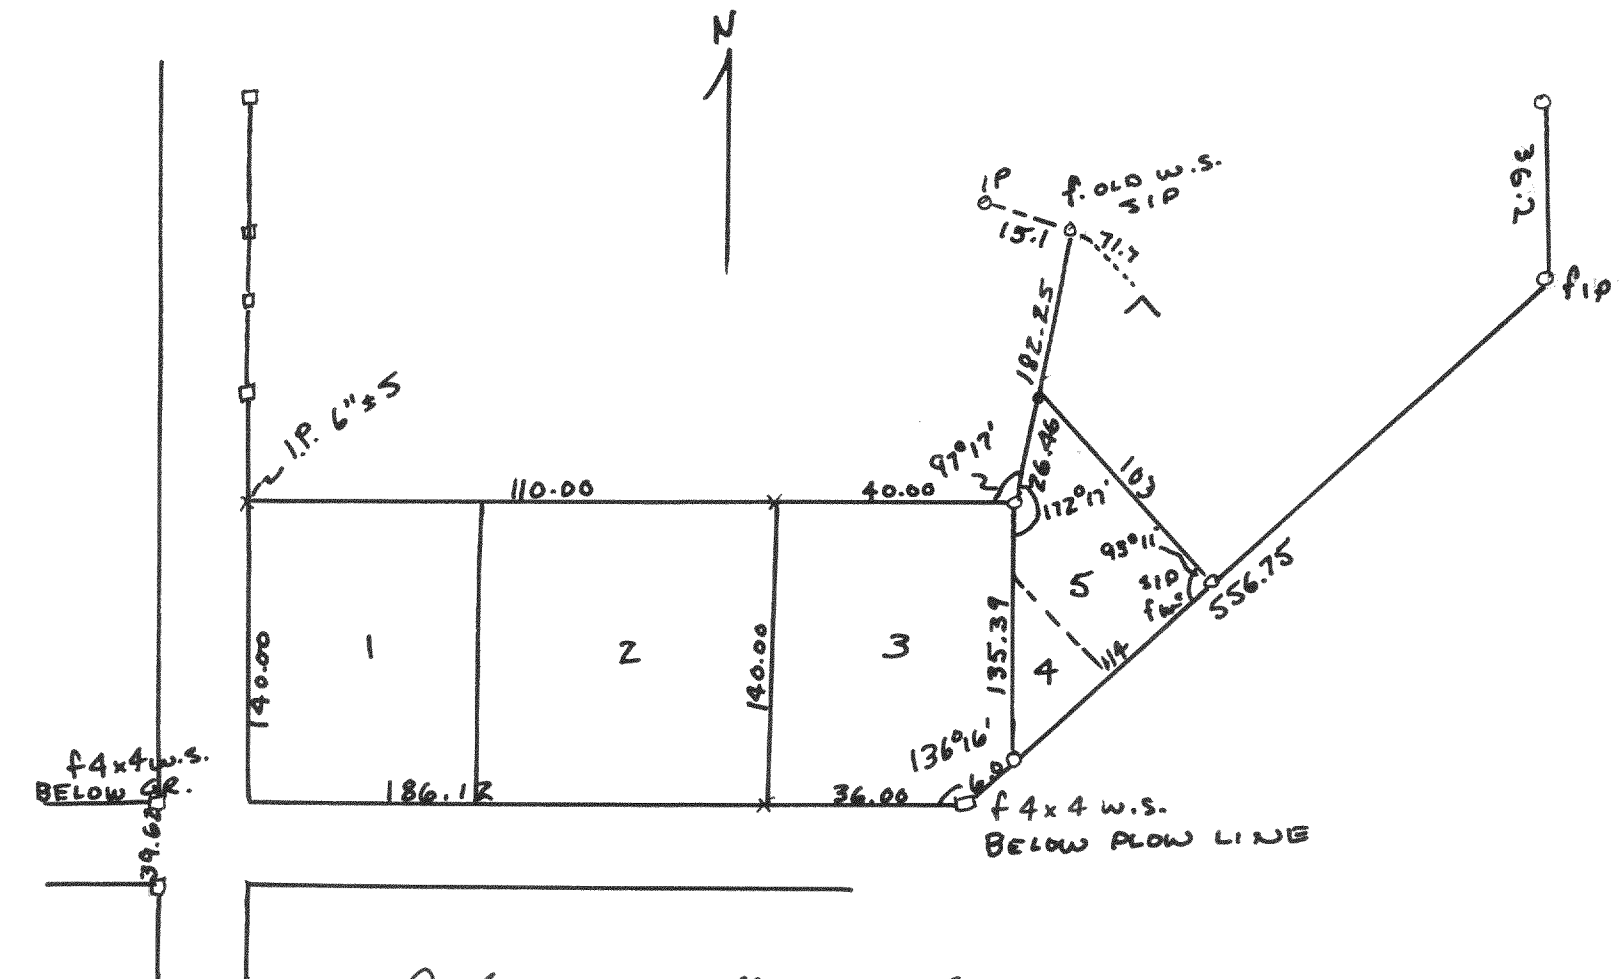

Plat of survey of Lots 4 & 5 of Block 6, Inlet Oaks Subdivision #4
located in Sections 15, & 22, T2N R16E
May 14, 1949
Bryd L. Jensen per

Lloyd S. Jensen per
County Surveyor

2033

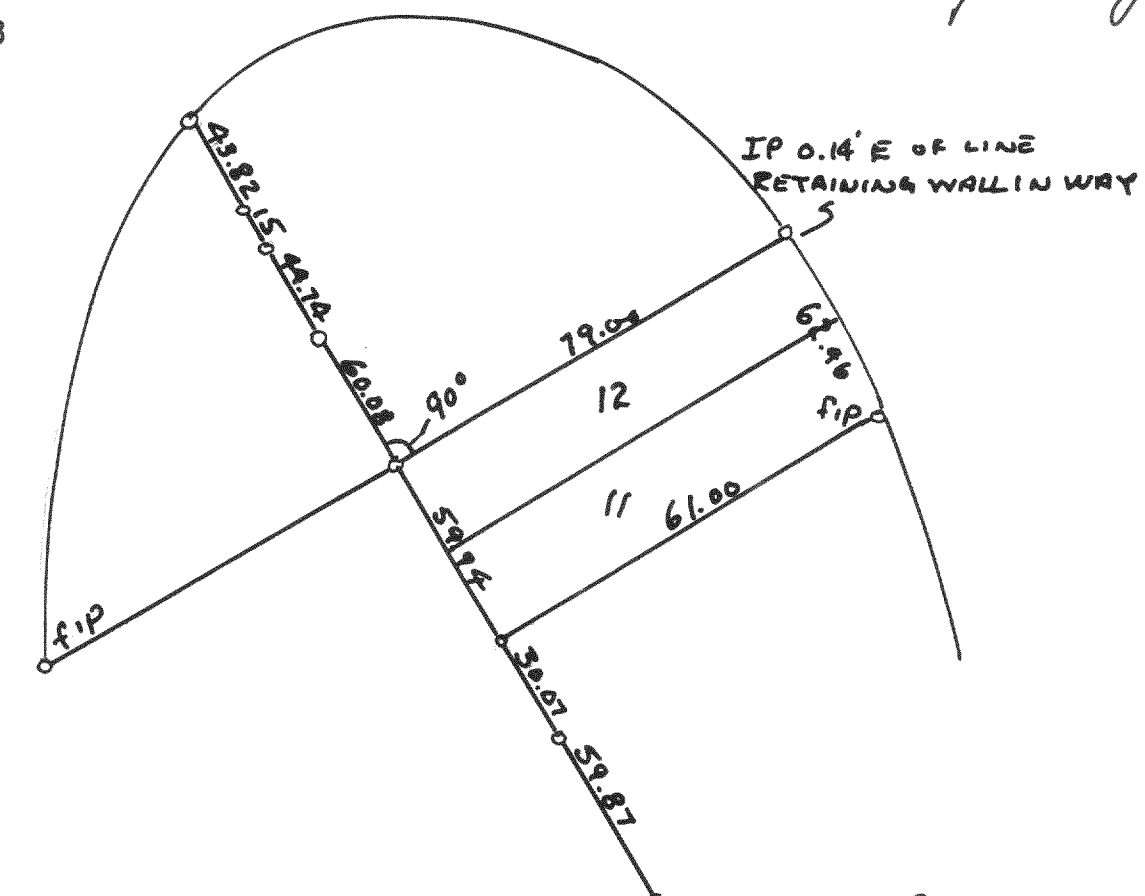

Plat of survey of lots 11, 12 Block I of Delavan Lake Assembly
Grounds located in SE 1/4 Sec 21, T2N R16E
May 20, 1949

Hoyd L. Jensen
County Surveyor H.B.