



SURVEY NO. 1259

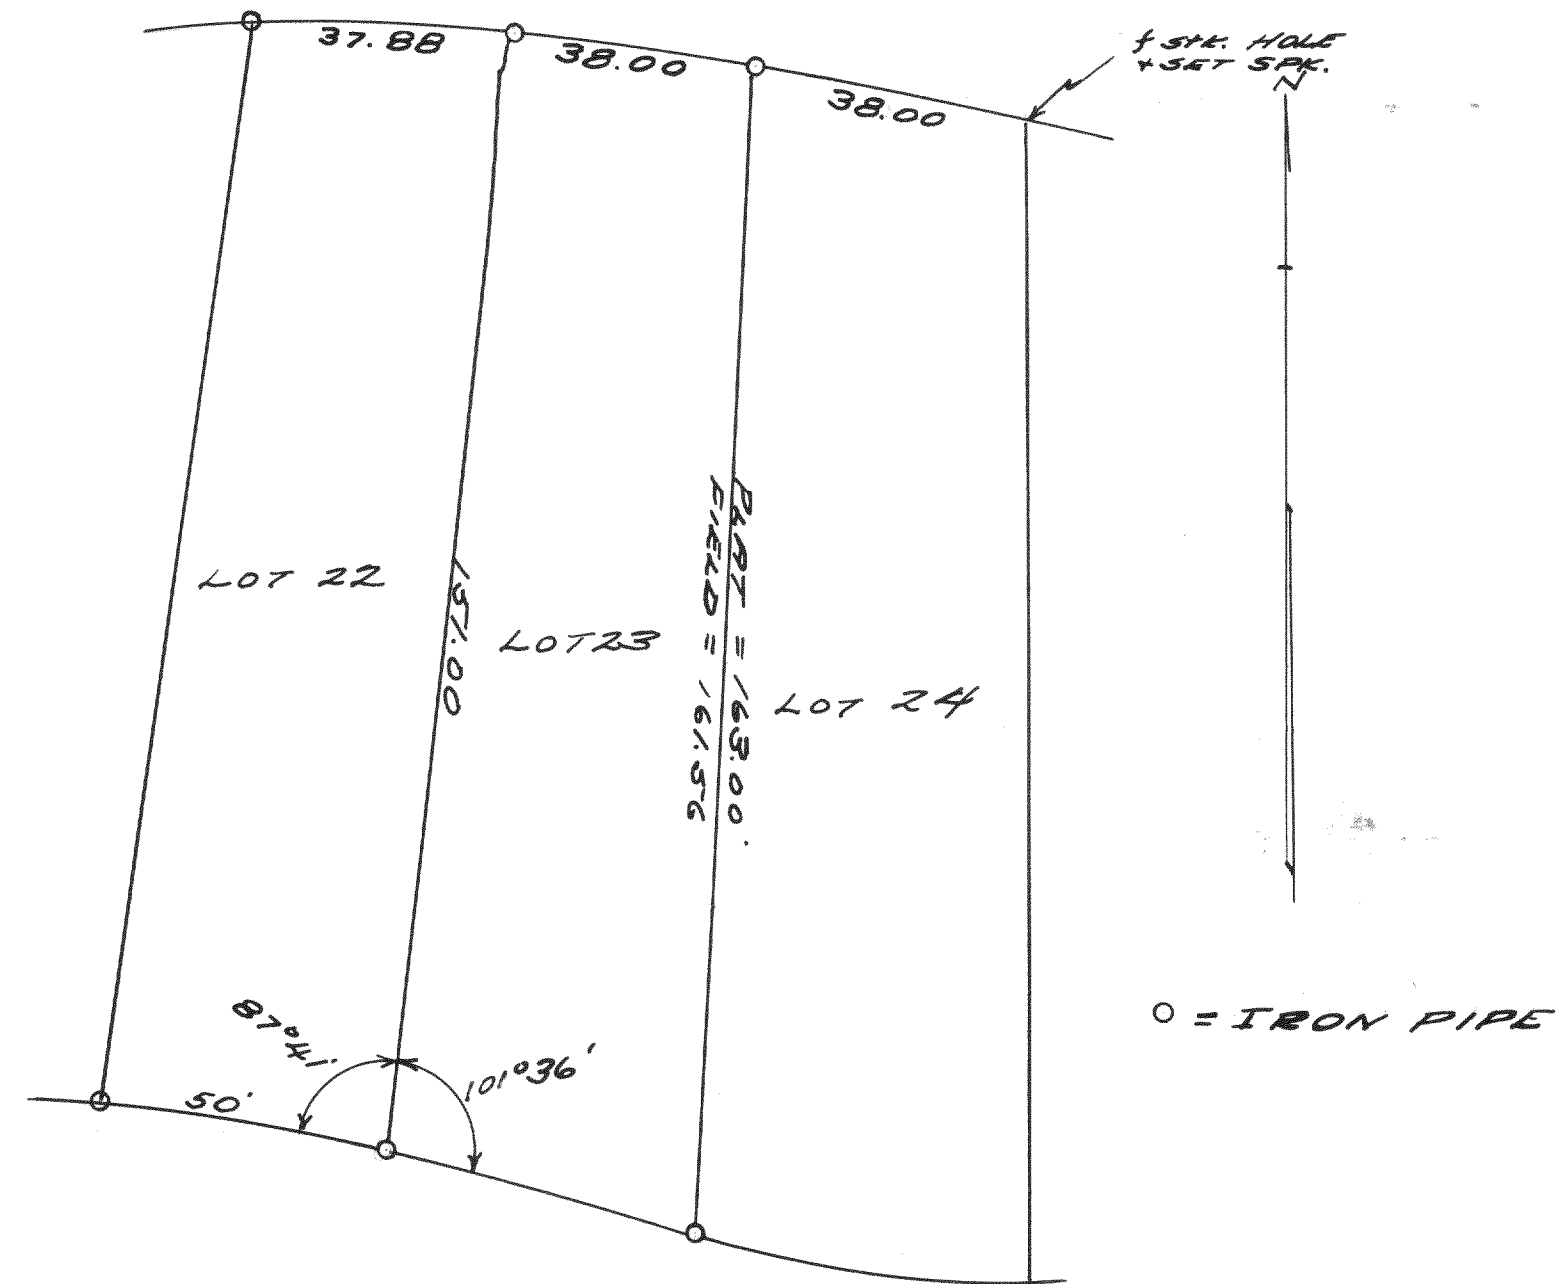

PLAT OF SURVEY OF LOT 23 OF BEUNA
VISTA PARK IN THE VILLAGE OF FONTANA
ON - GENEVA LAKE, WALWORTH CO., WISC.
NOV. 15, 1941

Lloyd L. Jensen
N.E.J.

SURVEY NO. 1260

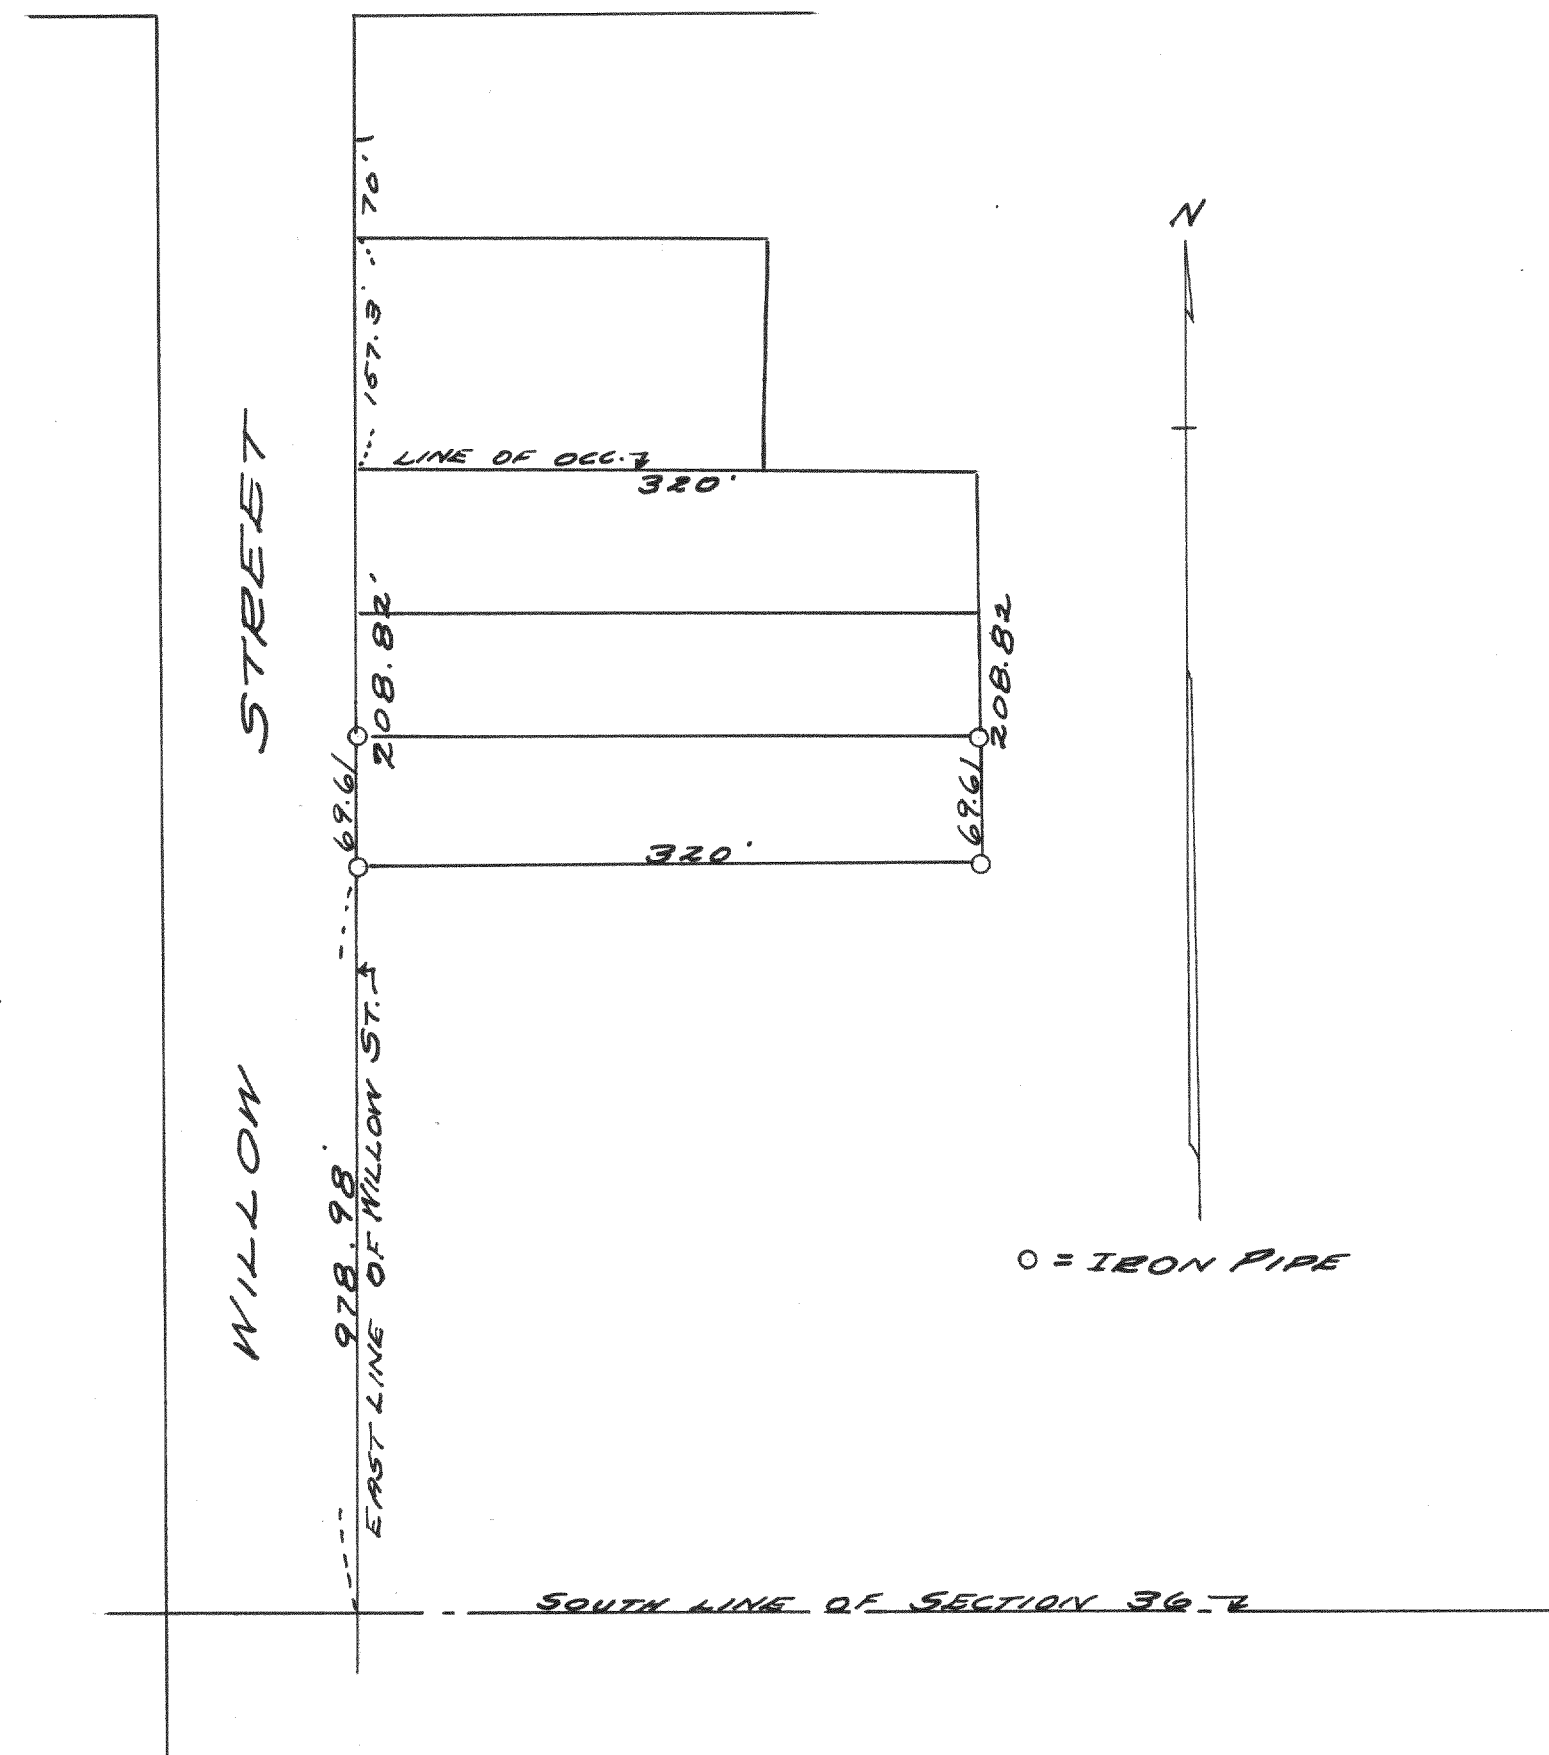

PLAT OF SUEVEY OF LAND LOCATED IN THE
SE $\frac{1}{4}$ OF SECTION 36 T2N R1E OF WALWORTH
COUNTY, WISCONSIN
AUG. 19, 1941

Lloyd L Jensen
K.E.J.