



#2034

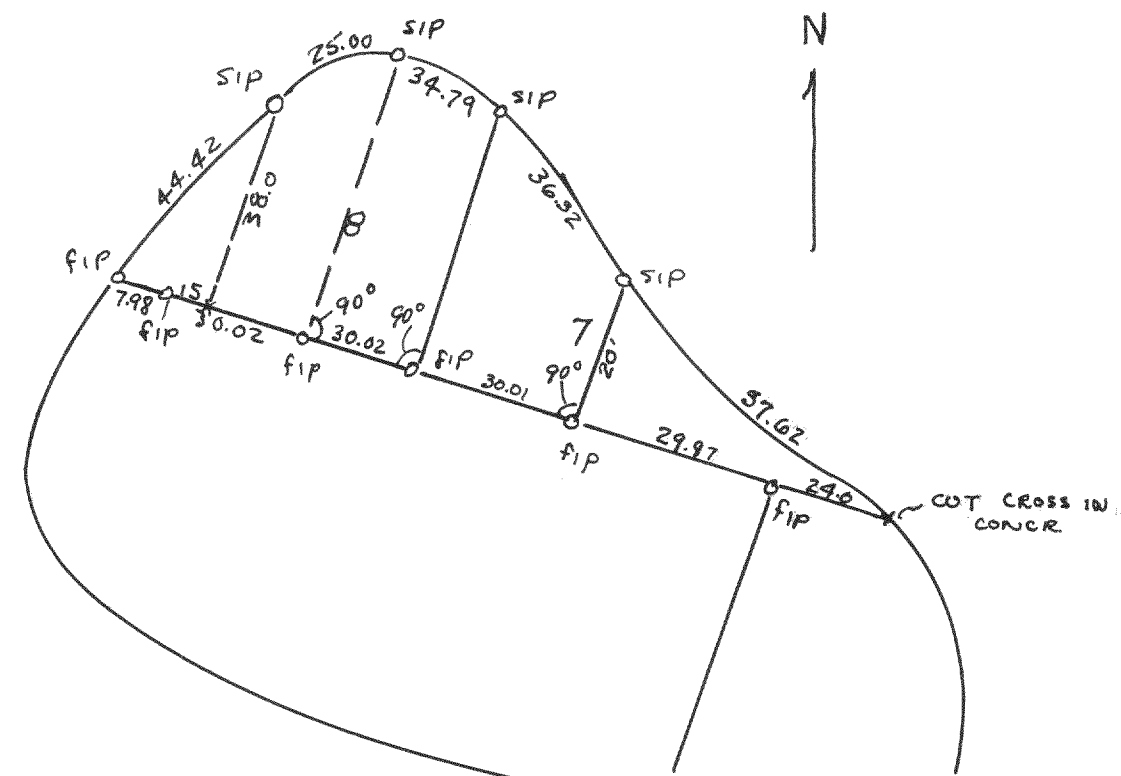

Plat of survey of Lots 7 & 8 Block L of Delavan Lake
Assembly grounds located in SW 1/4 Sec 21, T2N R16E
June 1949
Lloyd L. Jensen
County Surveyor

#2035

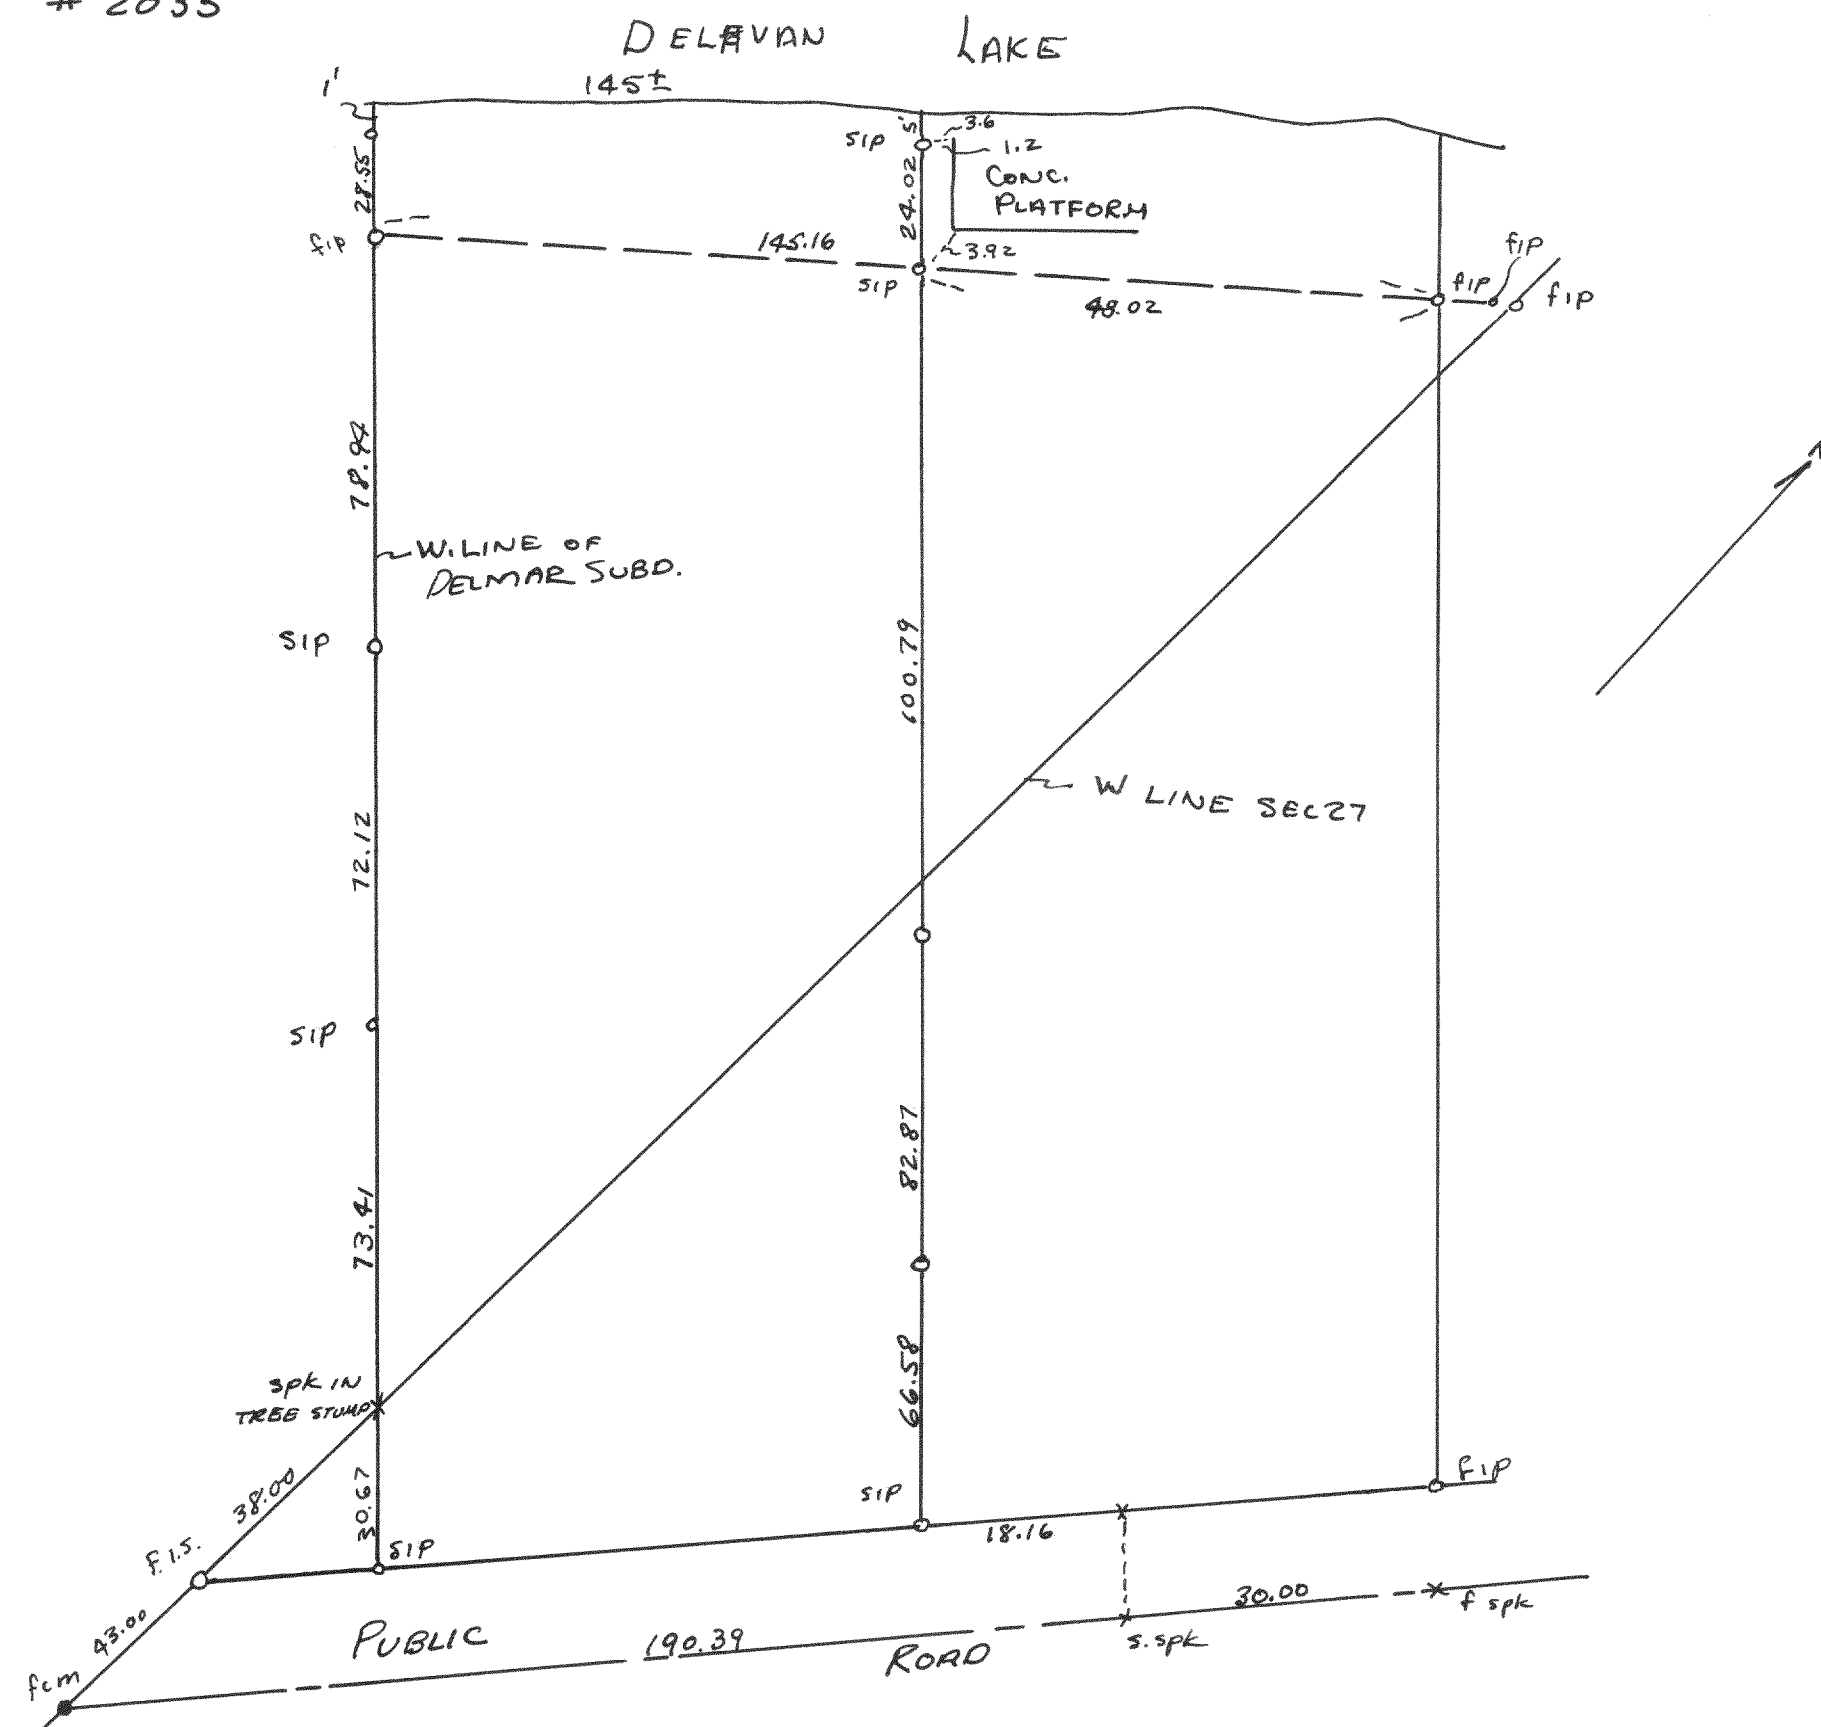

Plat of survey of Park area of Delmar Subdivision located in Section
27 and 28, T2N R16E
July 11, 1949

Lloyd L. Jensen
County Surveyor