



#2037

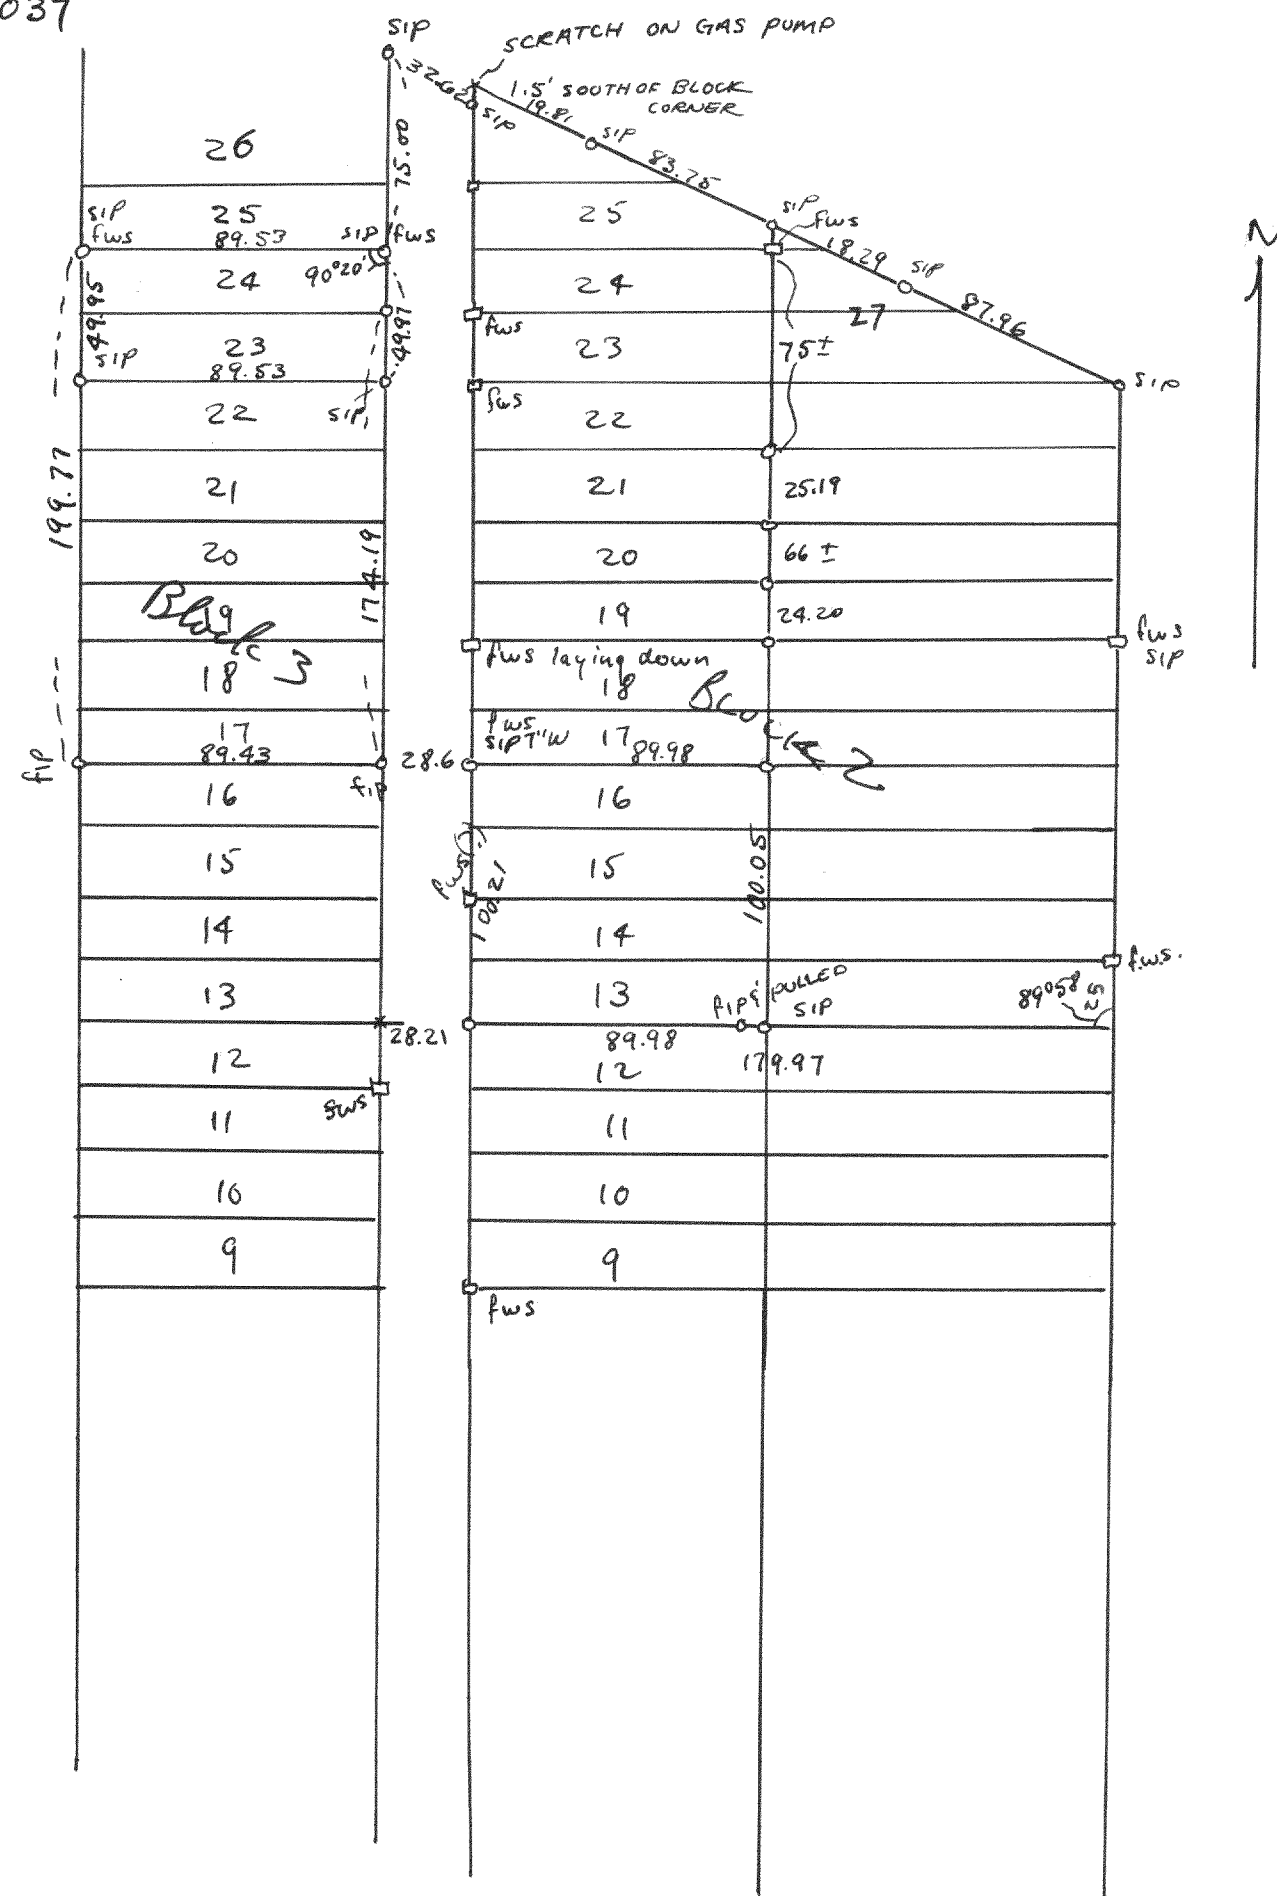

Plat of survey of lots 23 & 24 Block 3 & lots 13-16
Block 2 & north line of lots 25, 26 & 27 Block 2 of Robbins
Subd. located in Sec 32, T2N R16E
1949

Harold L. Jensen
County Surveyor

#2038

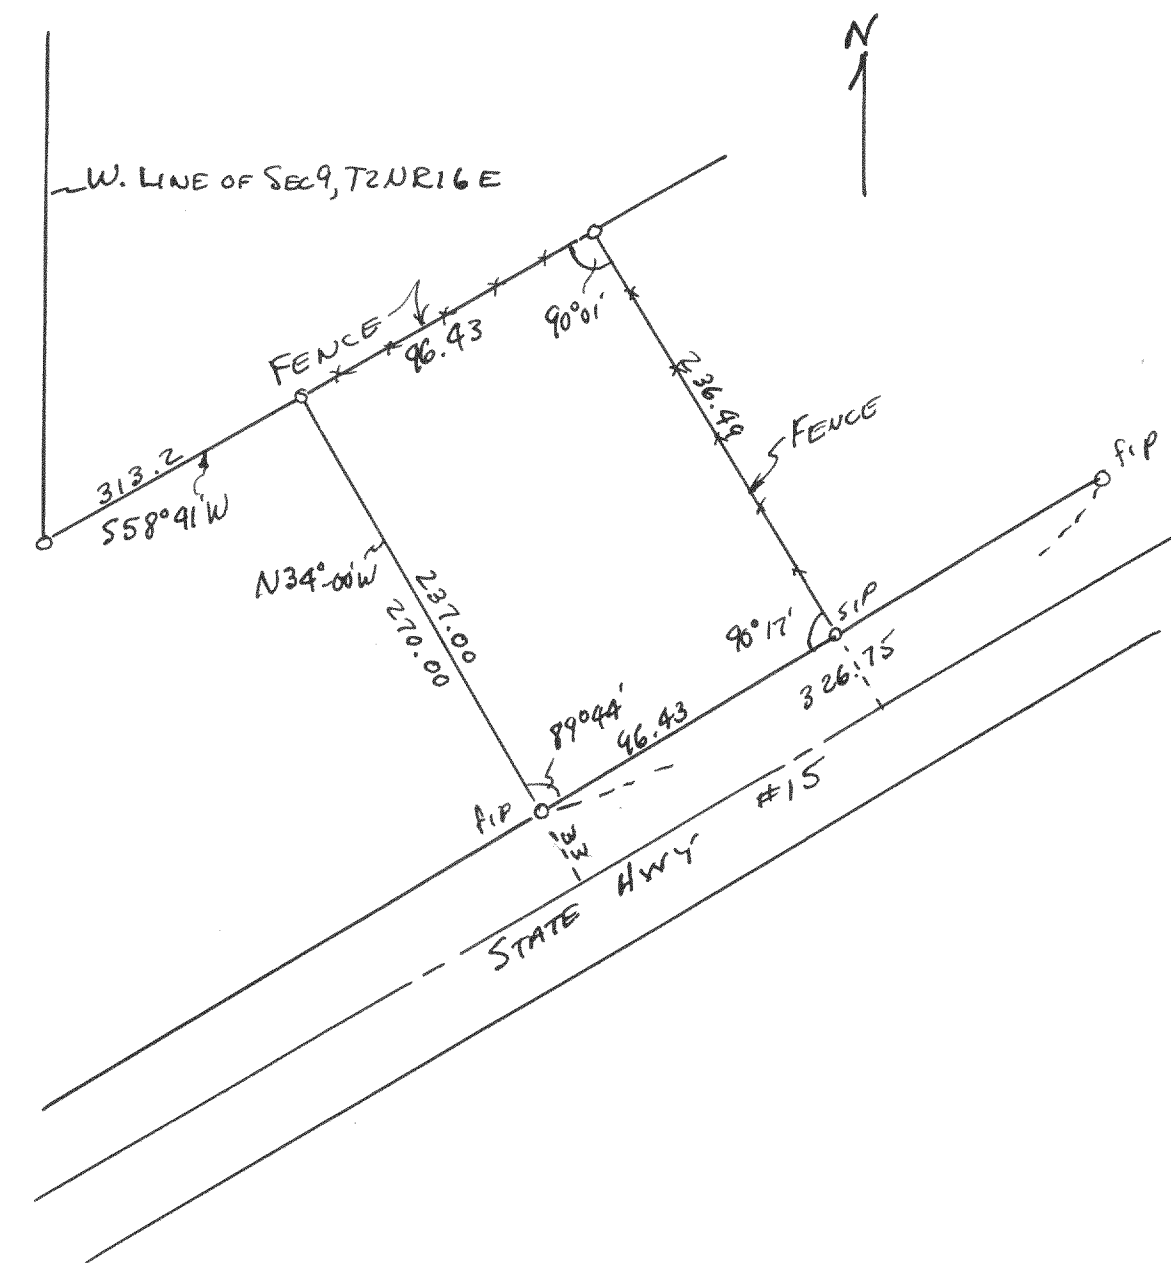

Plat of survey of parcel of land located in the W 1/2 of
Section 9 T2N R16E
Aug 17, 1949

Harold L. Jensen
County Surveyor