



424

2041

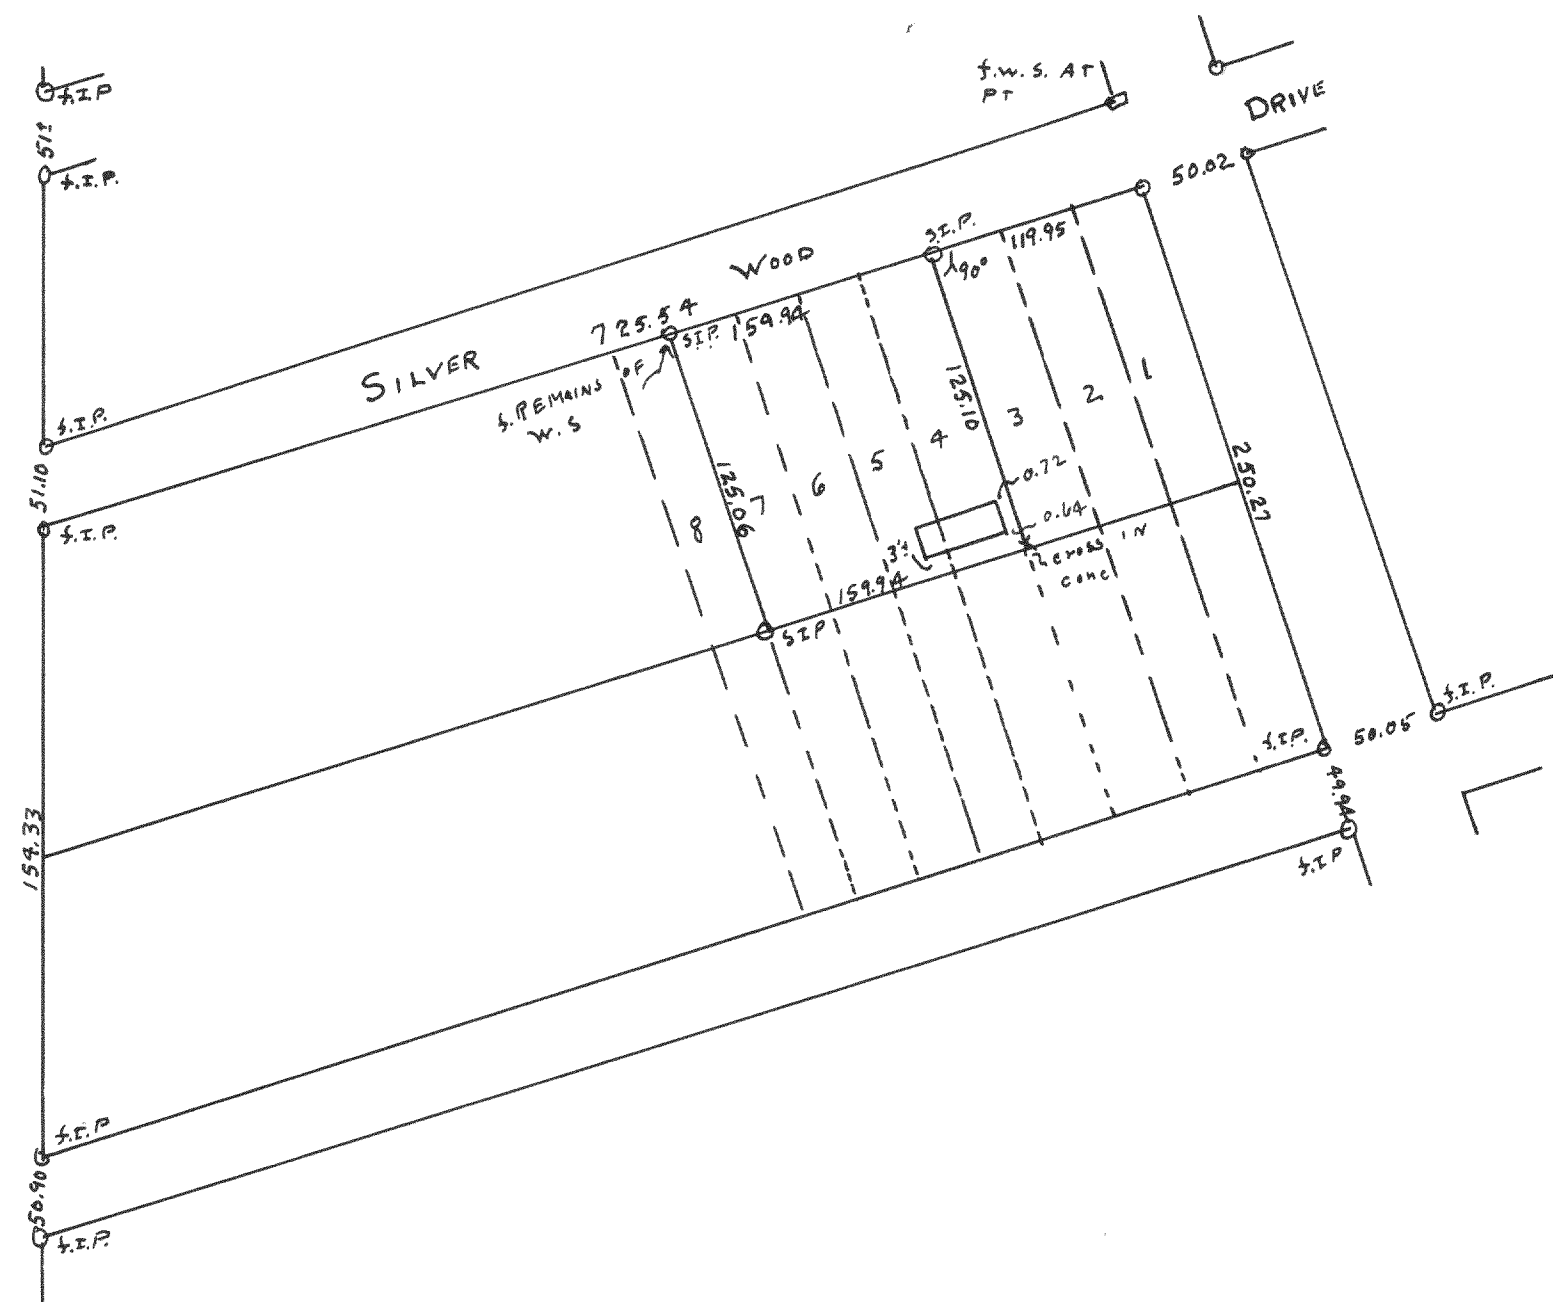

Plat of survey of lots 4-7 Block 15 of Delavan
Lake View Crest Subdivision located in Sec 31, T2N R16E
Lloyd S. Jensen
County Surveyor
Oct 17, 1949

2042

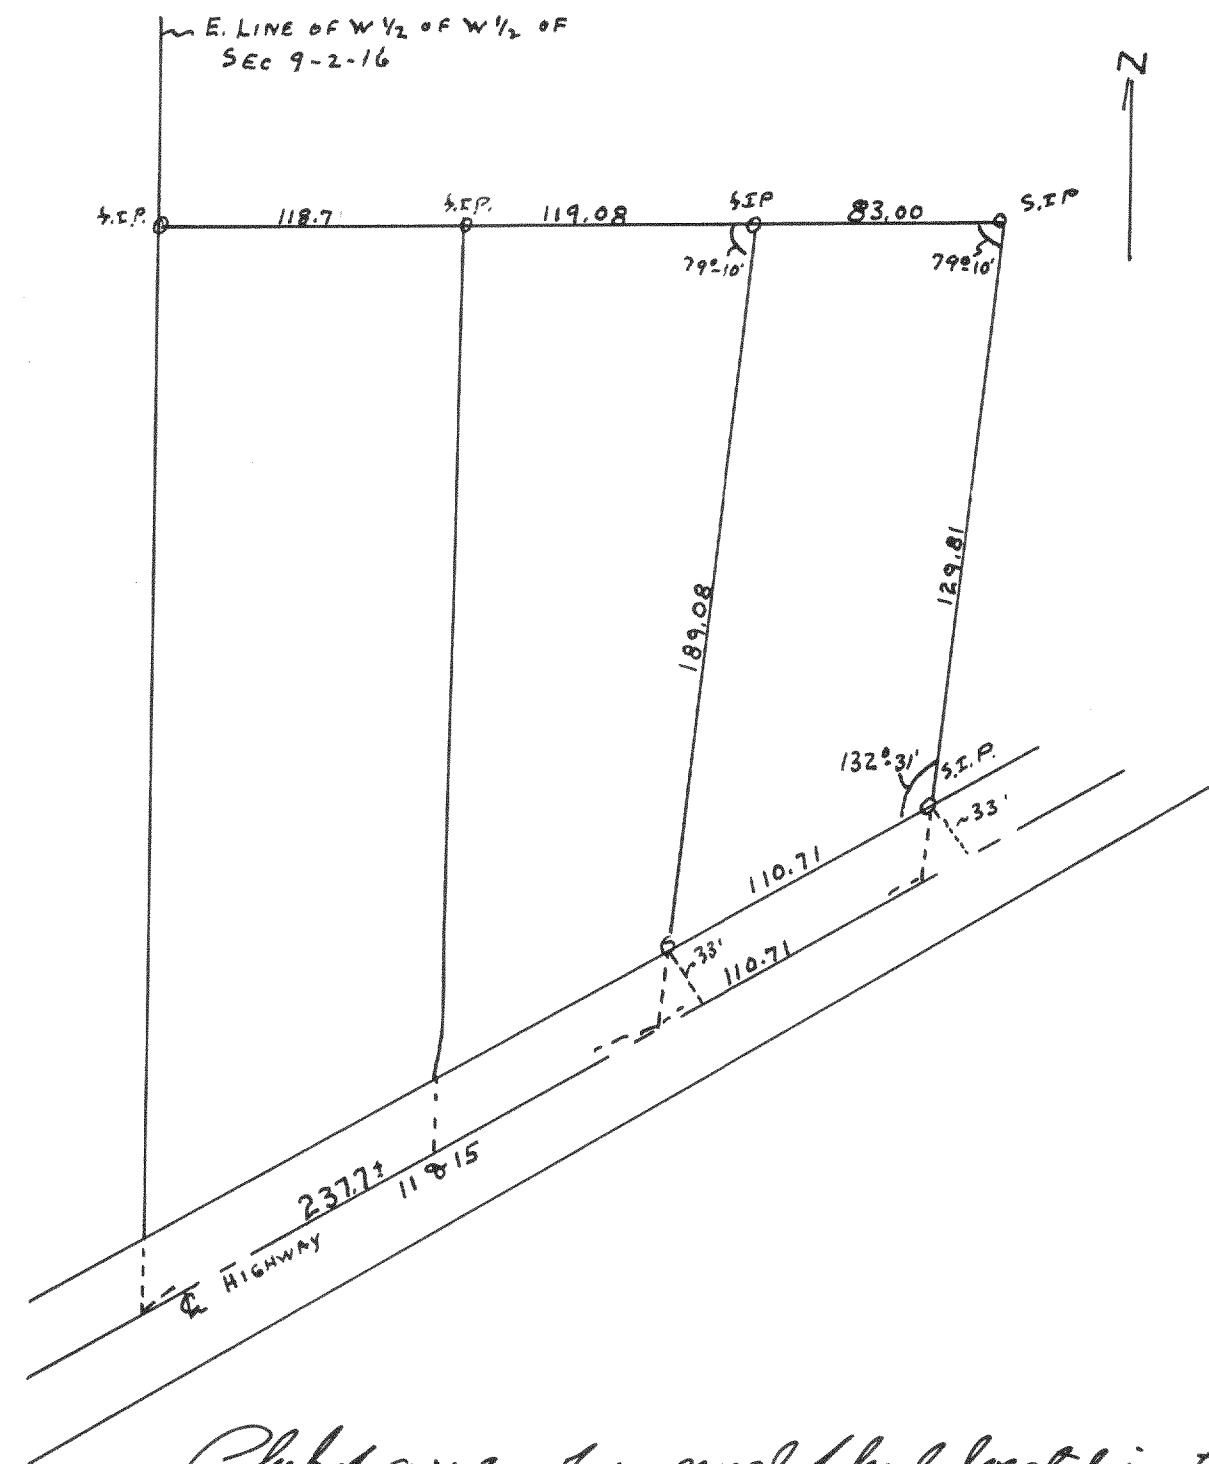

Plat of survey of a parcel of land located in the
E 1/2 of the W 1/2 of Sec 9, T2N R16E
Lloyd S. Jensen
County Surveyor
Oct 18, 1949