



2046

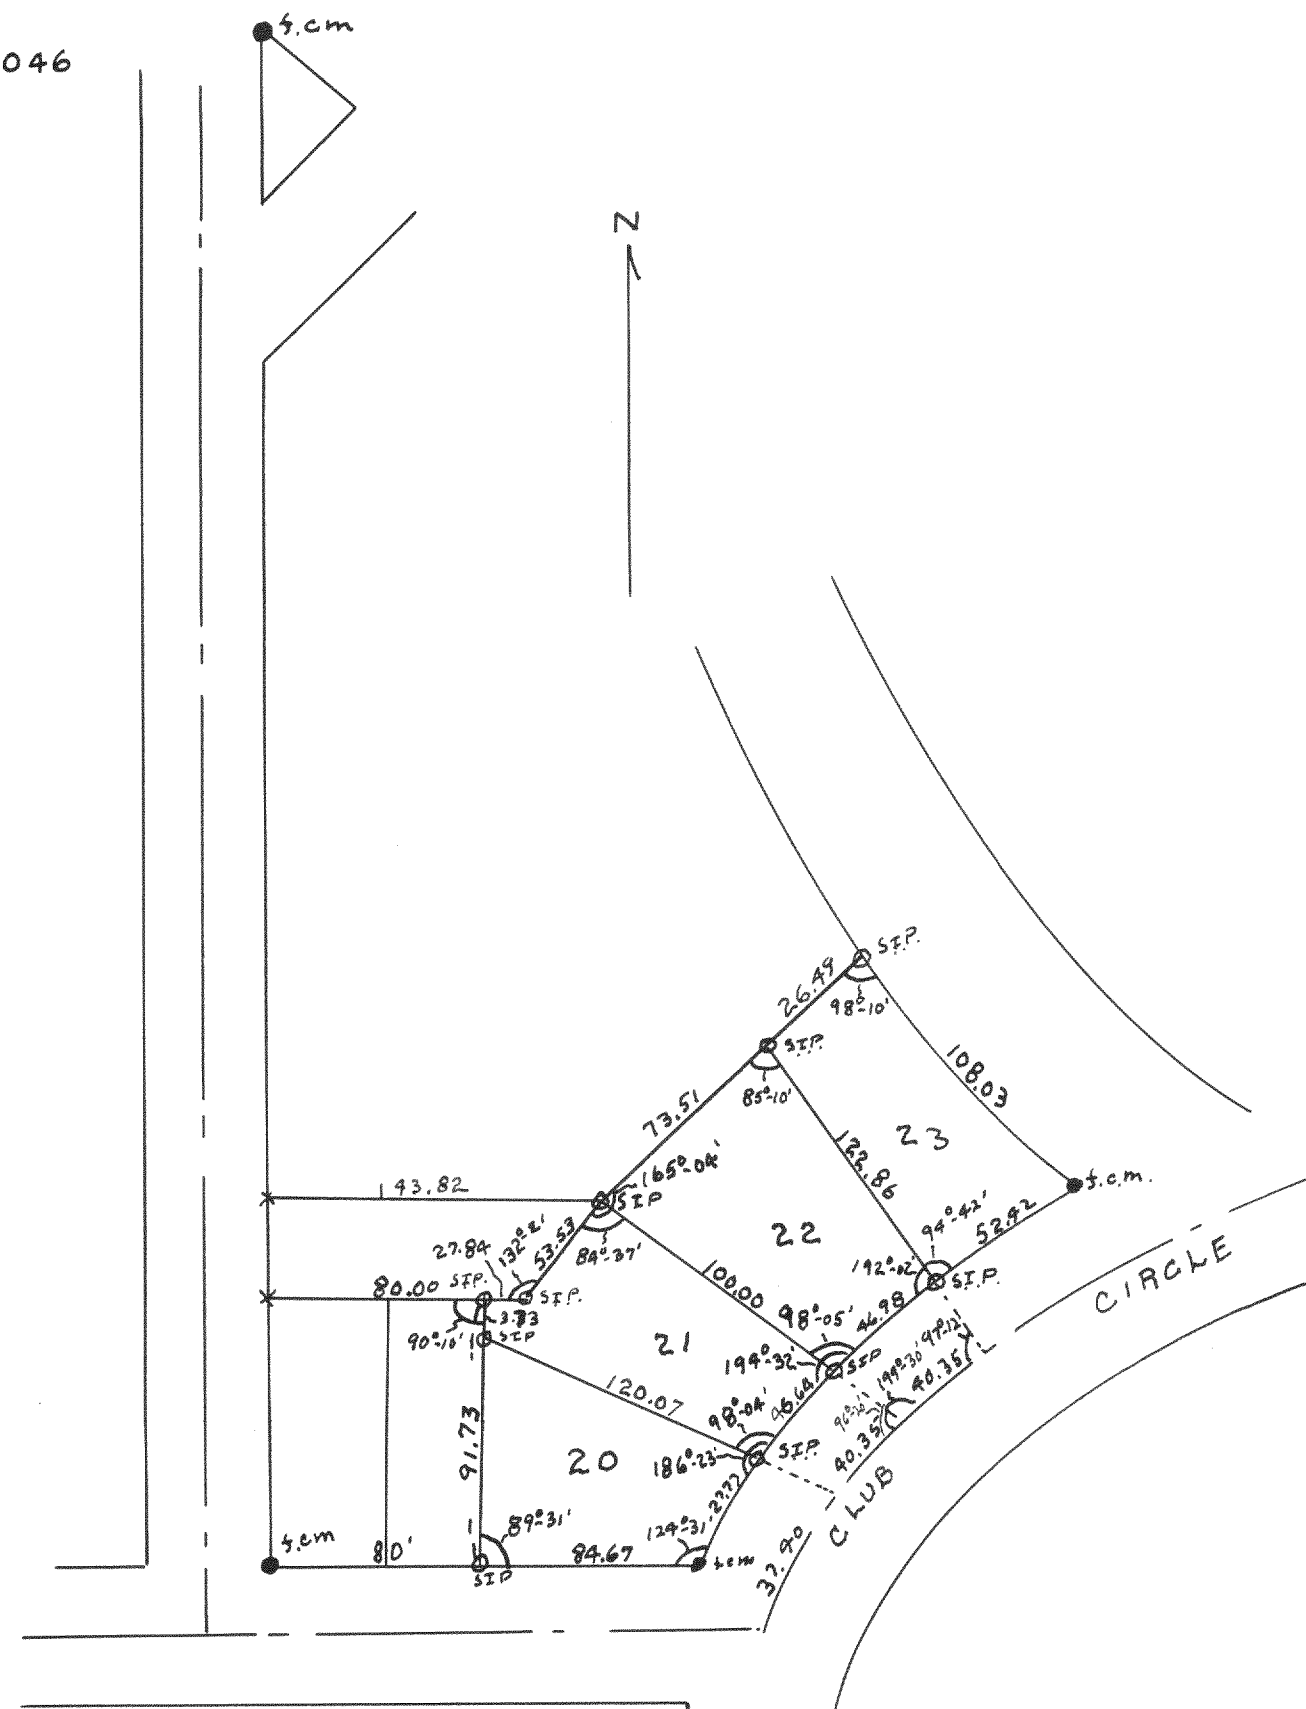

Plot of survey of lots 20-21-22-23 of Block 39 of Interlaken Subdivision located in Section 11, T3N R16E Malheur County
April 26, 1999

Lloyd E Jensen *L.E.J.*
County Surveyor

2047

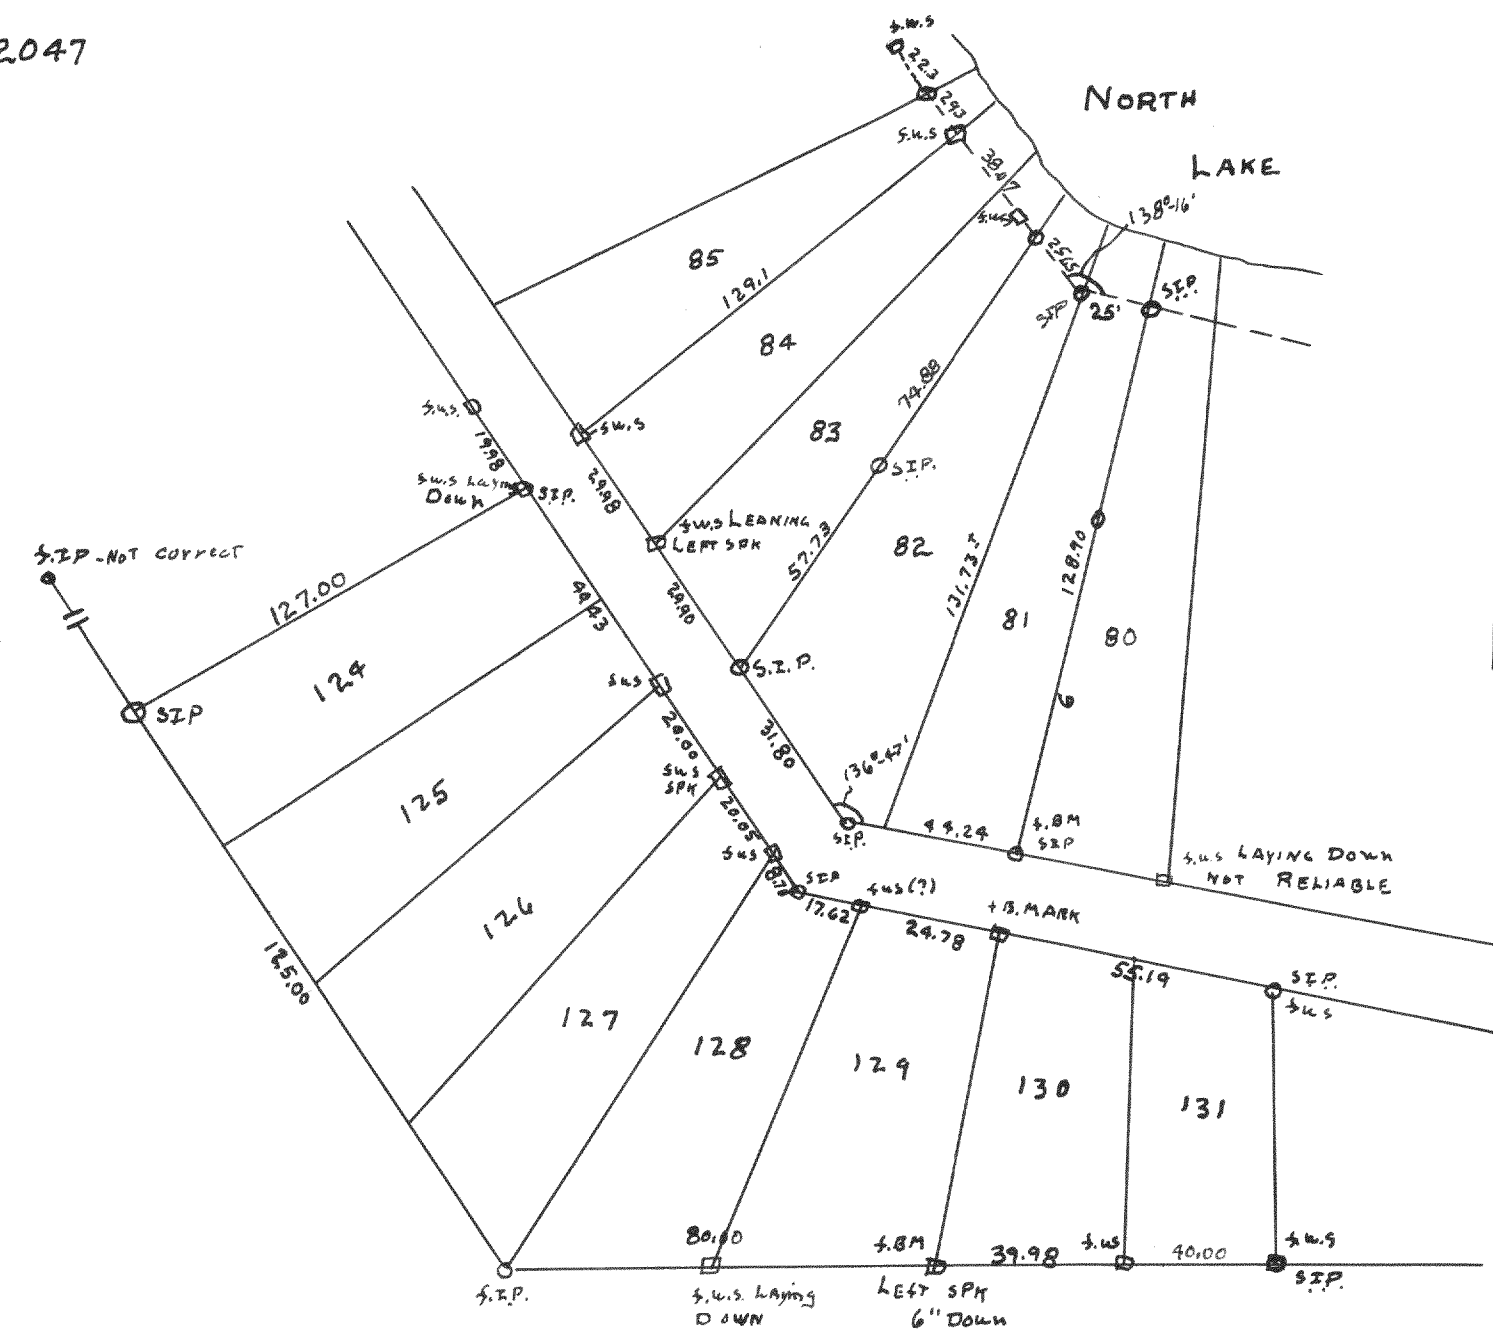

Plot of survey of lots 124-131 of Block A
North Lake Beach Subdivision located in Section 8 T3N R16E
Sept 10, 1999

Lloyd E Jensen *L.E.J.*
County Surveyor