



2048

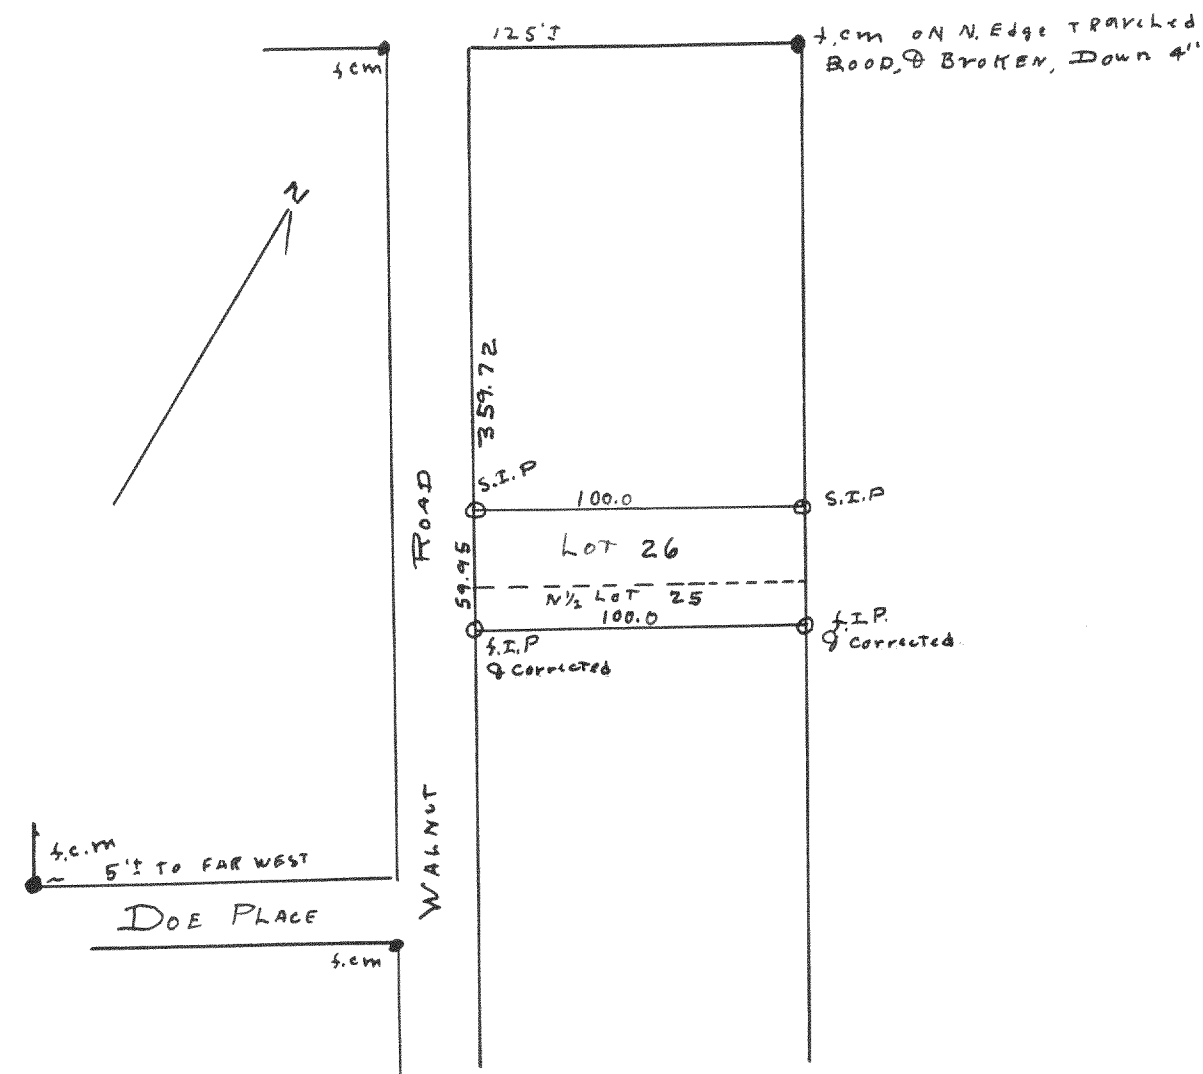


Plot of survey of $N\frac{1}{2}$ Lot 25 & Lot 26 of Block 63 Antelope
subdivision located in Section 11 T3N R16E Malworth County
Sept 20, 1949
Lloyd L Jensen *sd*
County Surveyor

2050

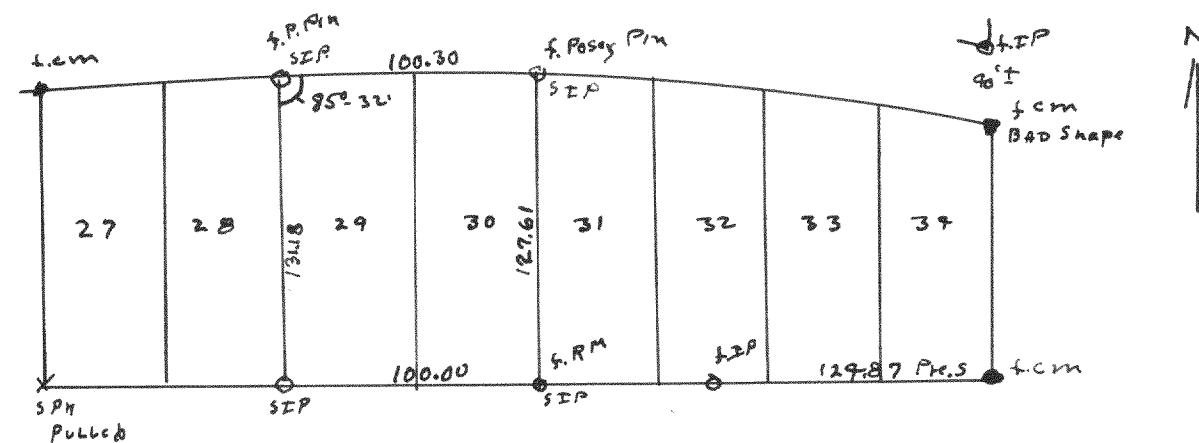

Plot of survey of lots 29 & 30 of Block 7 Mandanaya Highlands
located in Sections 11 & 12 T3N R16E
Oct 31, 1949
Lloyd L Jensen *sd*
County Surveyor

2049

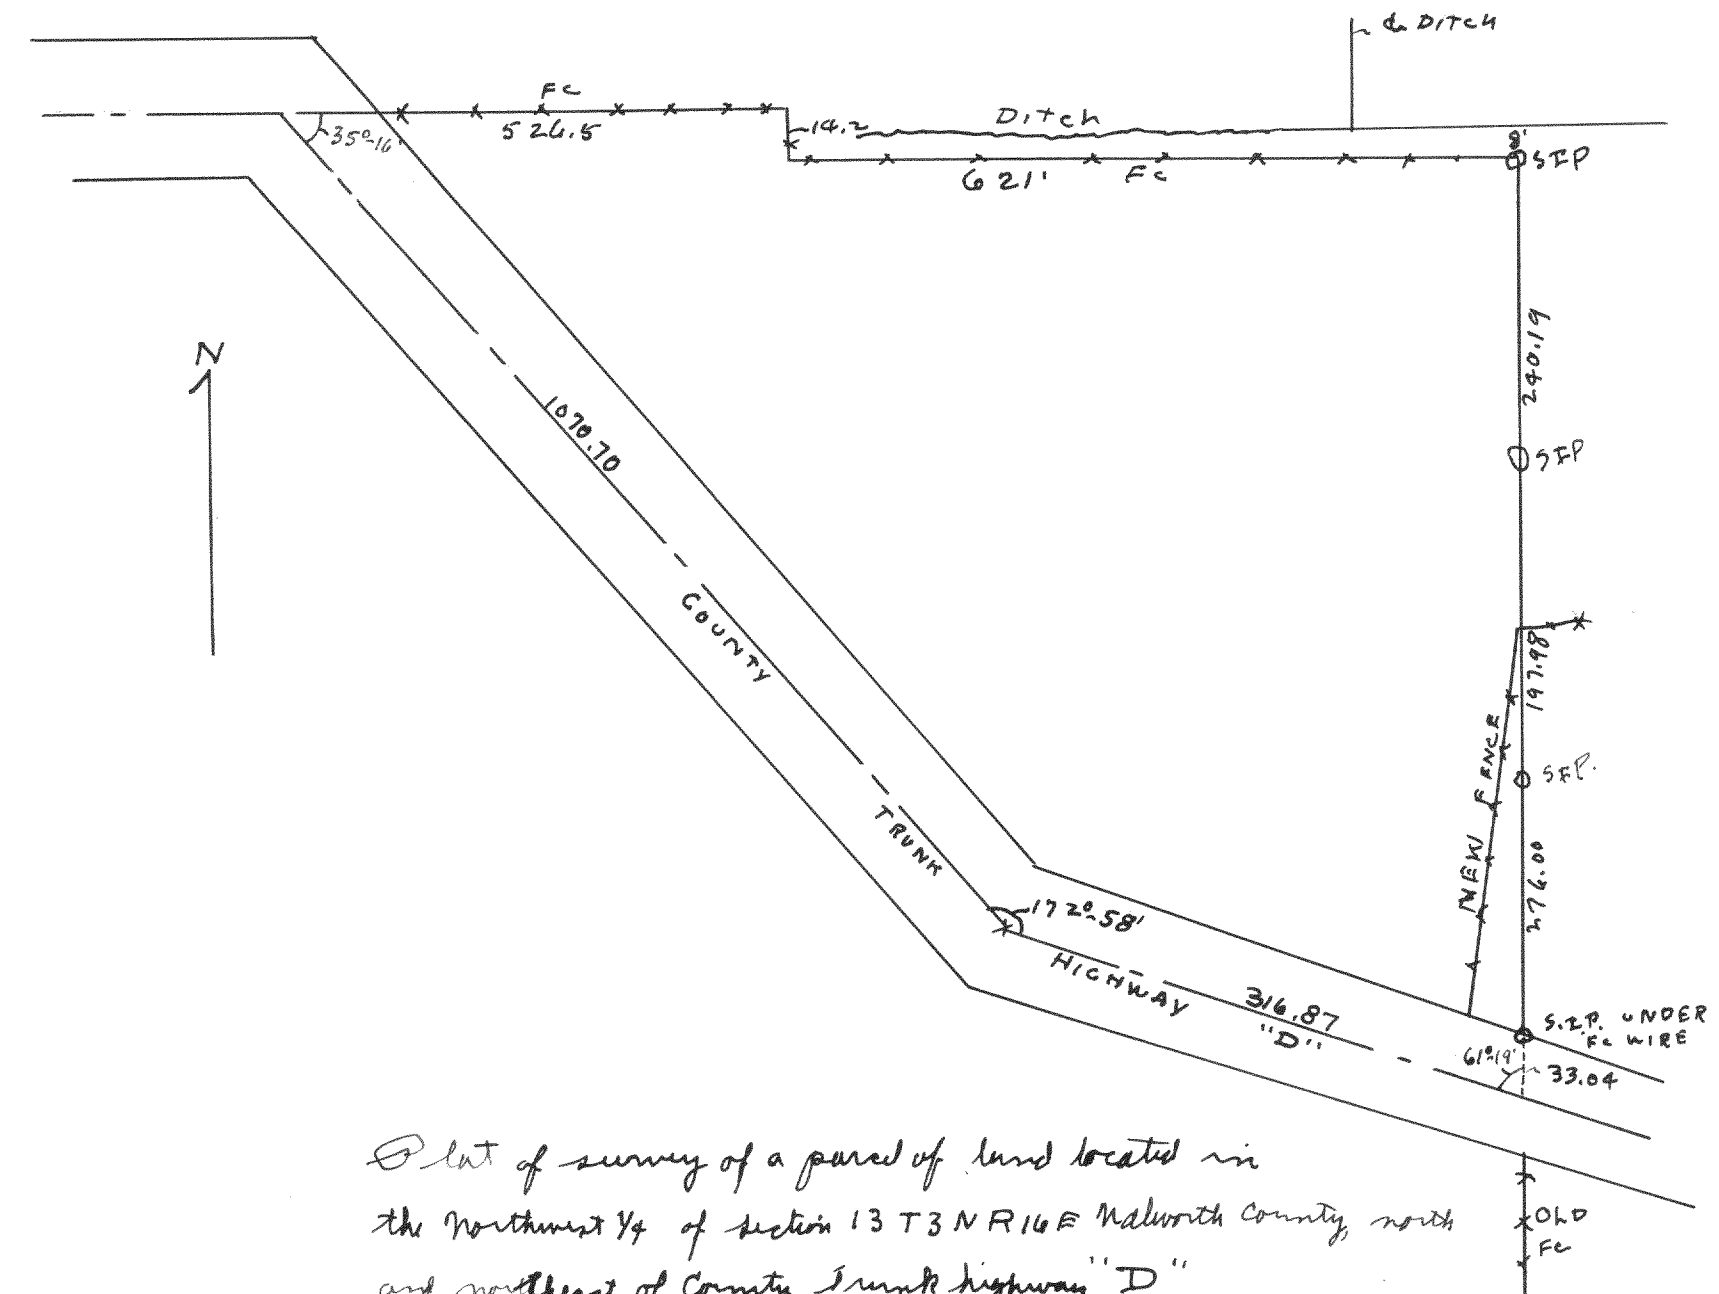

Plot of survey of a parcel of land located in
the Northwest 1/4 of Section 13 T3N R16E Malworth County north
and northeast of County Trunk Highway "D"
Sept 27, 1949
Lloyd L Jensen *sd*
County Surveyor