



2051

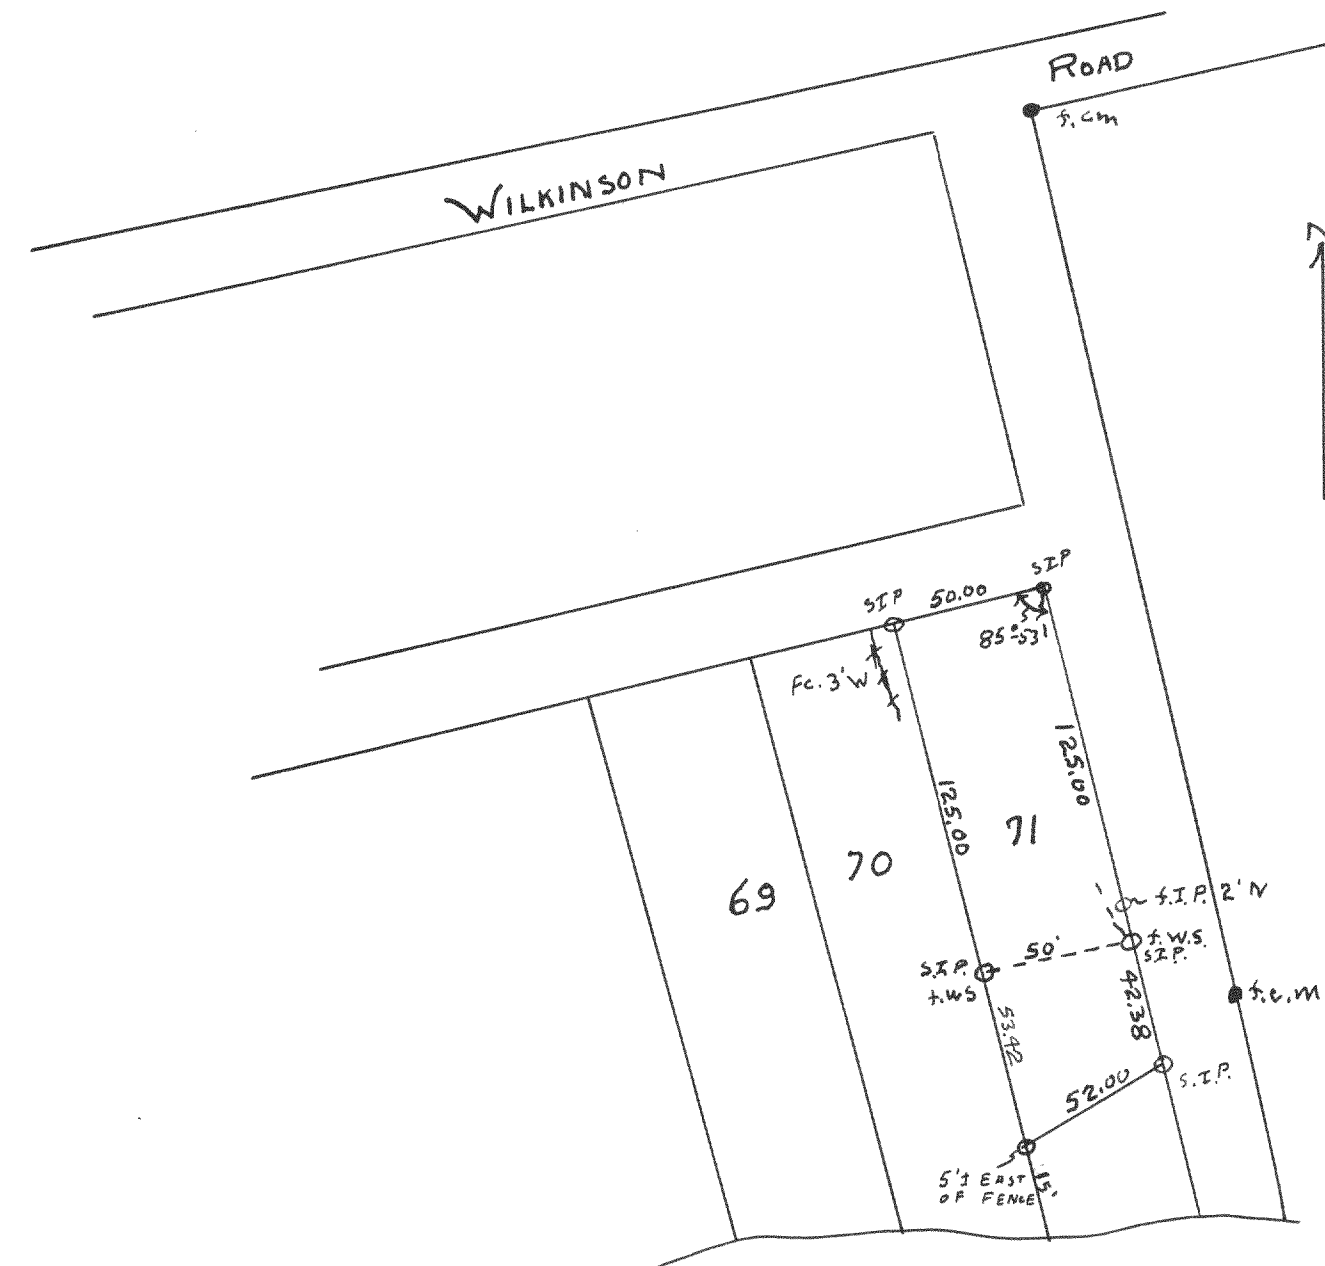

Plot of survey of lot # 71 Tangle Lake Heights located
in the SW 1/4 Section 34 T4N R16E Malheur County
April 20, 1949

Floyd L. Jensen
County Surveyor

2052

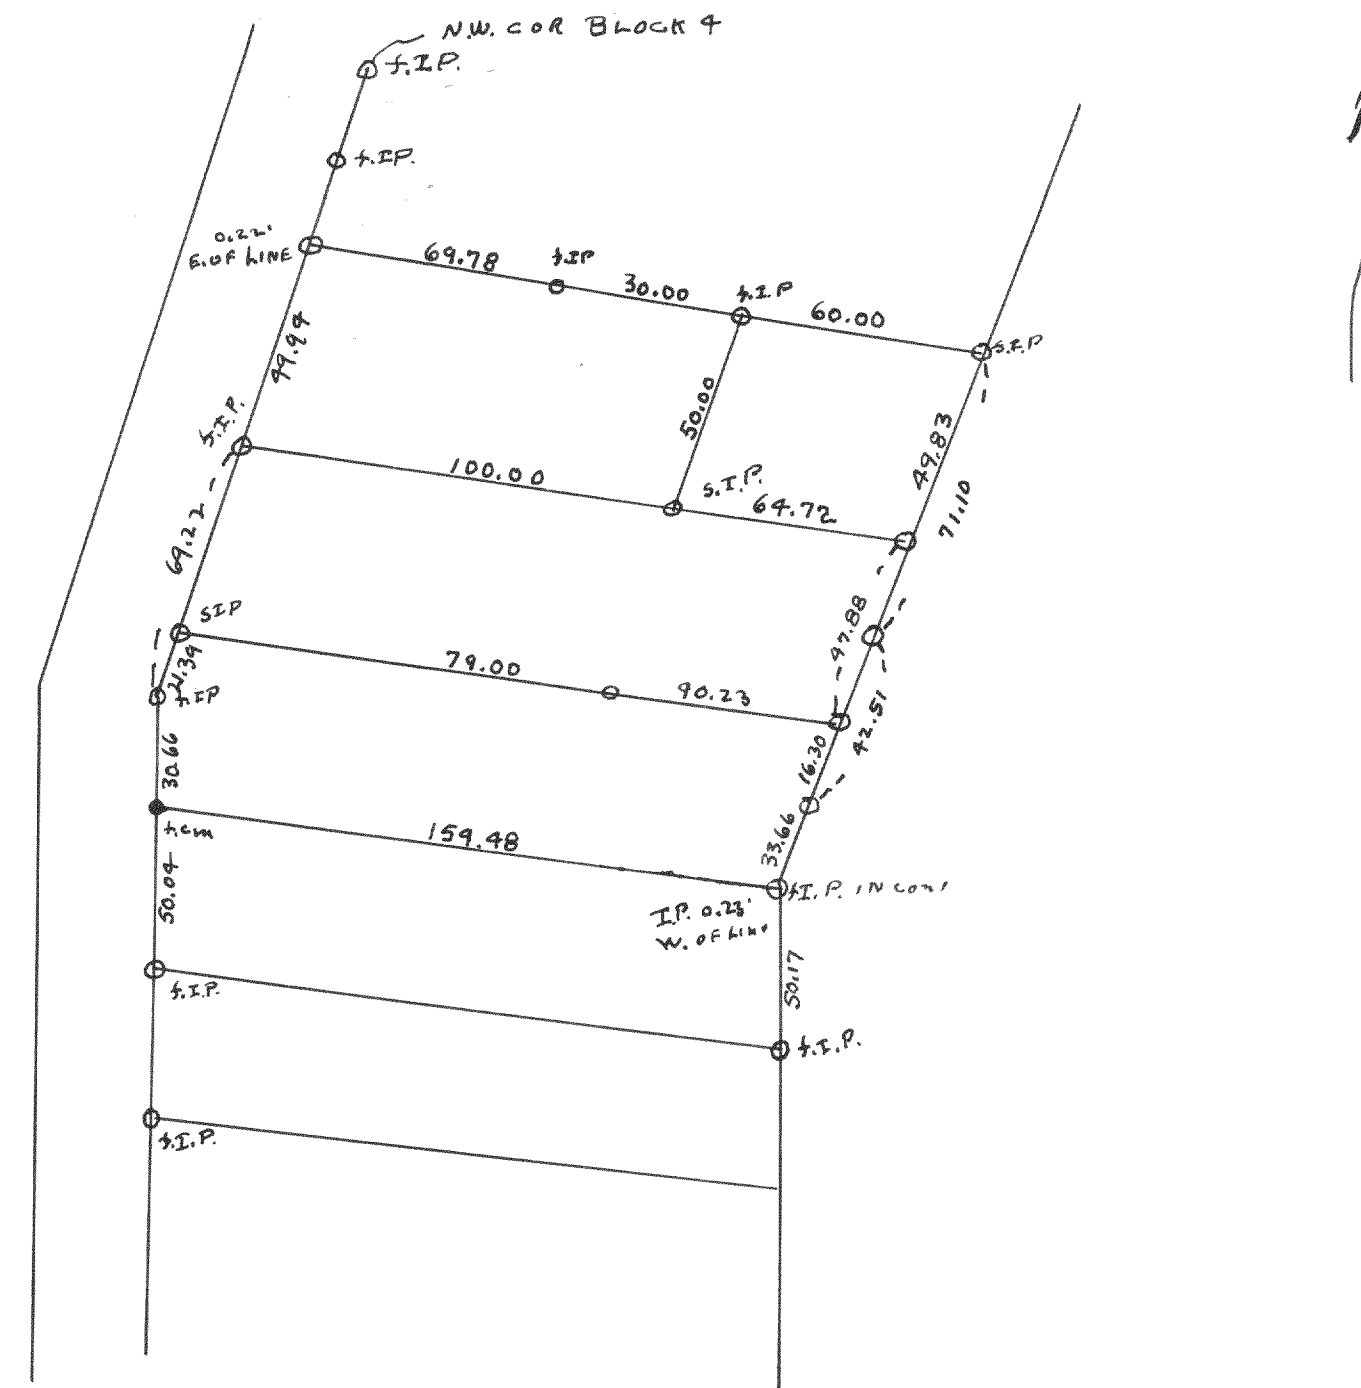

Plot of survey of a parcel of land located in Block 4 of Green Lake
Park Subdivision located in the SW 1/4 of Section 26 T4N R16E Malheur County
1949

Floyd L. Jensen et al
County Surveyor