


SURVEY NO. 1261

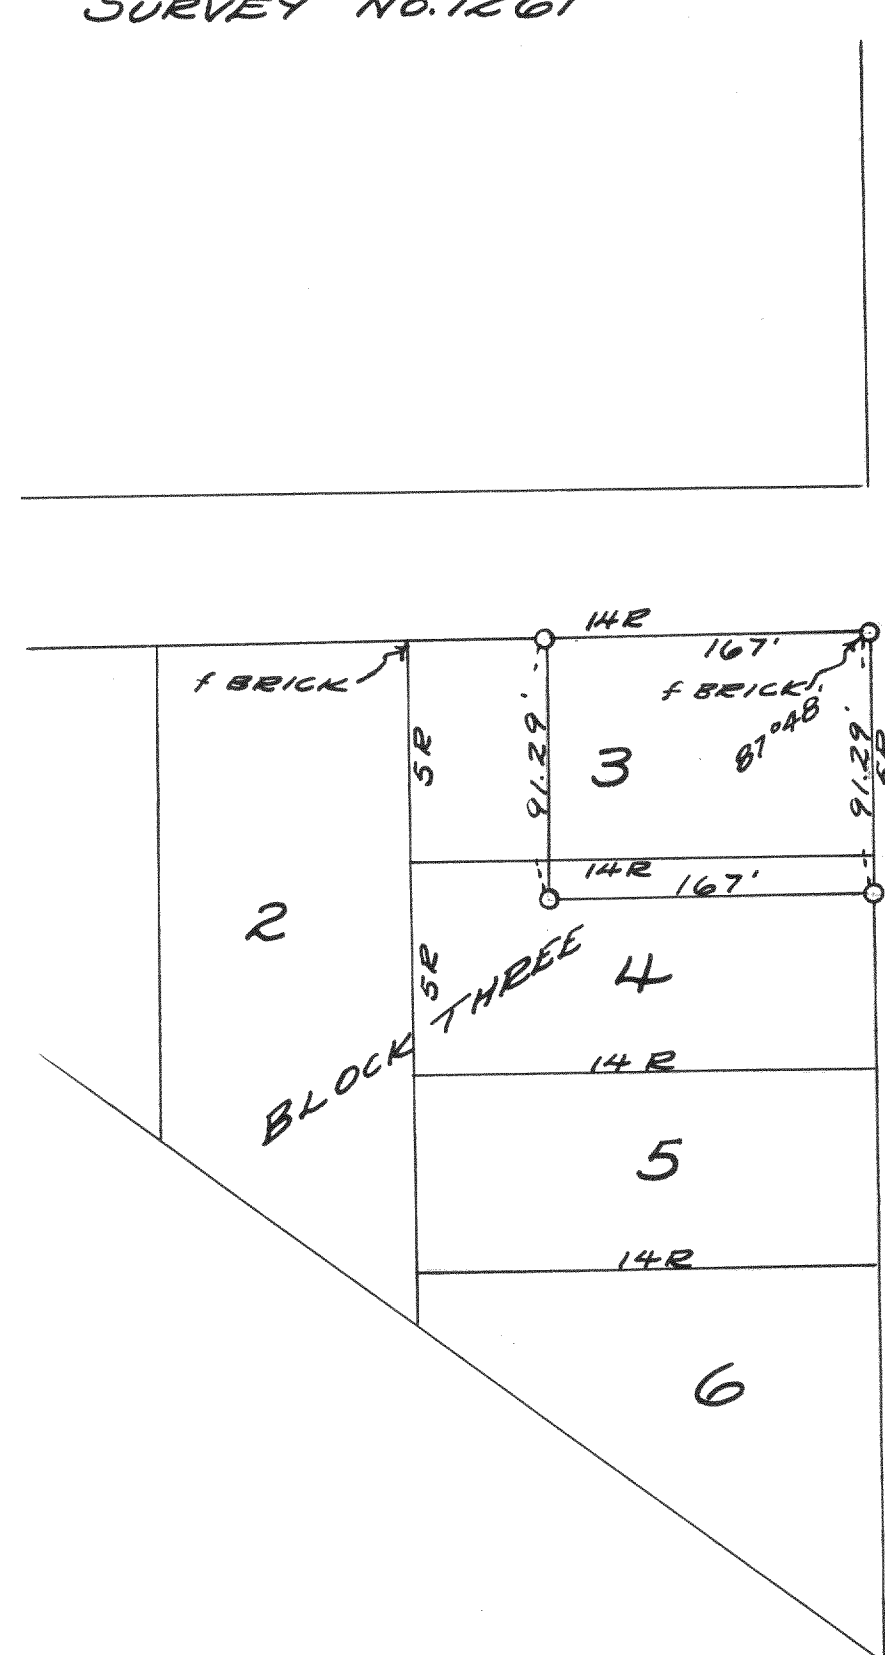


PLAT OF SURVEY OF LOTS 3 & 4 OF
BLOCK 3 OF HARD'S ADDITION TO
THE VILLAGE OF SHARON, WALWORTH
COUNTY, WISCONSIN.

OCT., 14, 1941

Lloyd L. Jensen
P.E.G.

SURVEY NO. 1262

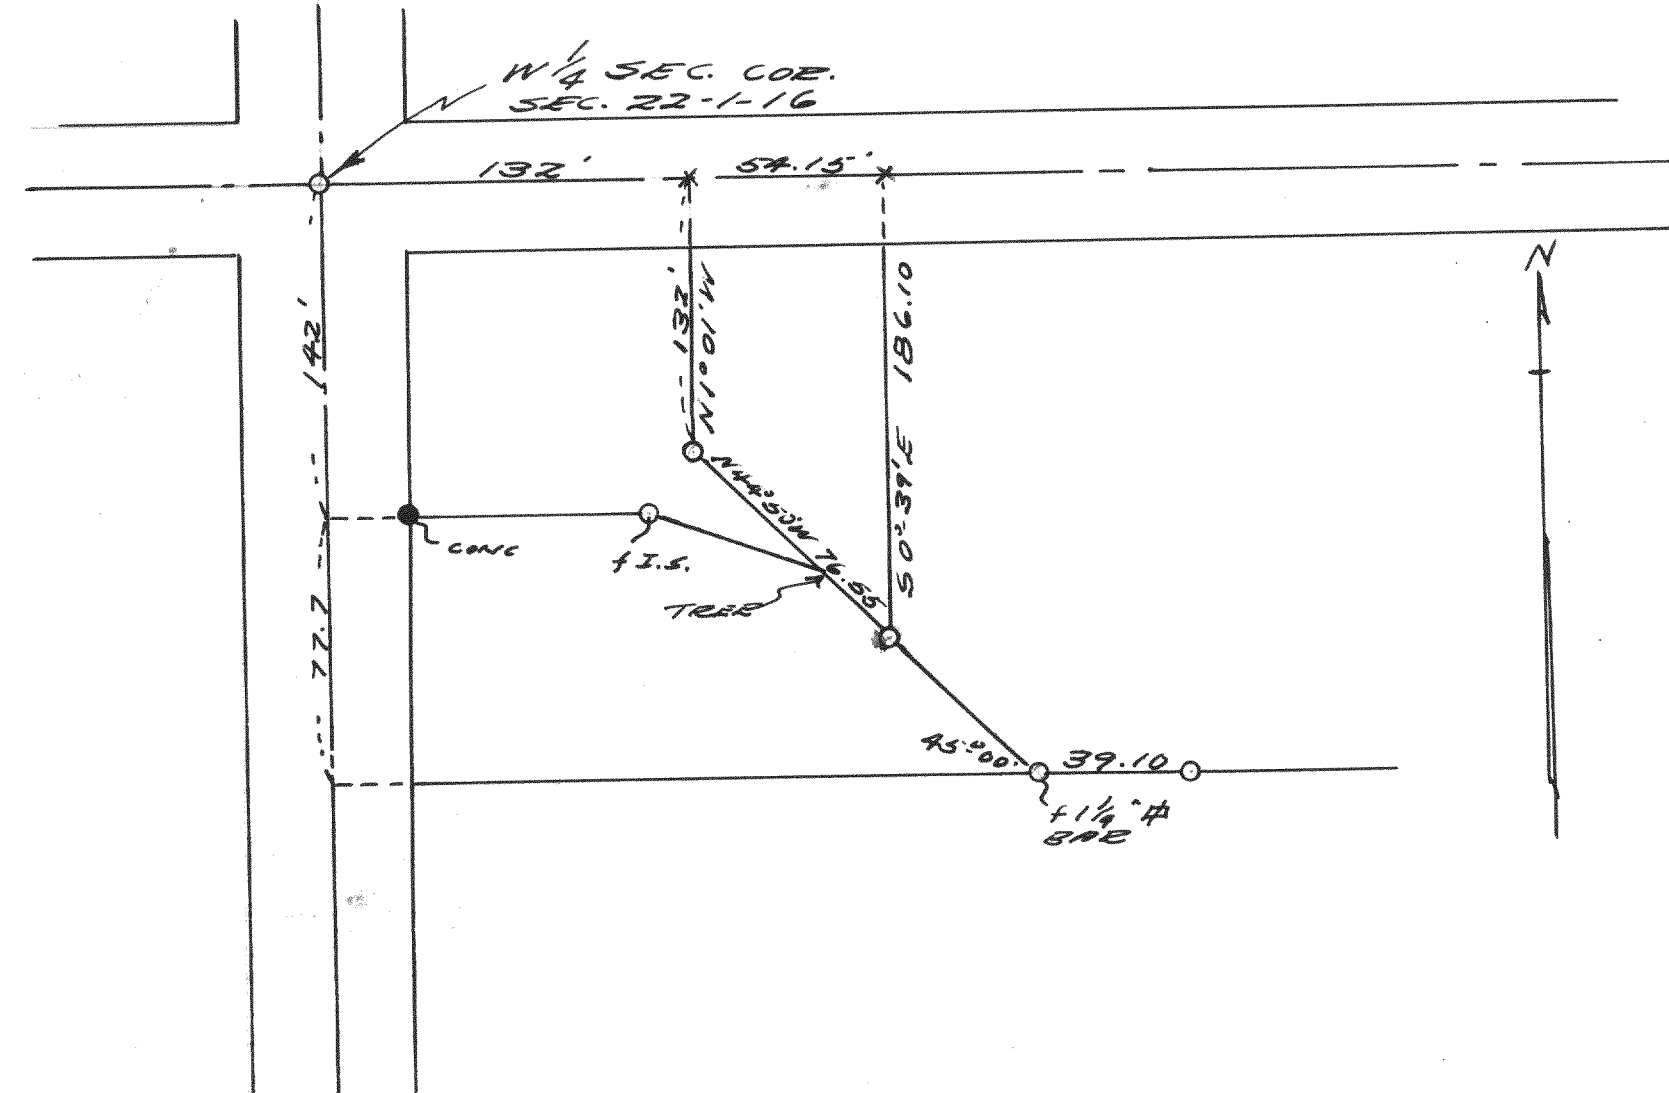

PLAT OF SURVEY OF PART OF THE SW $\frac{1}{4}$
OF SECTION 22 T1N R16E IN THE VILLAGE
OF WALWORTH, WALWORTH COUNTY, WISCONSIN.

FEB. 17, 1941

Lloyd L. Jensen
P.E.G.