



436

#2069

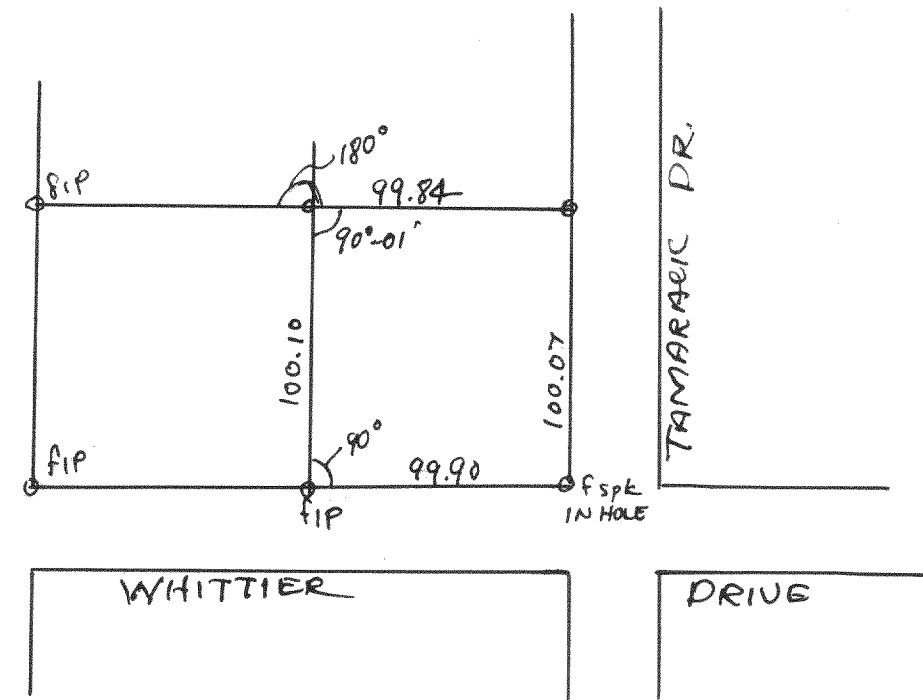


Plat of survey of lots 10388-92 Lake Long Beach Subd.
located in Sec. 21 & 22, T2N R17E, Walworth County, Wis.
Aug 18, 1949
Lloyd L. Jensen
County Surveyor

#2071

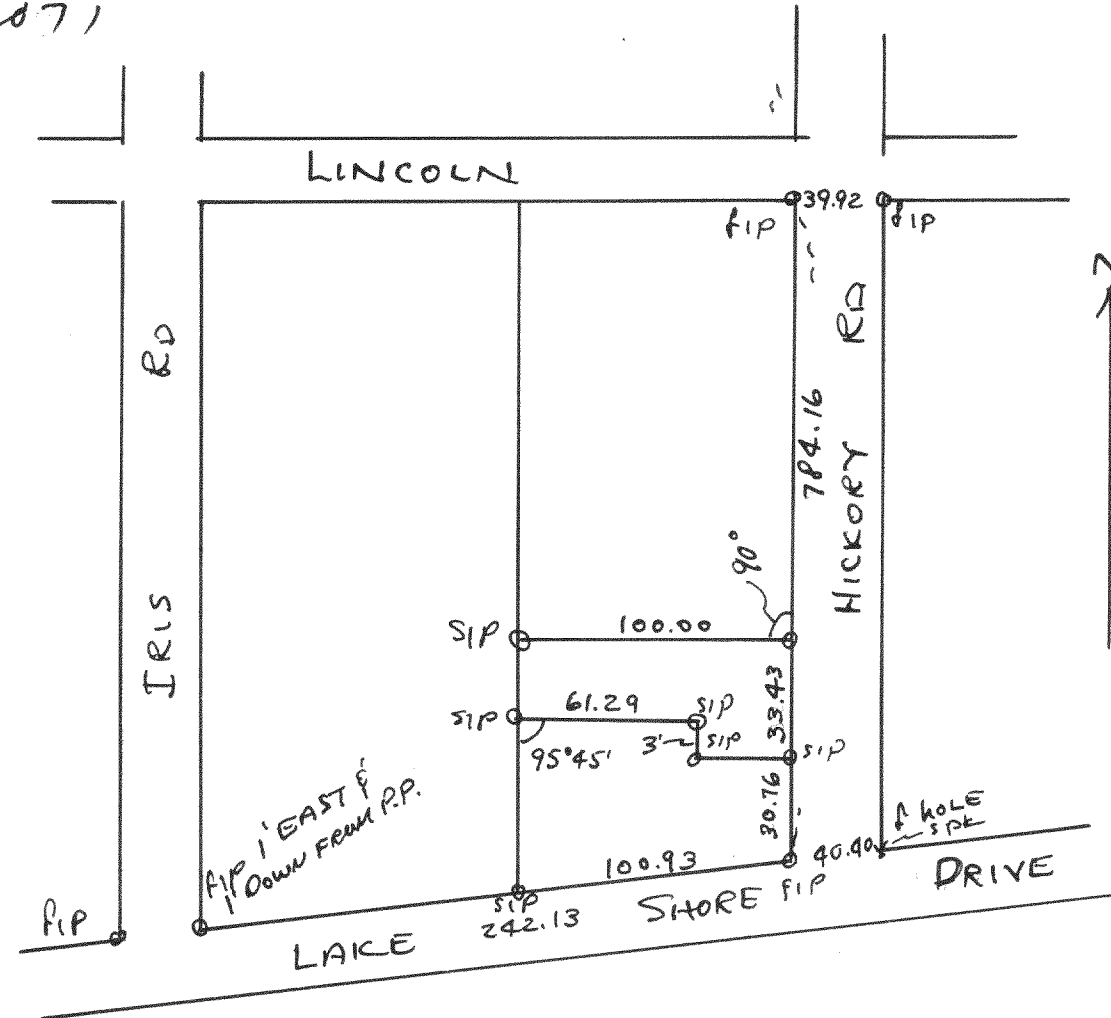

Plat of survey of lots 6013-6017 Lake Long Beach Subd.
located in Sec. 21 & 22, T2N R17E, Walworth Co., Wis.
Aug 27, 1949
Lloyd L. Jensen
County Surveyor

#2070

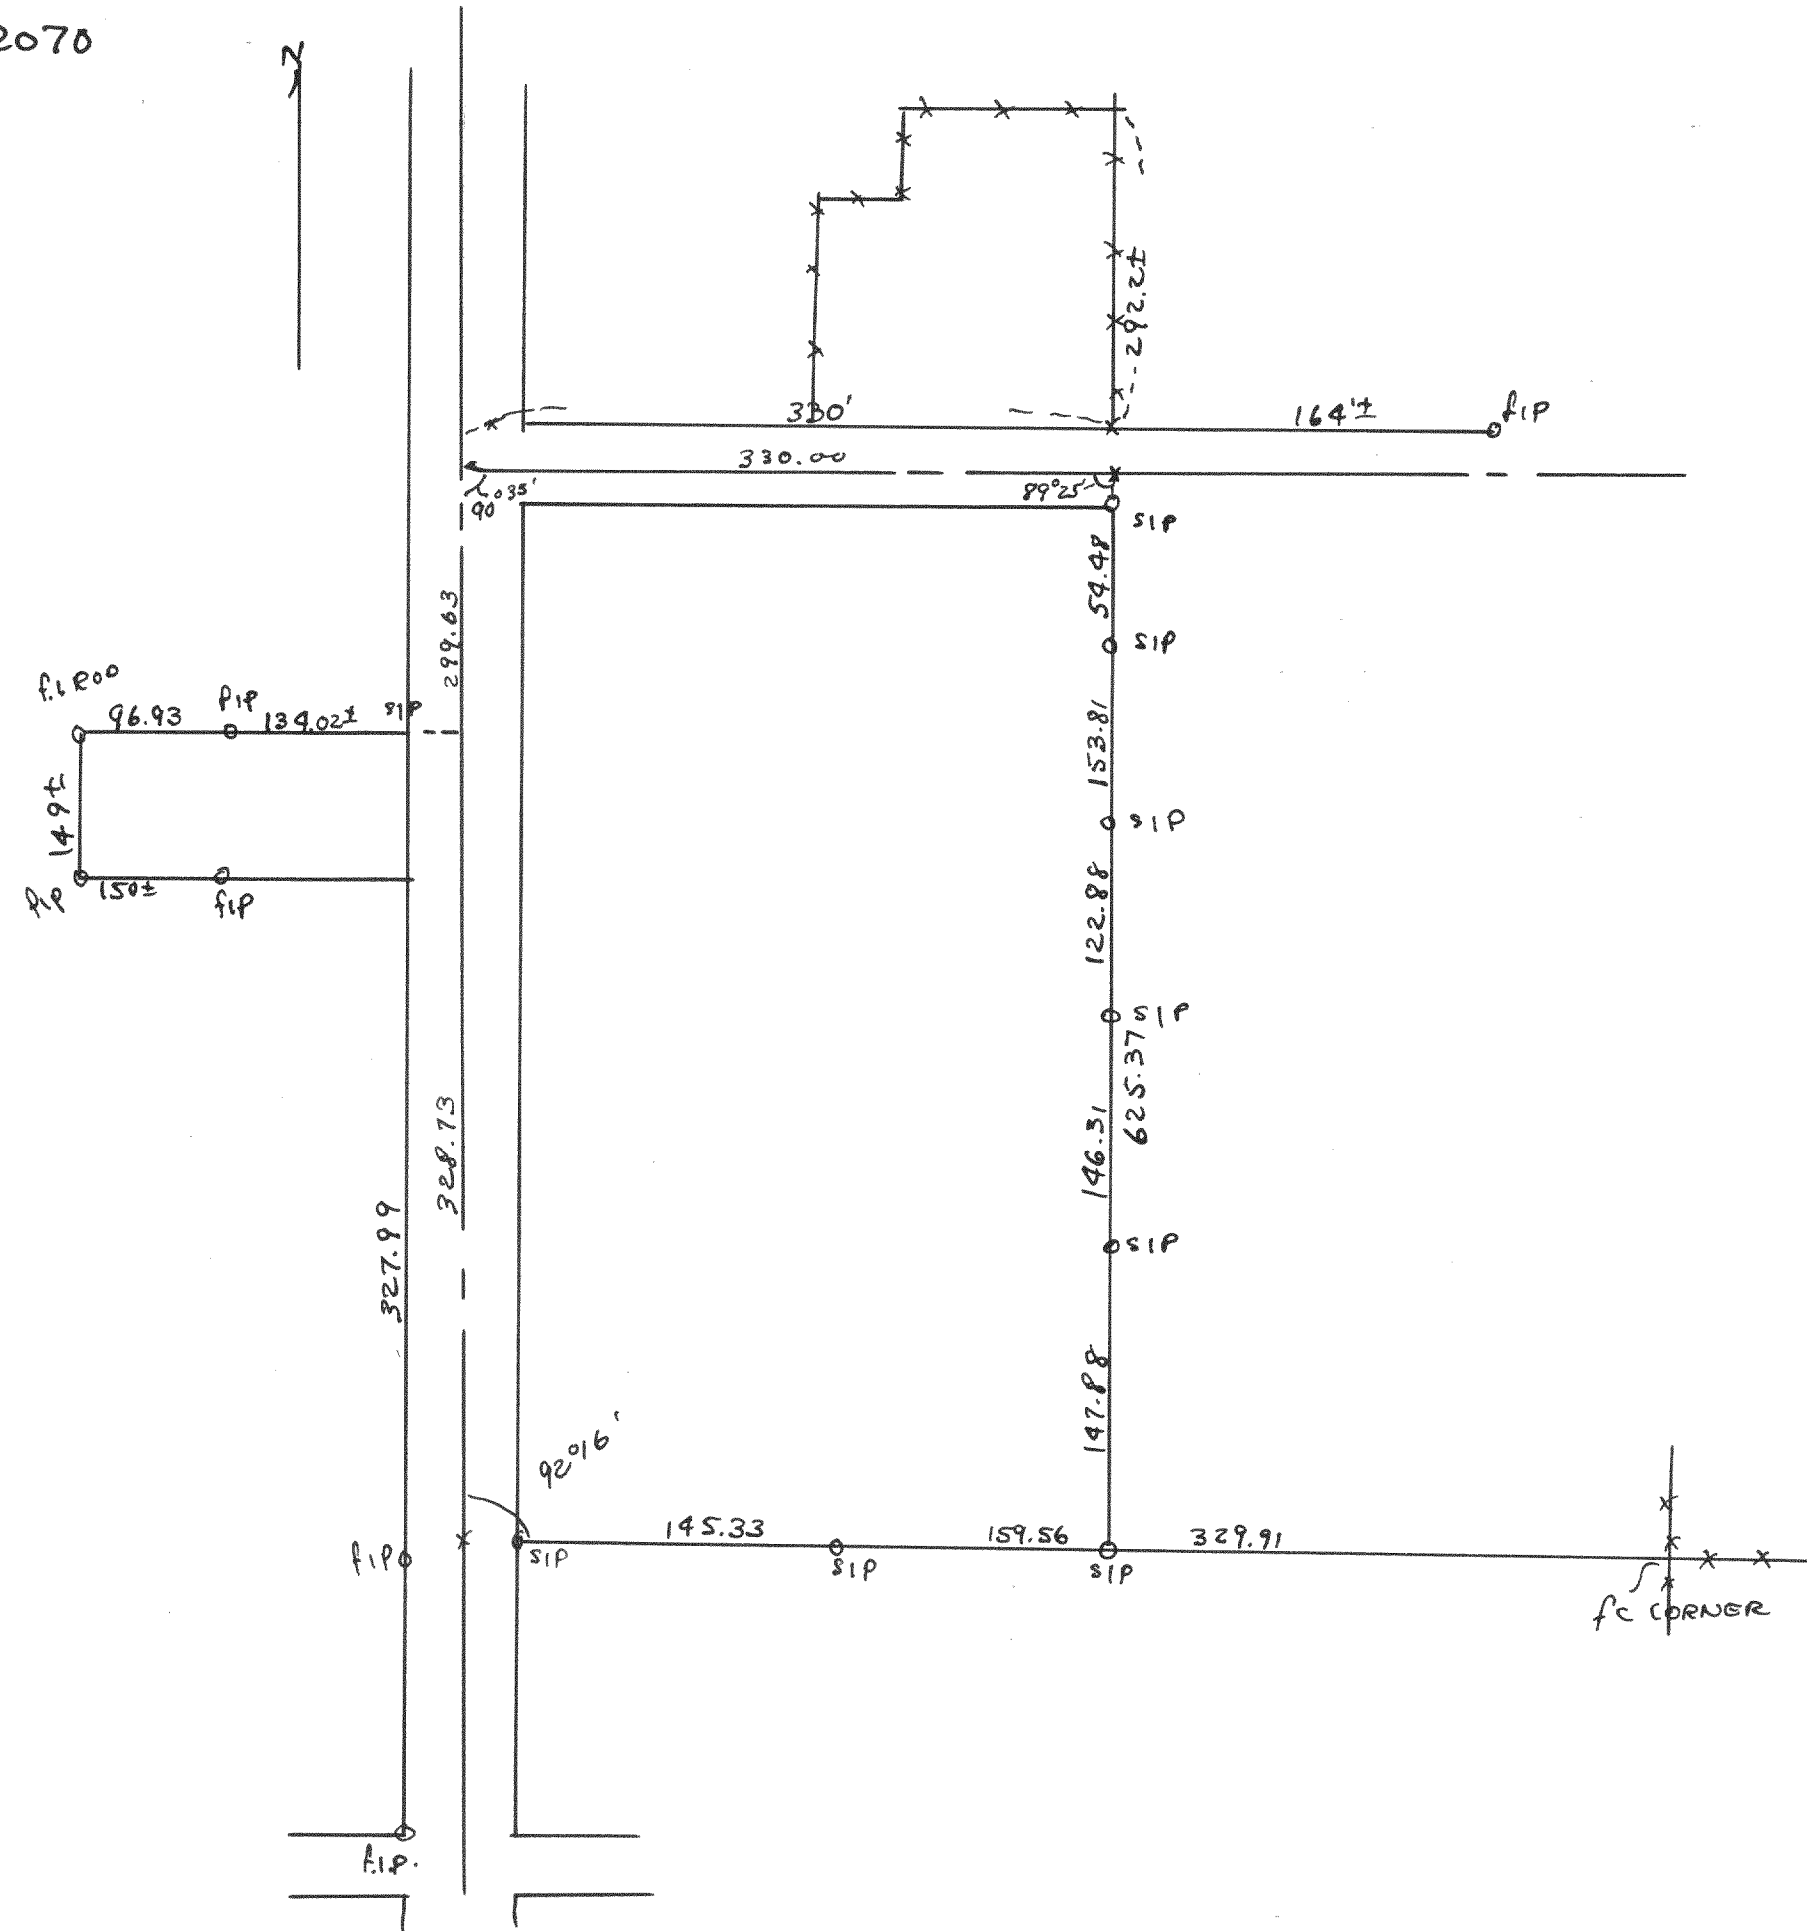

Plat of survey of the E 1/2 of the SE 1/4 of the SE 1/4 of the SW 1/4 of
Sec 20, T2N R17E
Aug 23, 1949
Lloyd L. Jensen
County Surveyor