



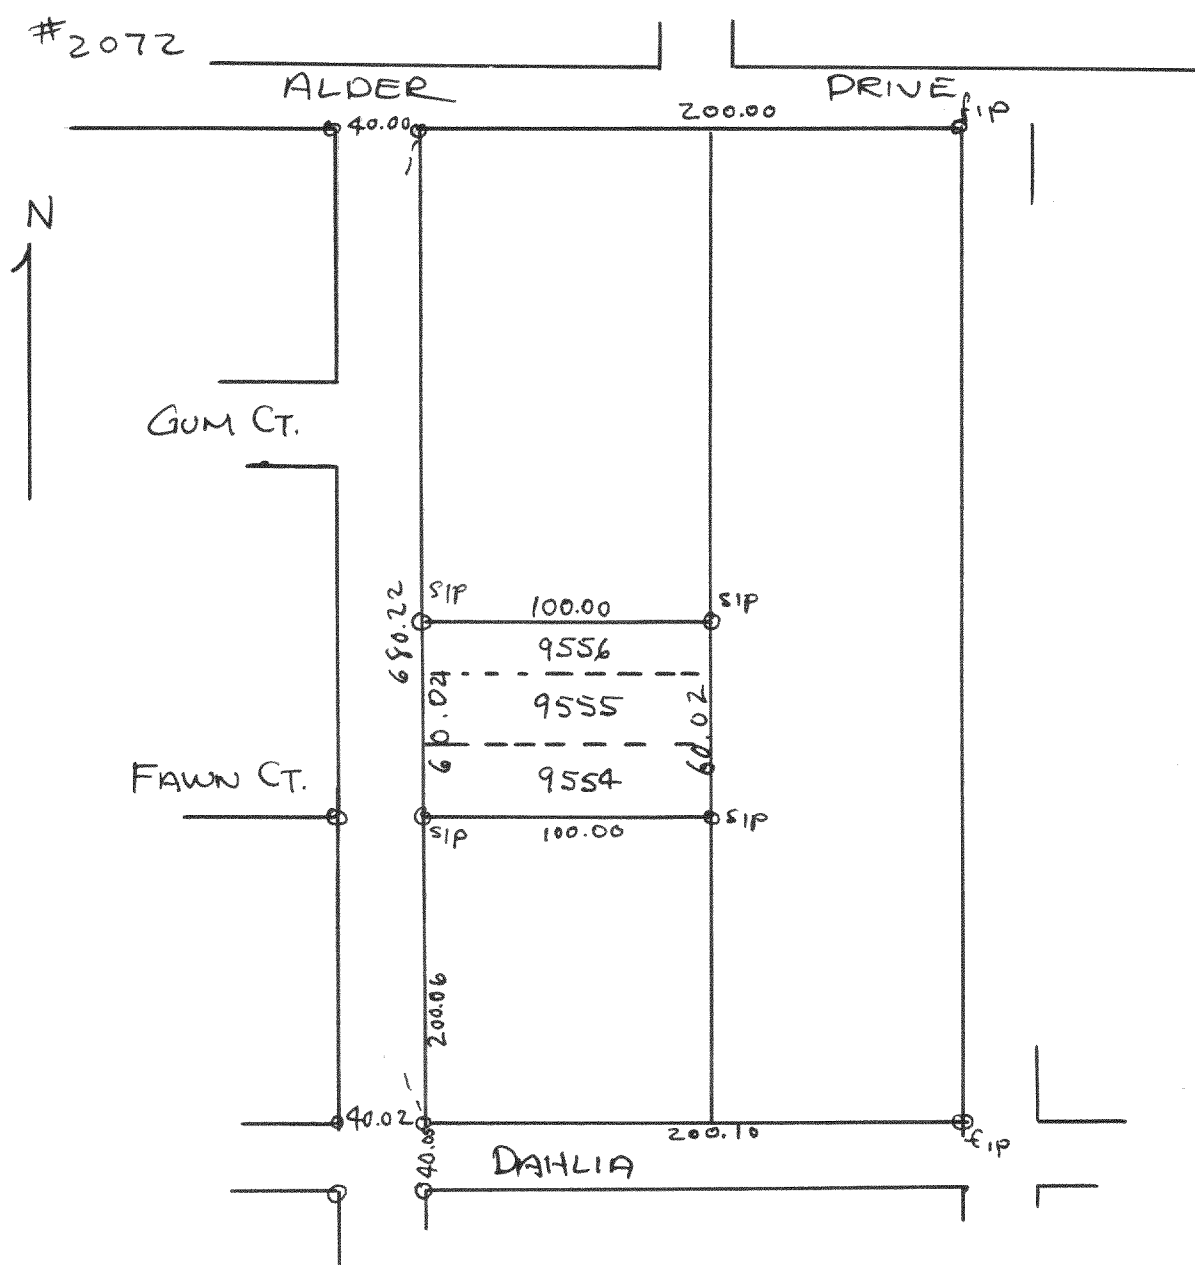

Plat of survey of lots 9554-9556 Lake Como Beach
 Subd located in Sec 21 & 22 T8N R17E, Wal. Co., Wis.
 Sept. 1, 1949
 Lloyd L. Jensen
 County Surveyor

#2073

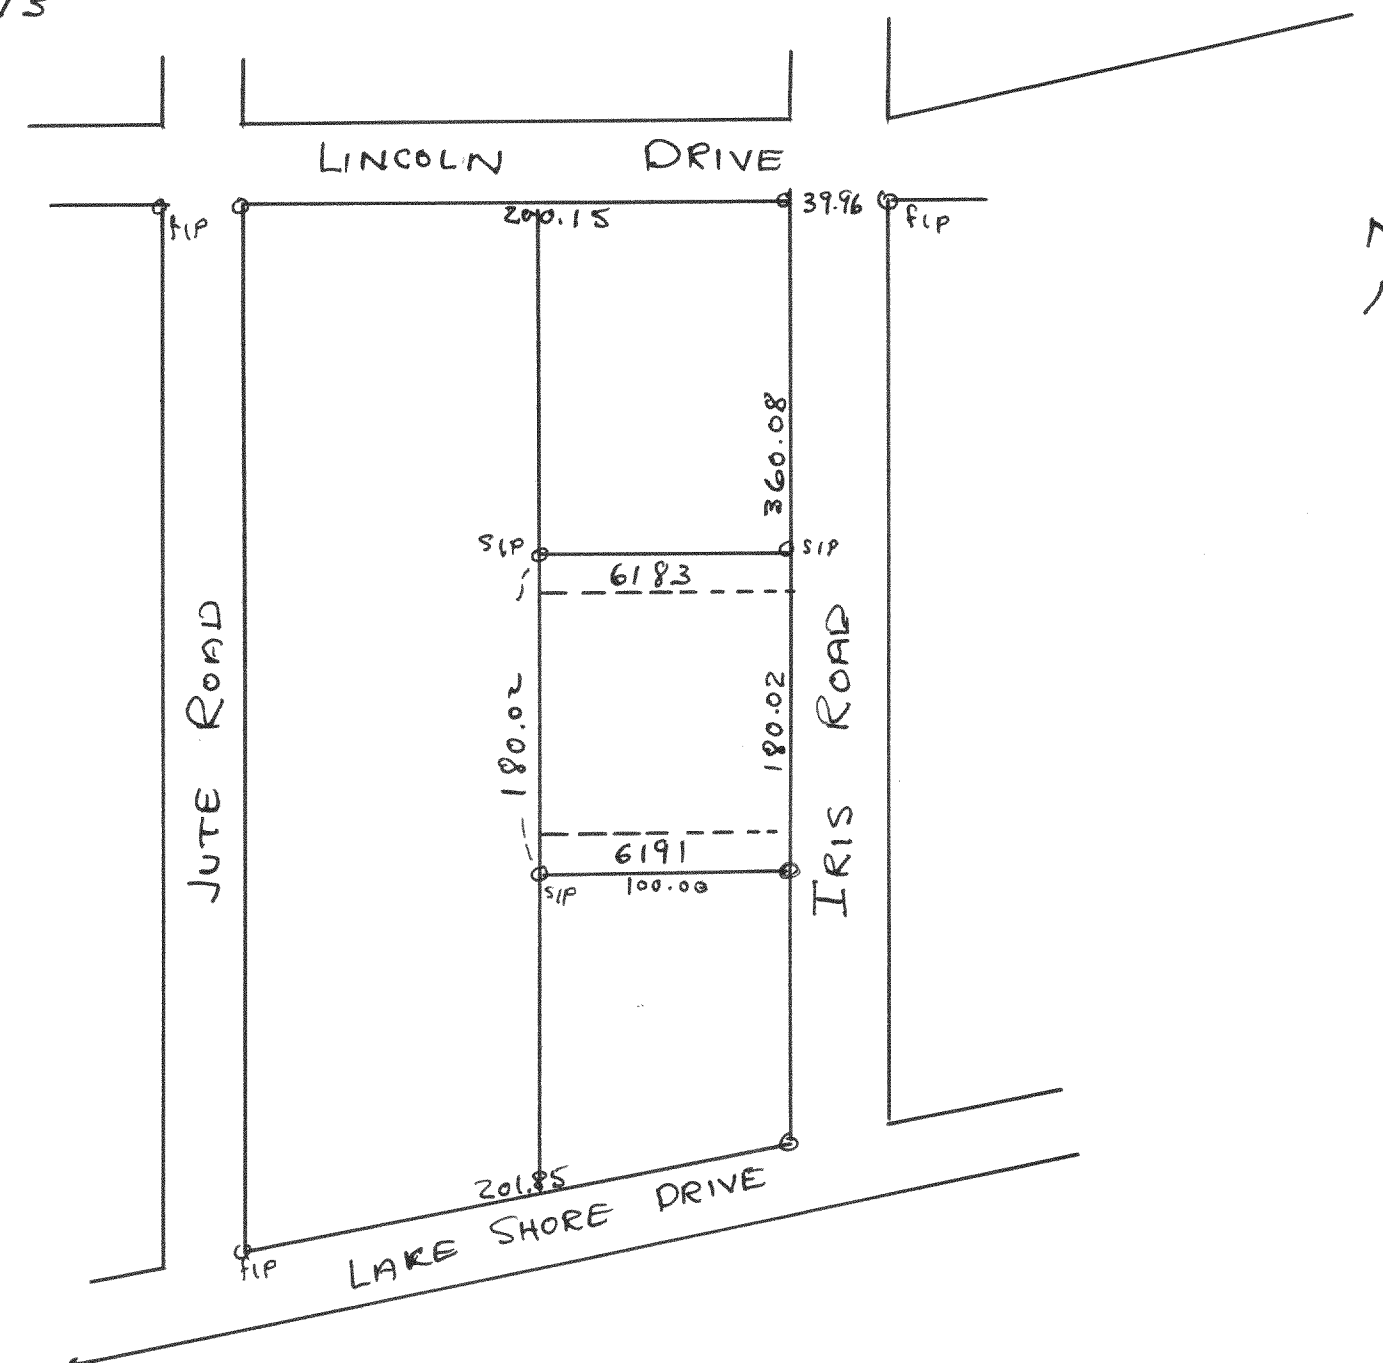

Plat of survey of lots 6183-6191 Lake Como Beach Subd
 located in Sec 21 & 22, T8N R17E, Wal. Co., Wis.
 Jan 17, 1950
 Lloyd L. Jensen
 County Surveyor