


SURVEY NO. 1263

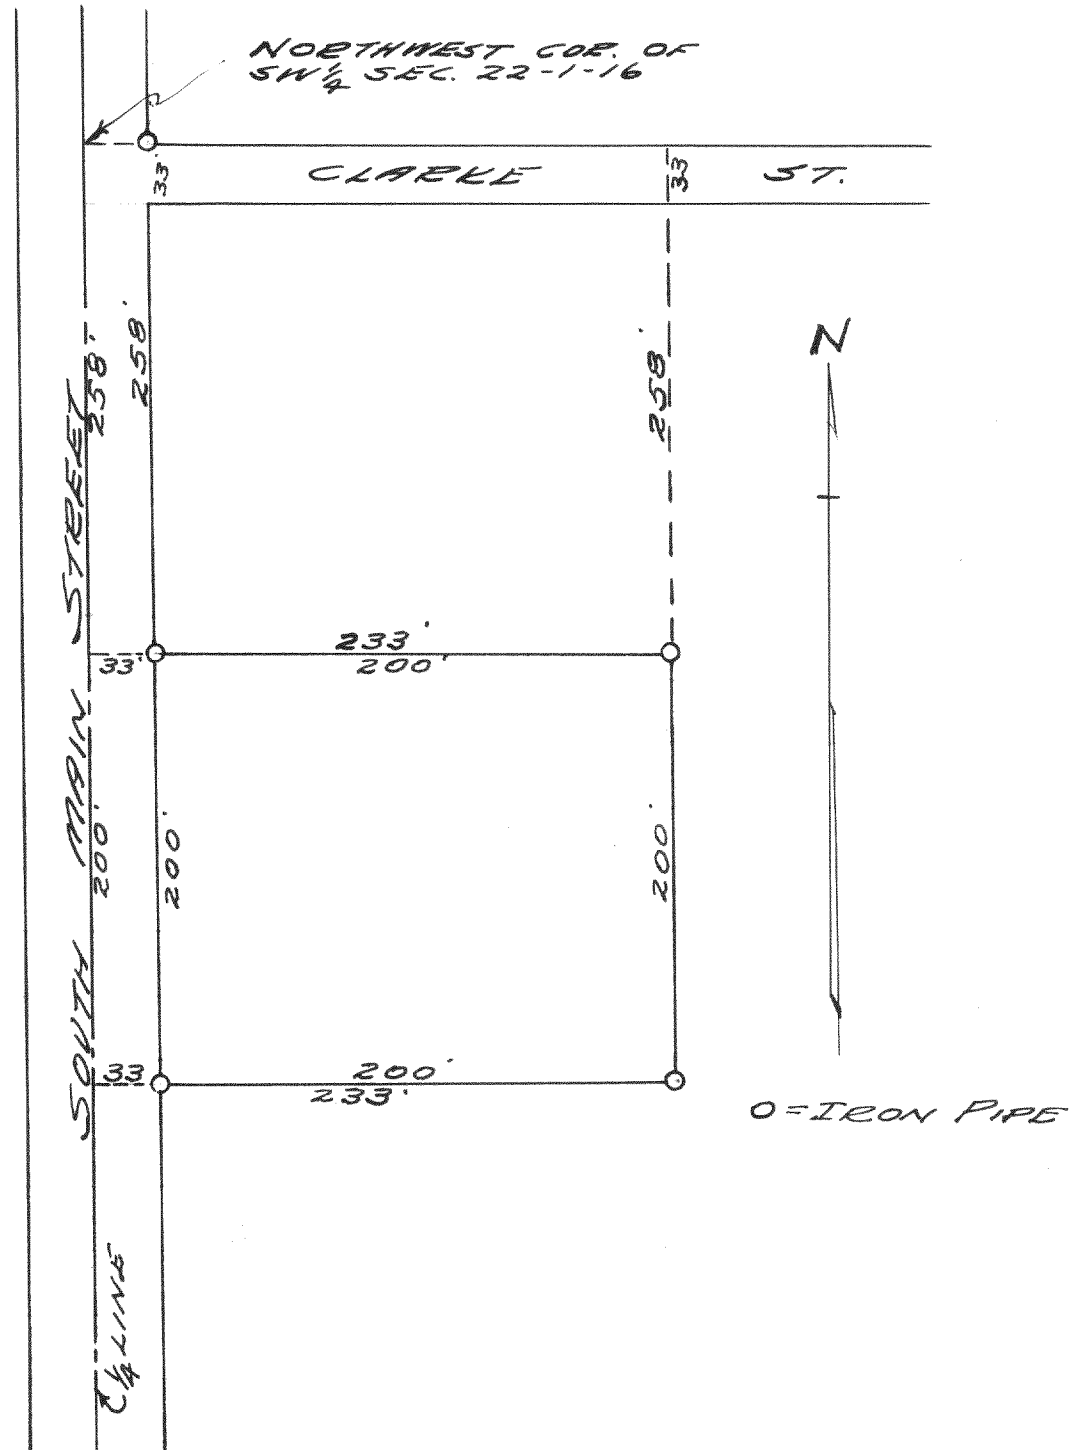


PLAT OF SURVEY OF LAND LOCATED
IN THE SW $\frac{1}{4}$ OF THE SW $\frac{1}{4}$ OF SECTION
22 T1N R16E, WALWORTH CO. WISCONSIN.

MAY 6, 1941

Lloyd L. Jensen
R.E.G.

SURVEY NO. 1264

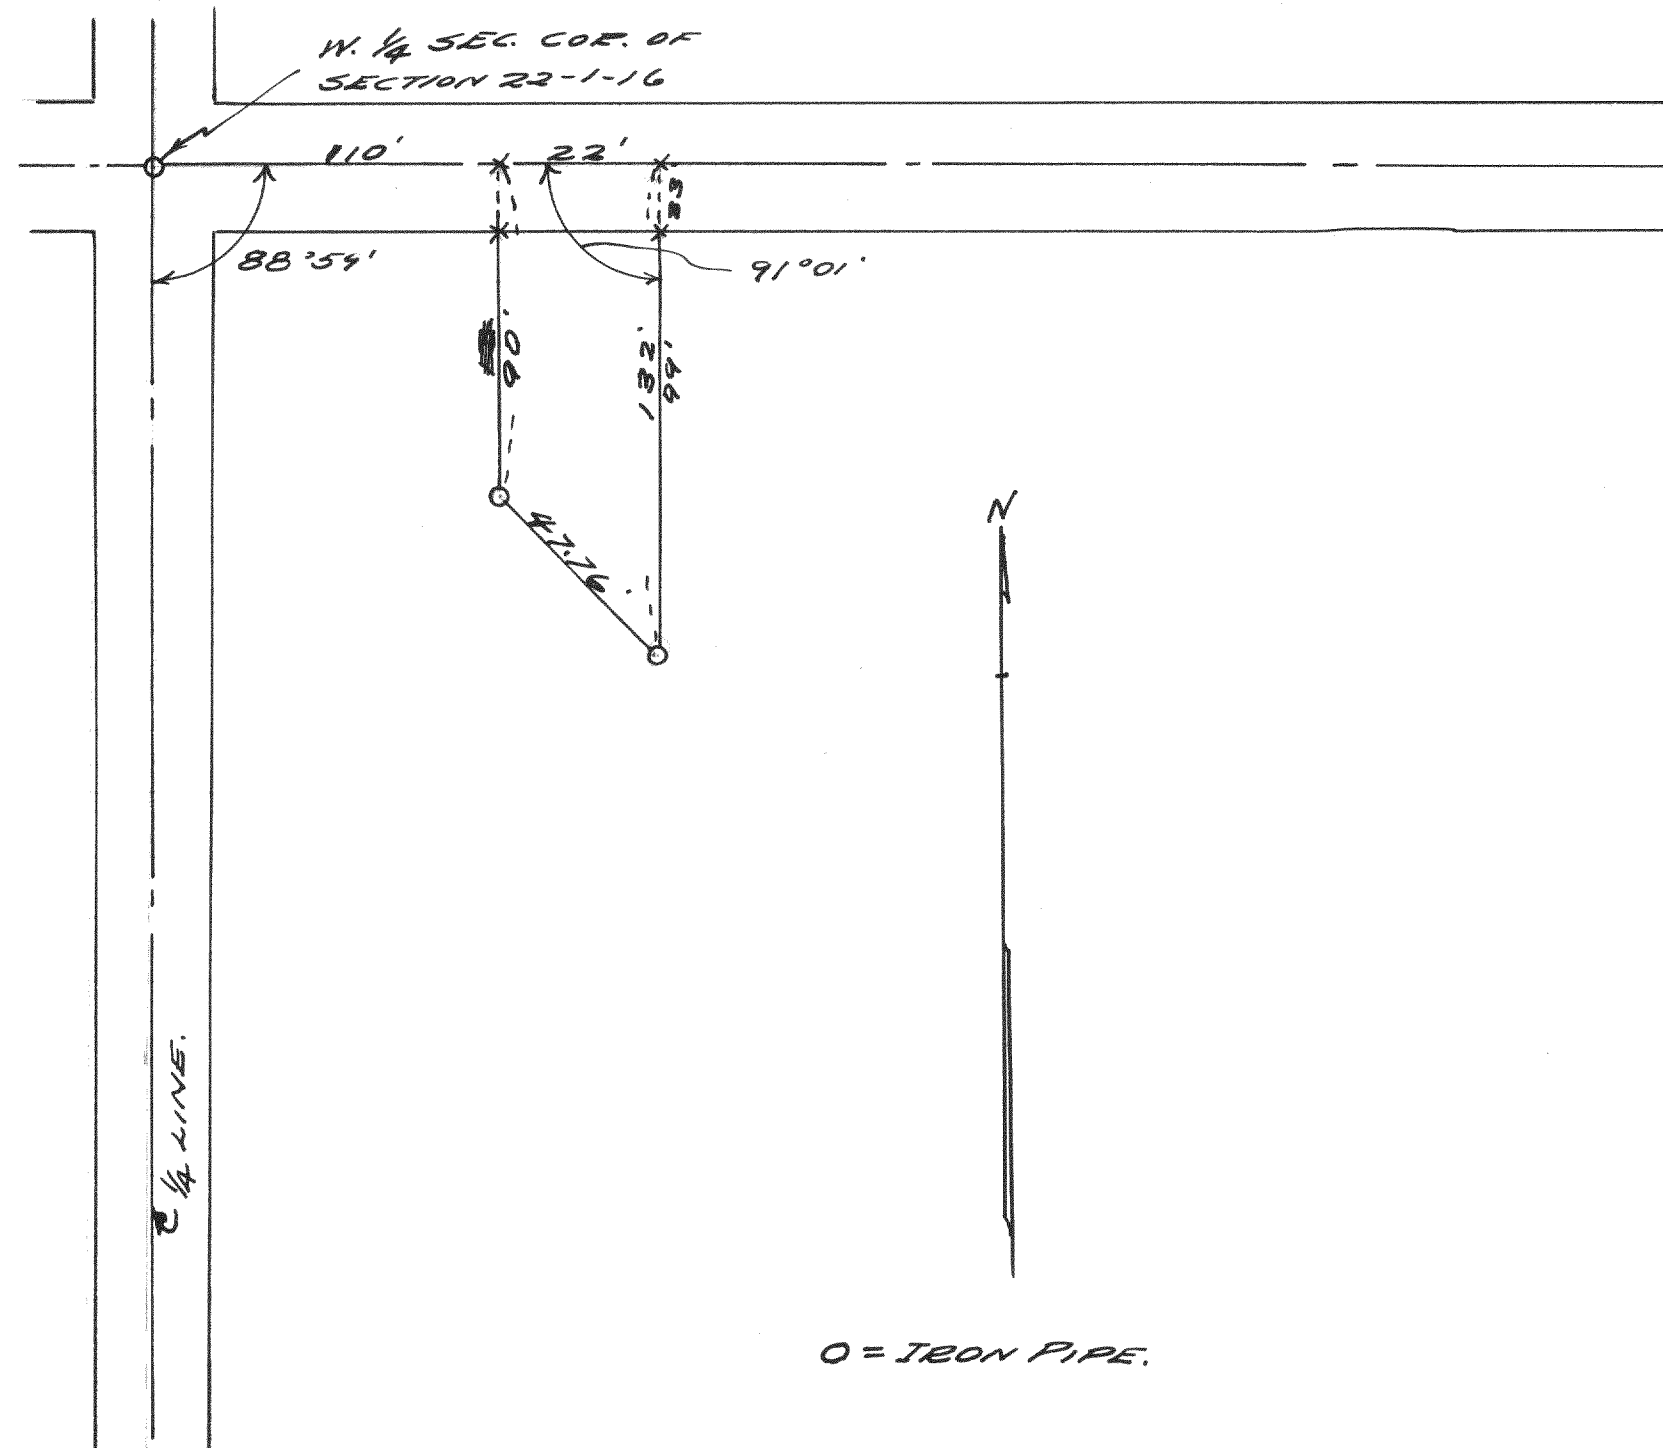

PLAT OF SURVEY OF OUTLOT 199
OF THE VILLAGE OF WALWORTH, WALWORTH
COUNTY, WISCONSIN.

JUNE 10, 1941

Lloyd L. Jensen
R.E.G.