



2079

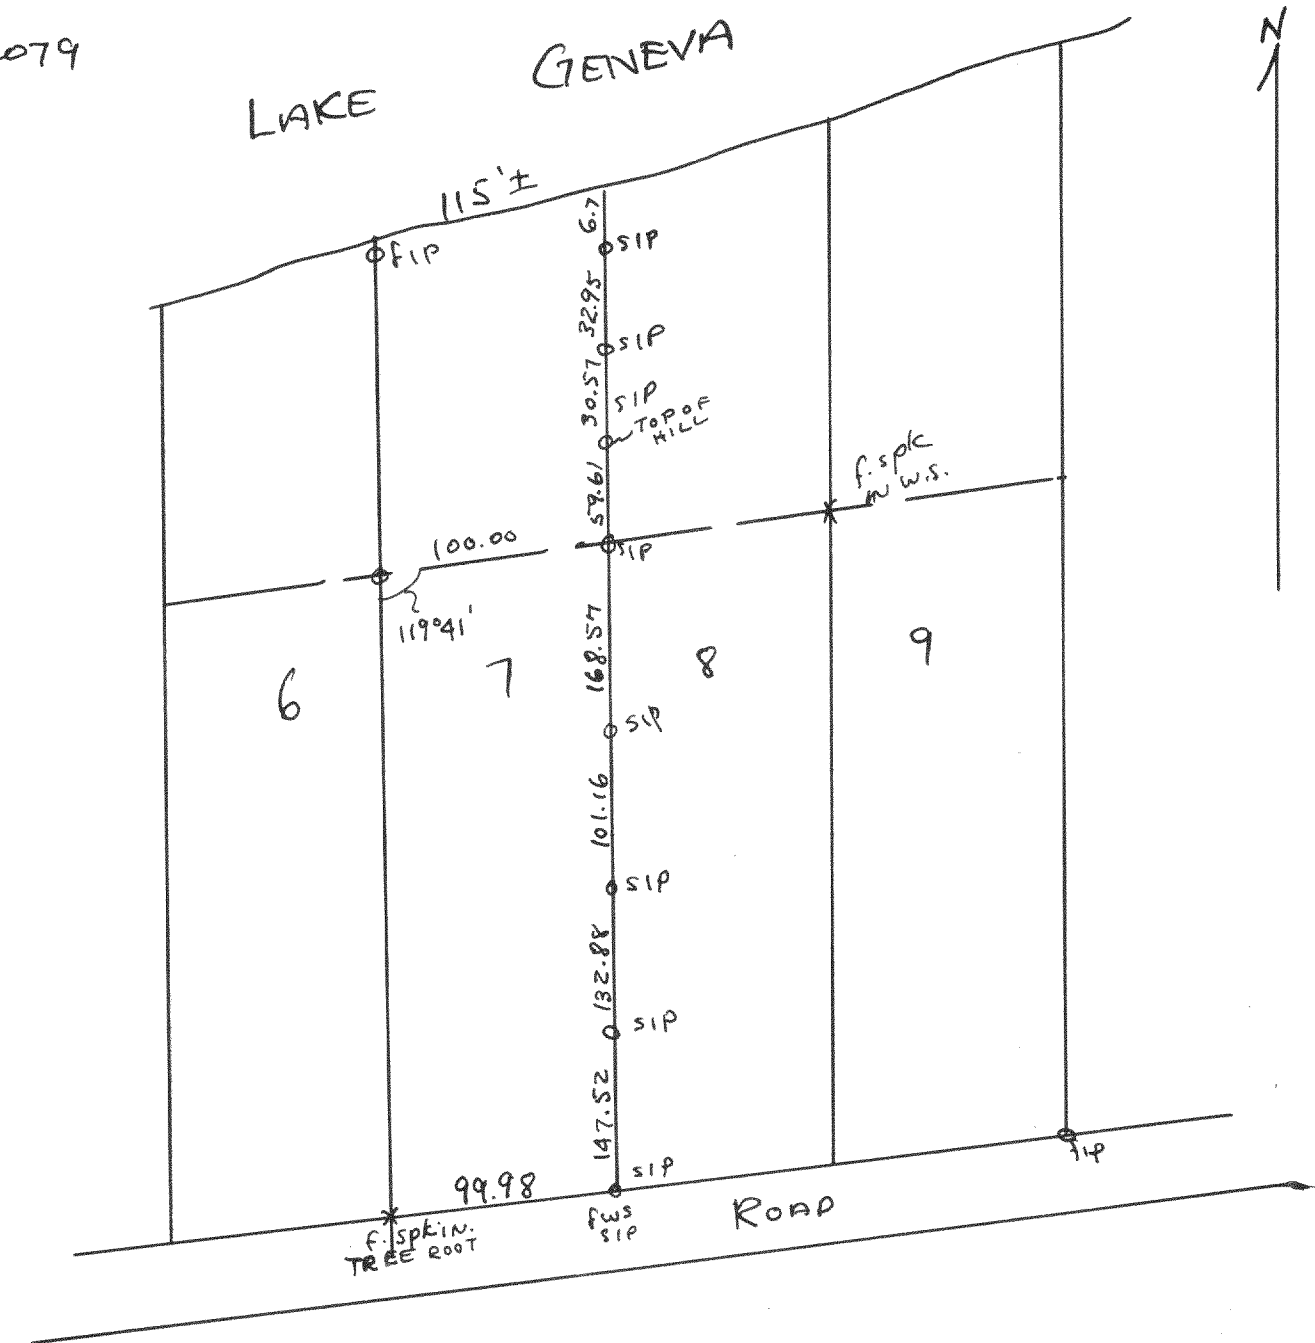

Plat of survey of line between Lots 7 & 8 of
The Birchwood Addition, located in Sec 10, T1N R1E
Walworth Co., Wis
May 10, 1949

Lloyd A. Jensen
County Surveyor

#2080

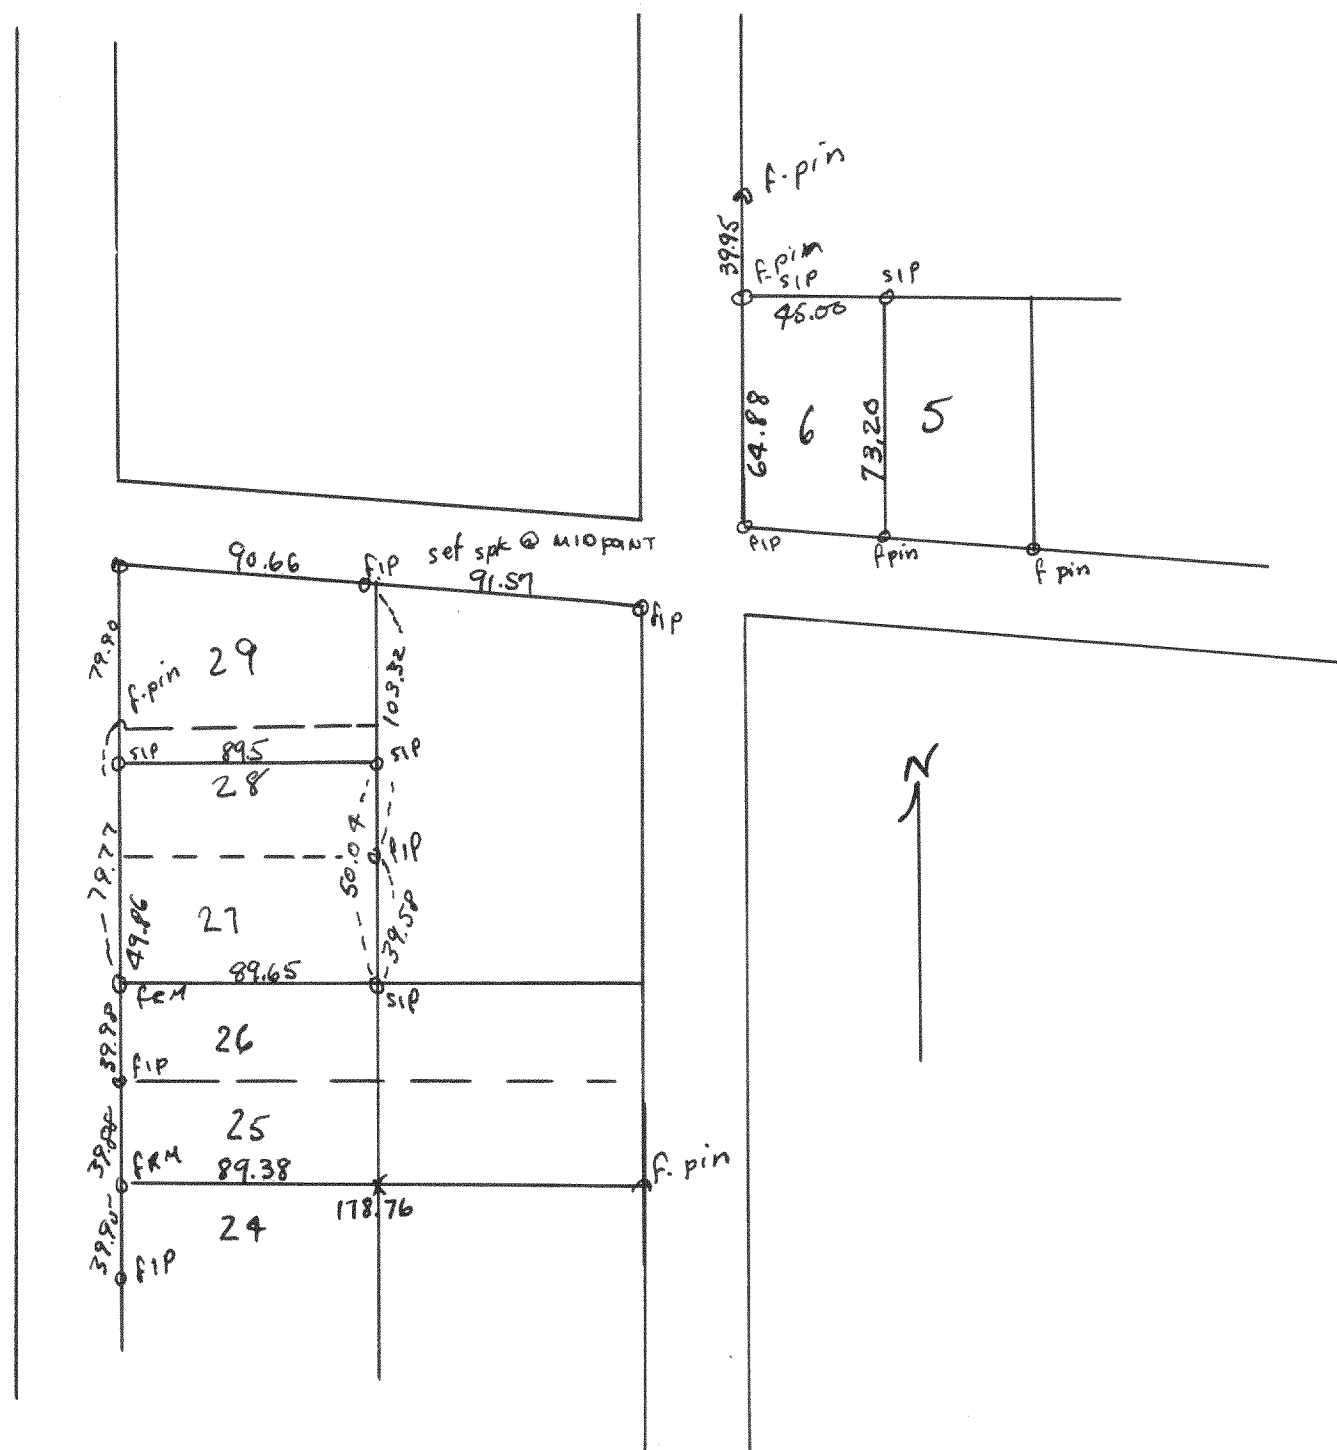

Plat of survey of lot 6 Block I & lot 27 and
South 10' of lot 28 Block C, Arco Beach Subd. located
in Sec 5, T1N R1E, Walworth County, Wis.
June 20, 1949

Lloyd A. Jensen
County Surveyor