



#2084

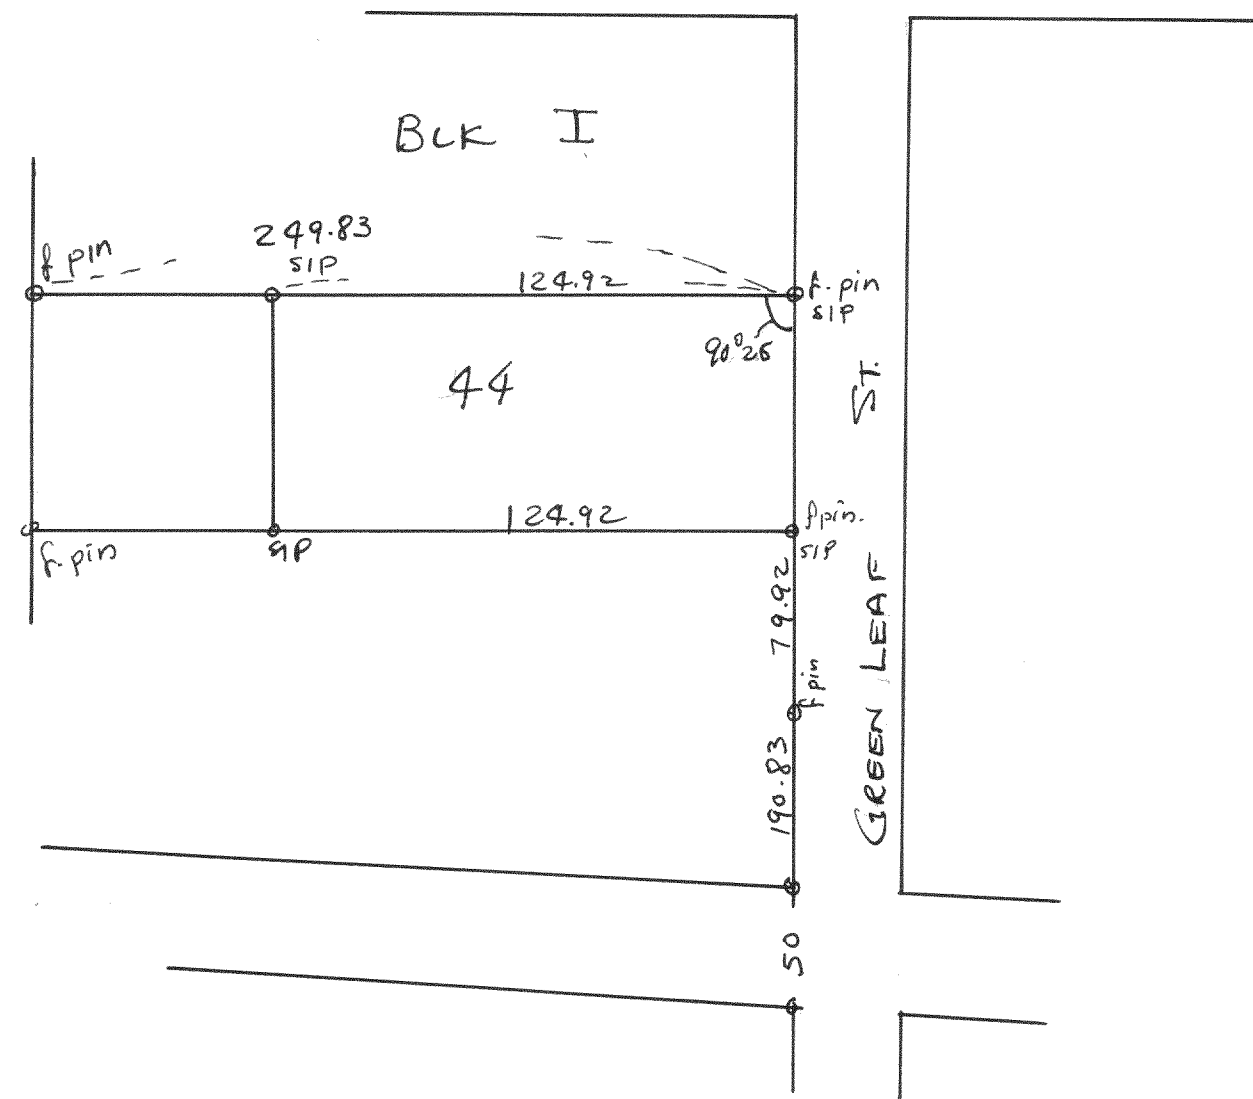


Plat of survey of part of lot 44 Block I of Cisco Beach Subd. located in Sec 5, T14N R17E Walworth Co., Wis.
Nov. 1, 1949
Lloyd L. Jensen
County Surveyor

#2085

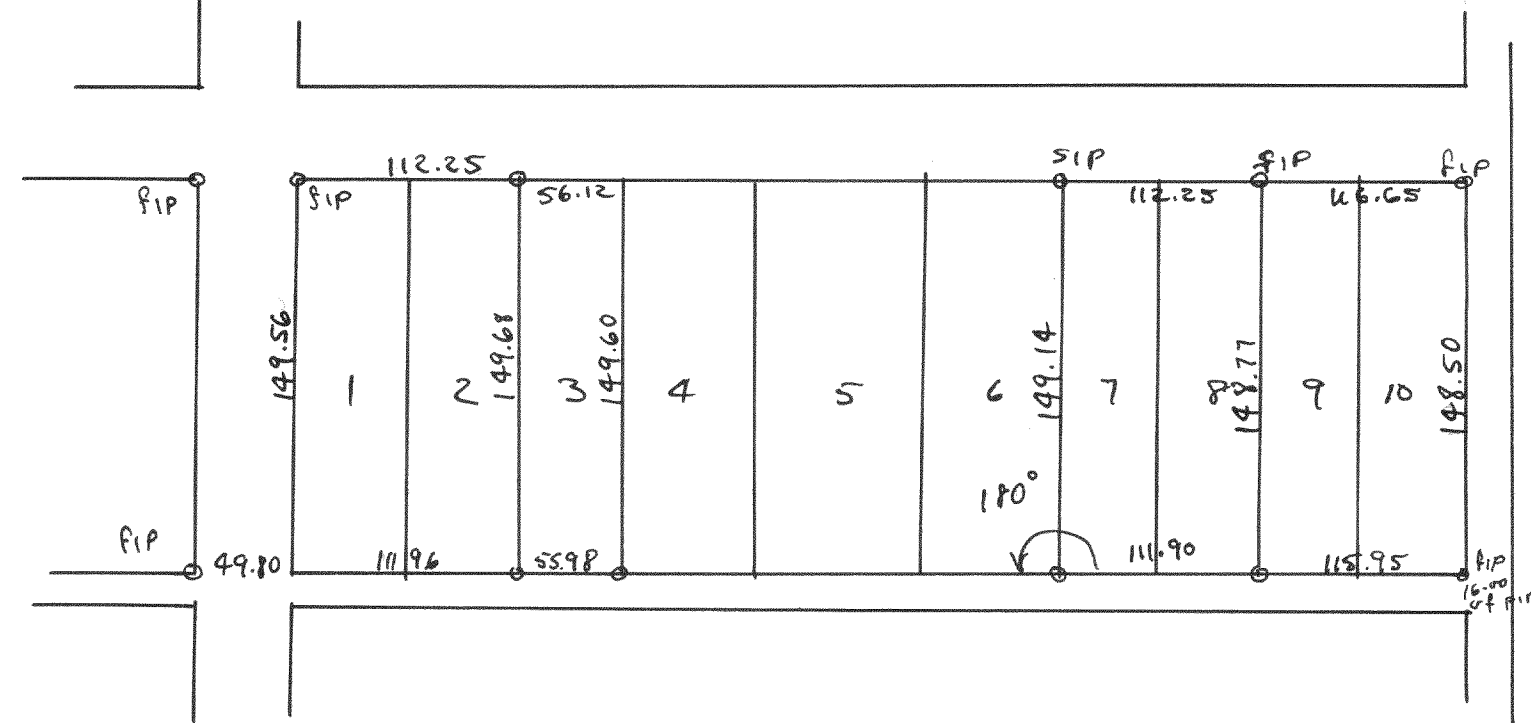

Plat of survey of lots 3, 7 & 8 of Block 7, Genivista Subd. located in Sec 10, T14N R17E, Walworth Co., Wis.
1949
Lloyd L. Jensen
County Surveyor

#2086

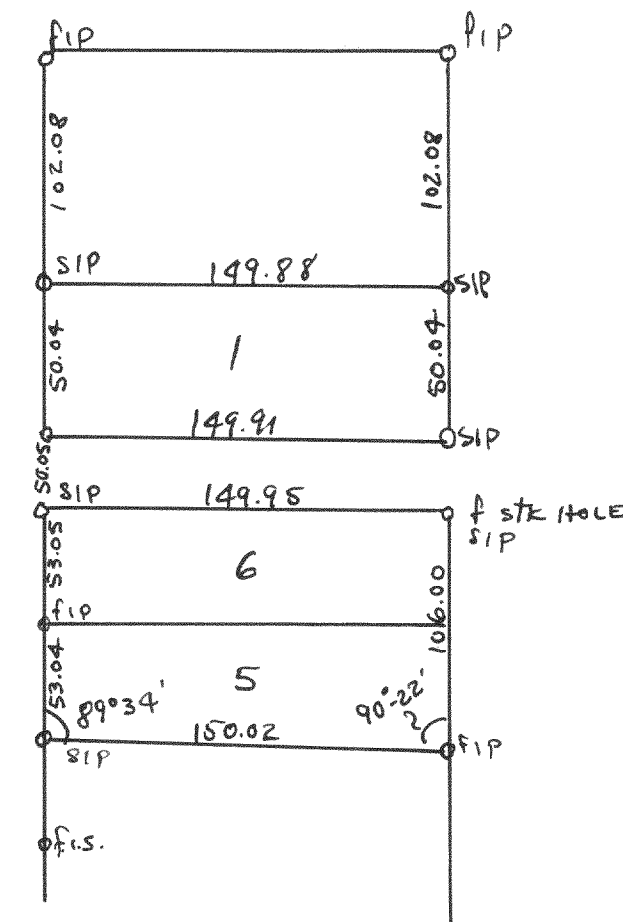

Plat of survey of lot 1 Block 2 & lots 5 & 6 of Block 1 in Laurence Add. to Genivista located in Sec 18, T14N R17E Wal. Co., Wis.
1949
Lloyd L. Jensen
County Surveyor