



2087

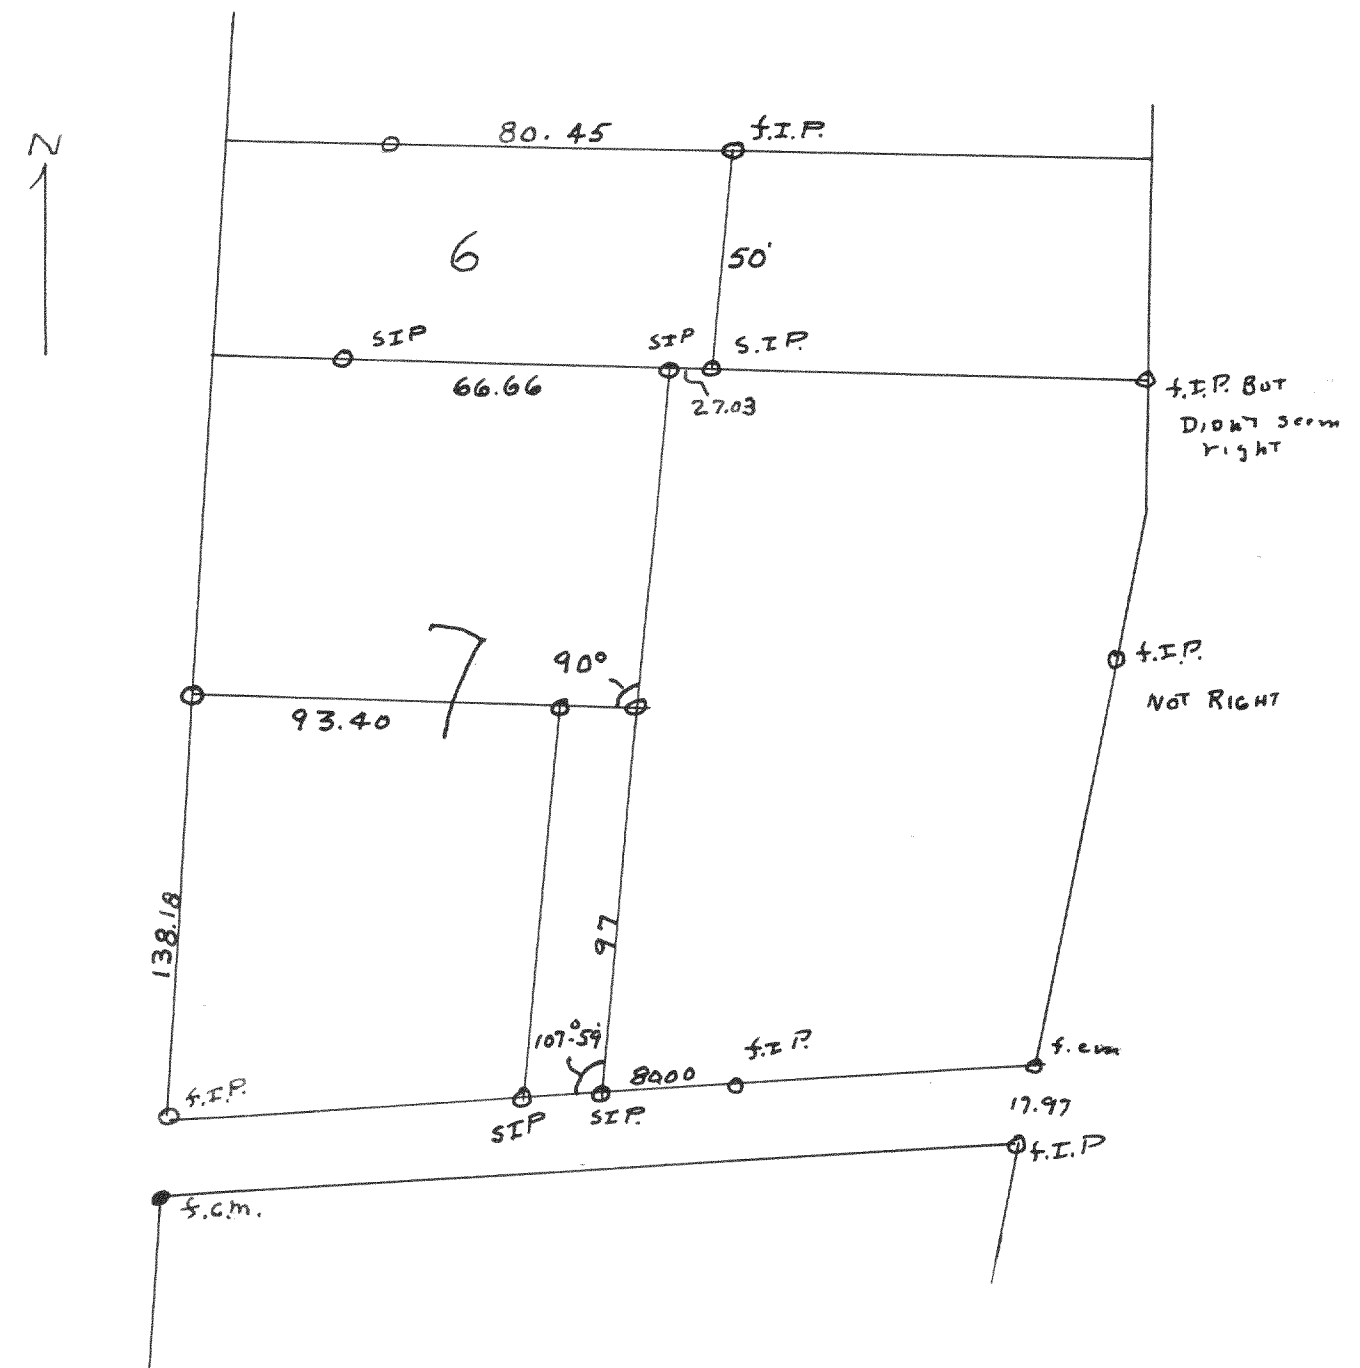


Plot of survey of lots 6 & 7 of Zible Subdivision located in Section 13, T14N R18E of Malworth County
April 16, 1949
Lloyd L. Jensen *sd*
County Surveyor

2088

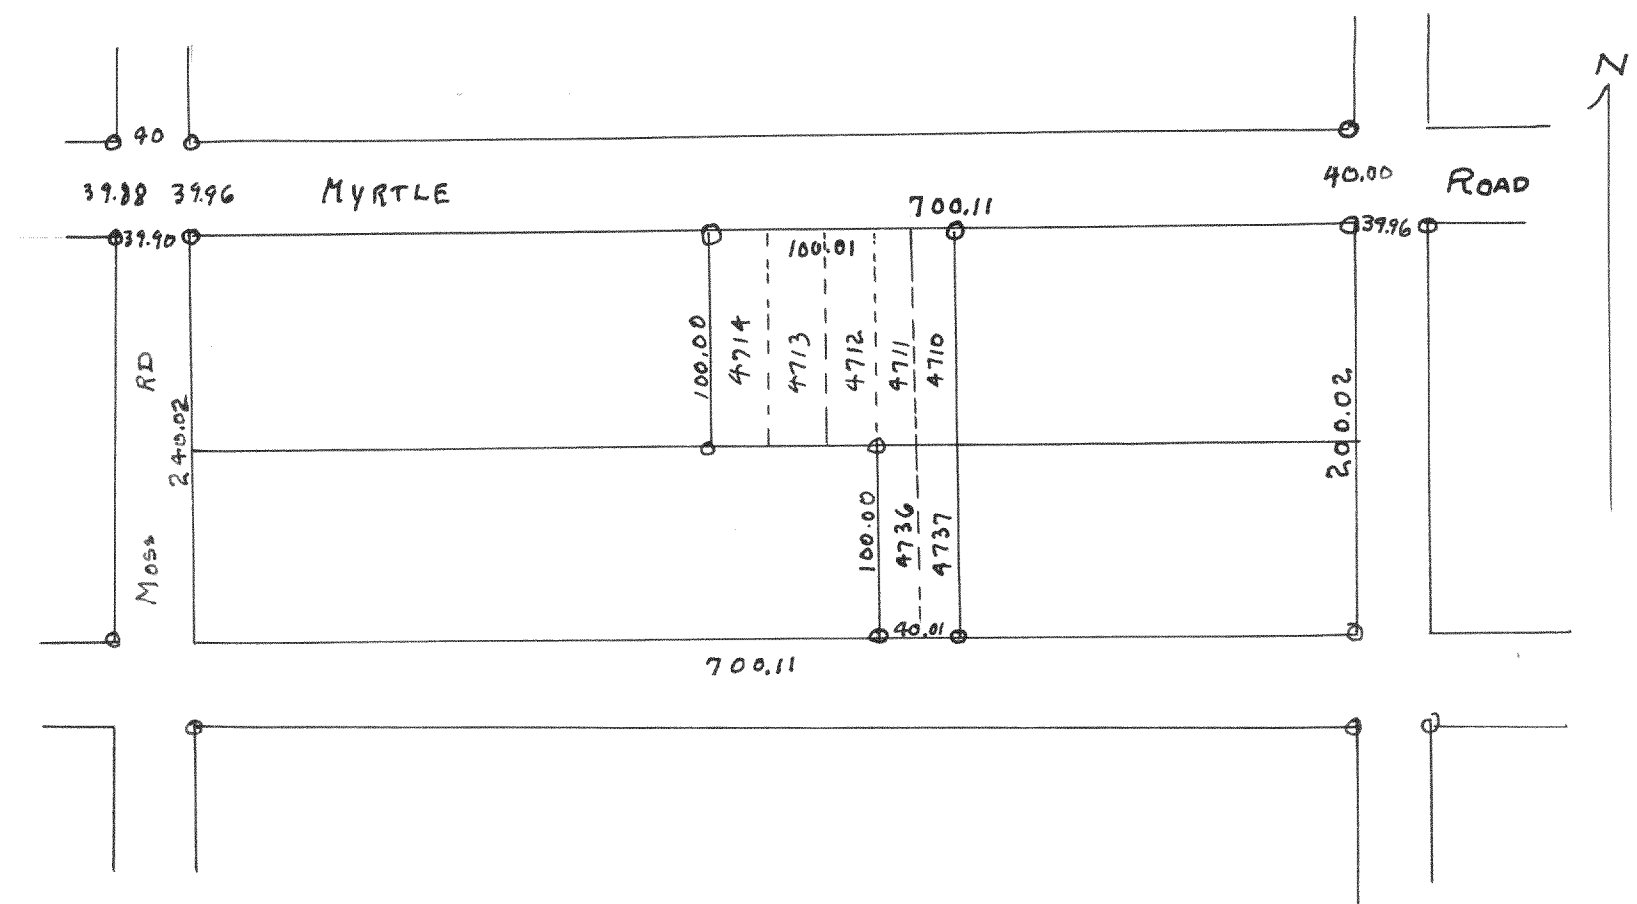

Plot of survey of lots 4710-4714 Section 3 of Bell Lake Subdivisions Malworth County
May 7, 1949
Lloyd L. Jensen *sd*
County Surveyor

2089

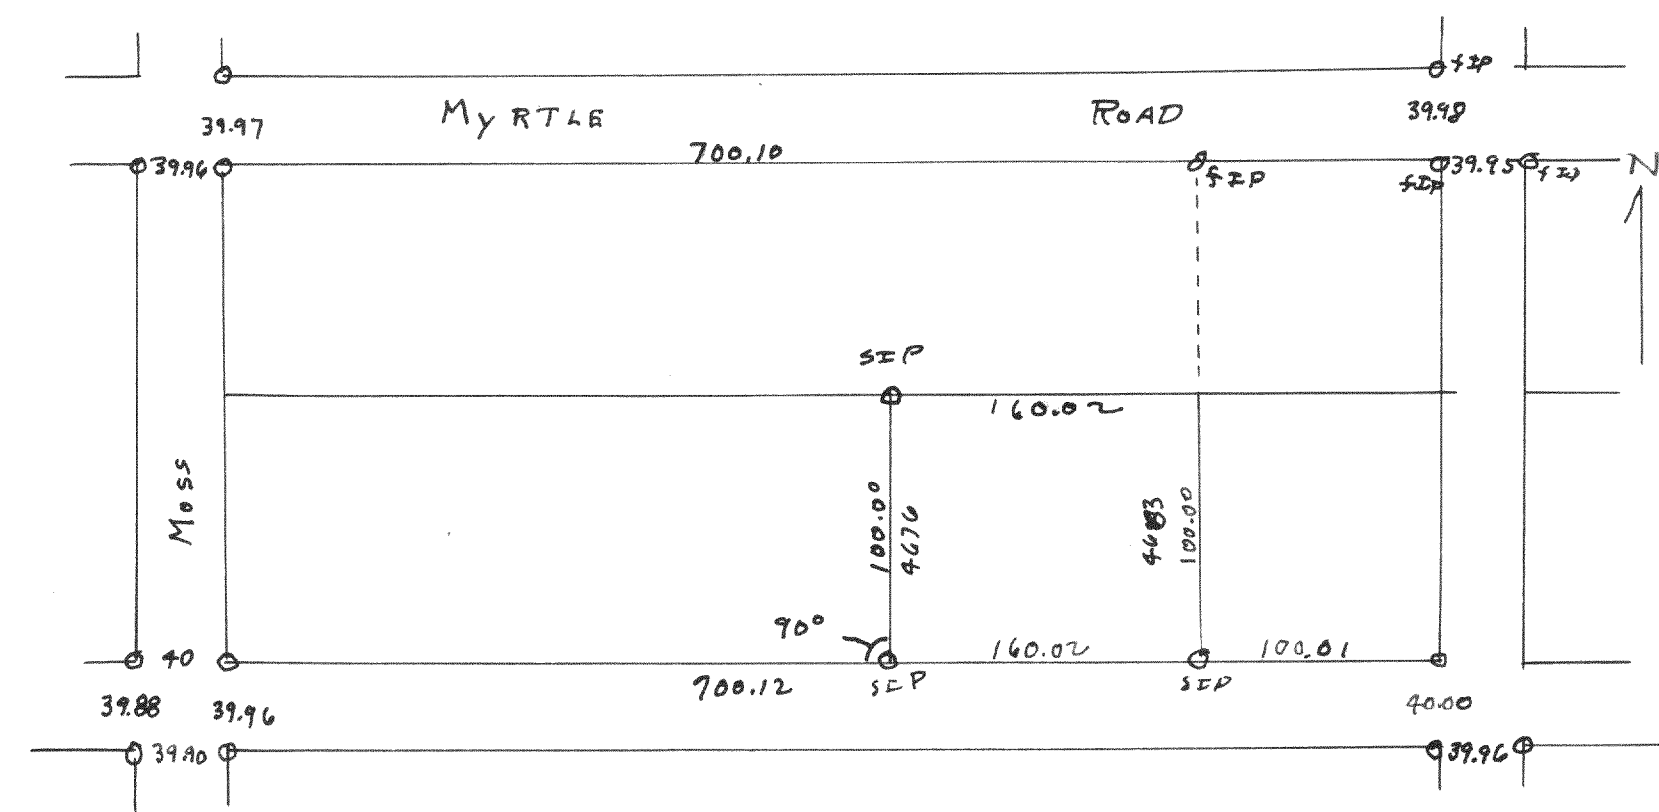

Plot of survey of lots 4670-4683 Bell Lake subdivision T14N R18E Malworth County
May 7, 1949
Lloyd L. Jensen *sd*
County Surveyor