



2090

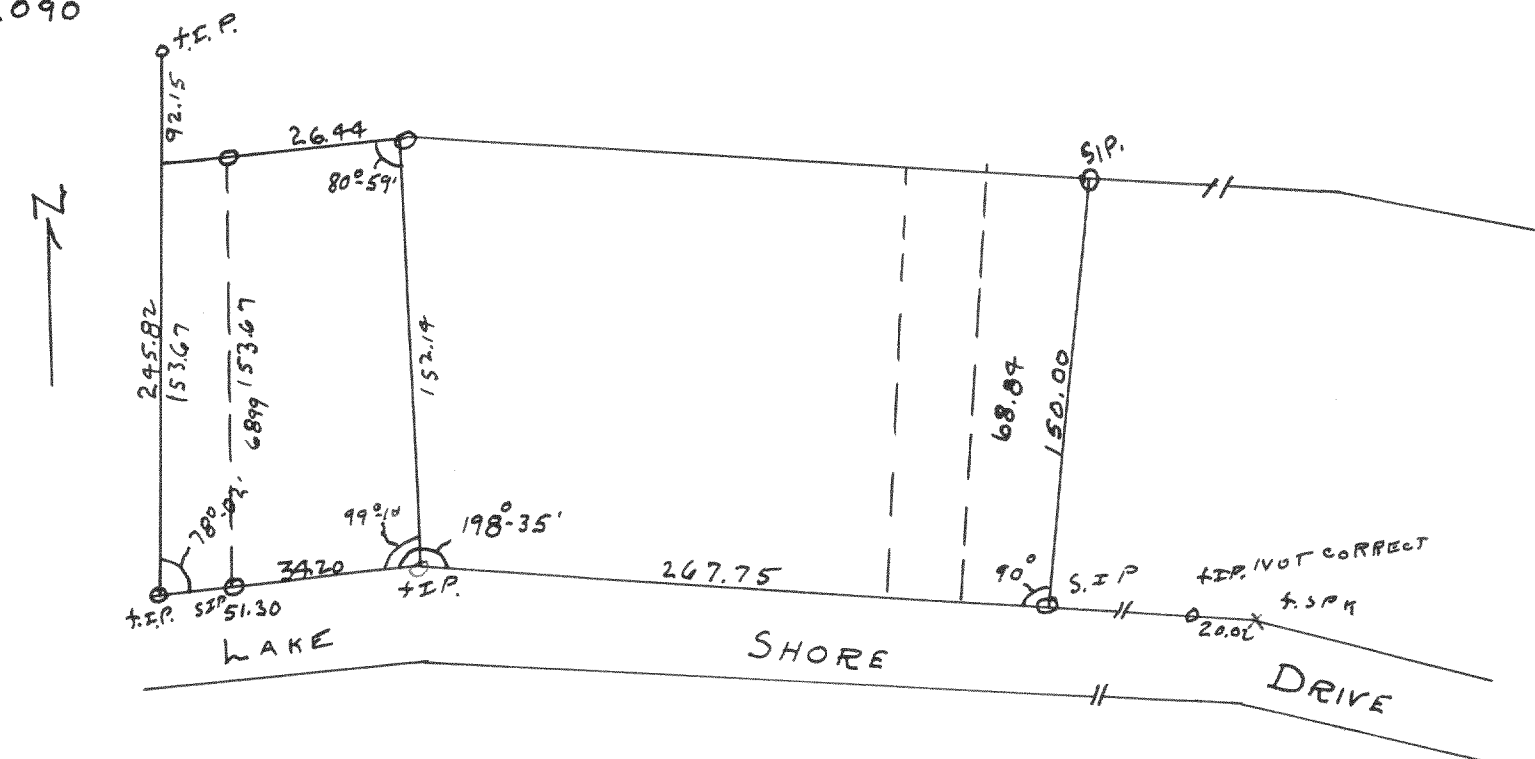

Plot of survey of lots 6884-6899 Sell Lake Subdivision
TINRIBE Mahon County
May 9, 1949

Lloyd & Jensen
County Surveyor


2092

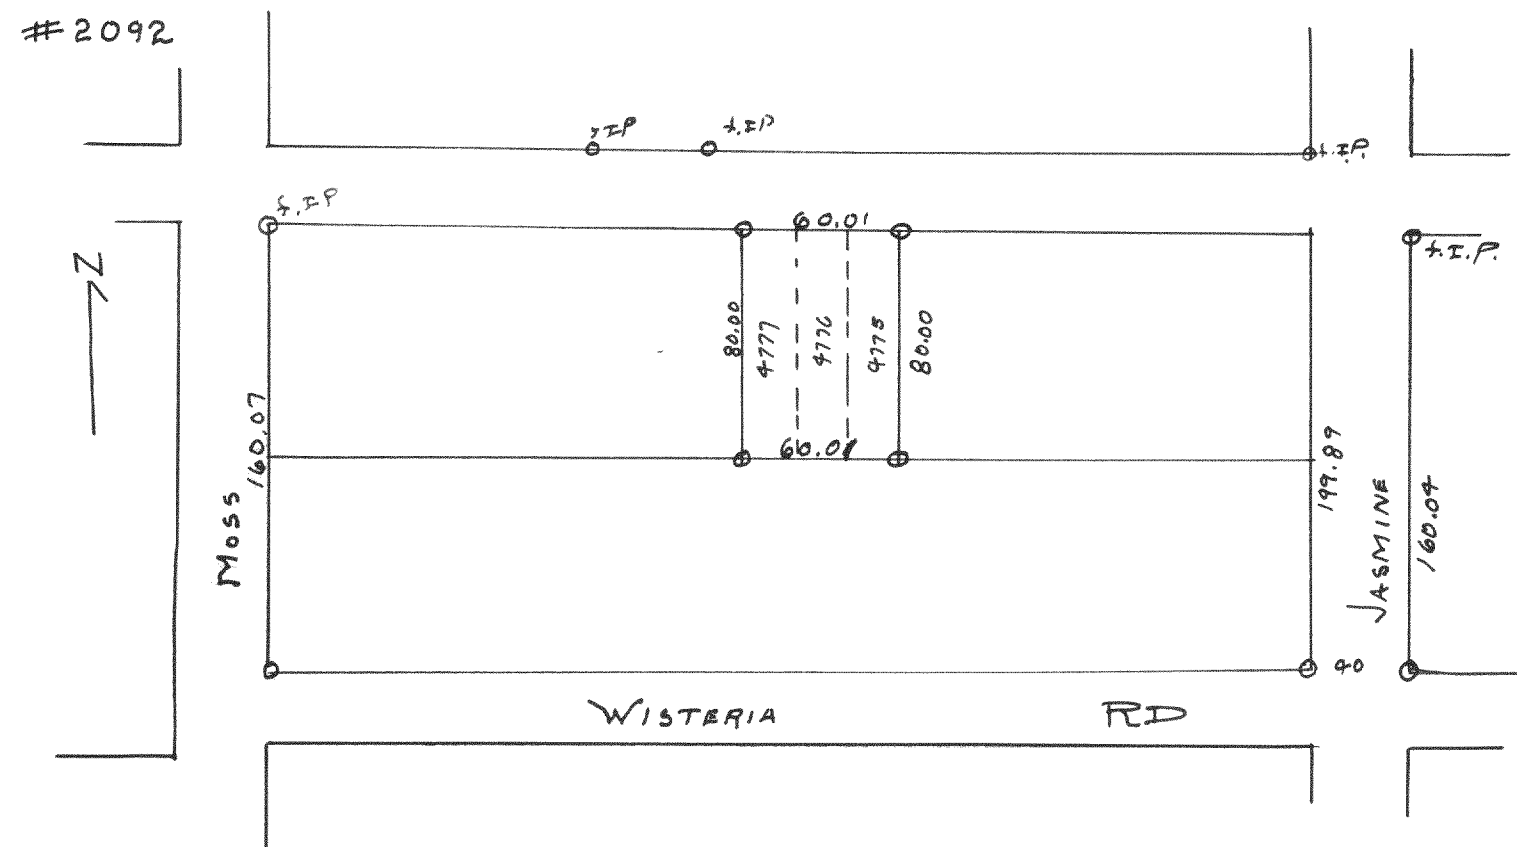

Plot of survey of lots 4775-4777 Sell Lake Subdivision
TINRIBE Mahon County
June 8, 1949

Lloyd & Jensen
County Surveyor


2091

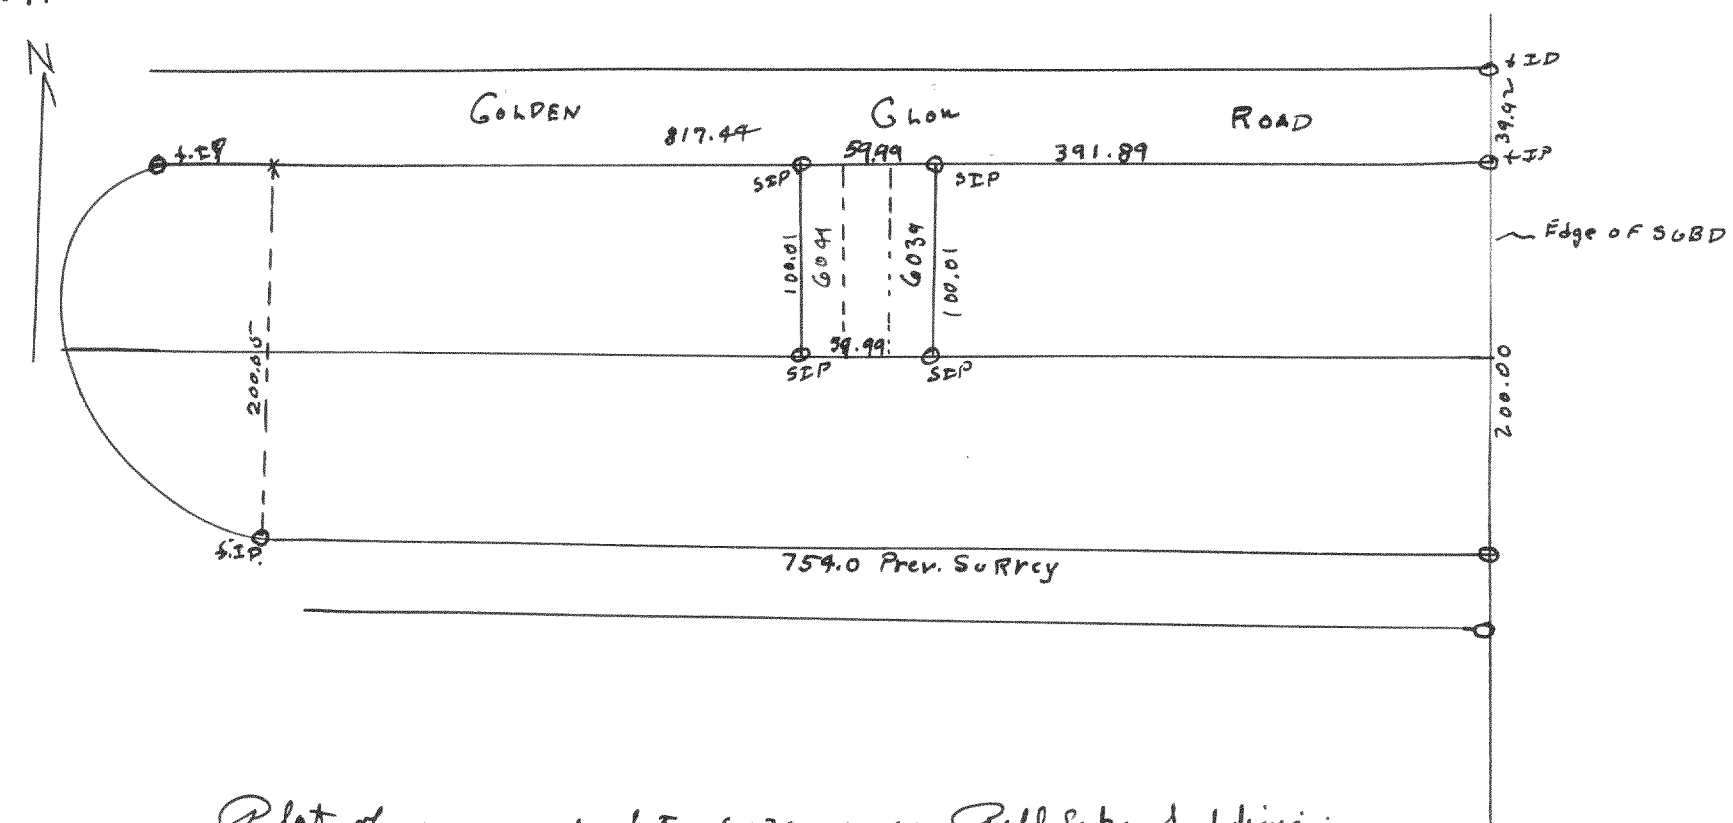

Plot of survey of lots 4039-4041 Sell Lake Subdivision
TINRIBE Mahon County
May 11, 1949

Lloyd & Jensen
County Surveyor

2093

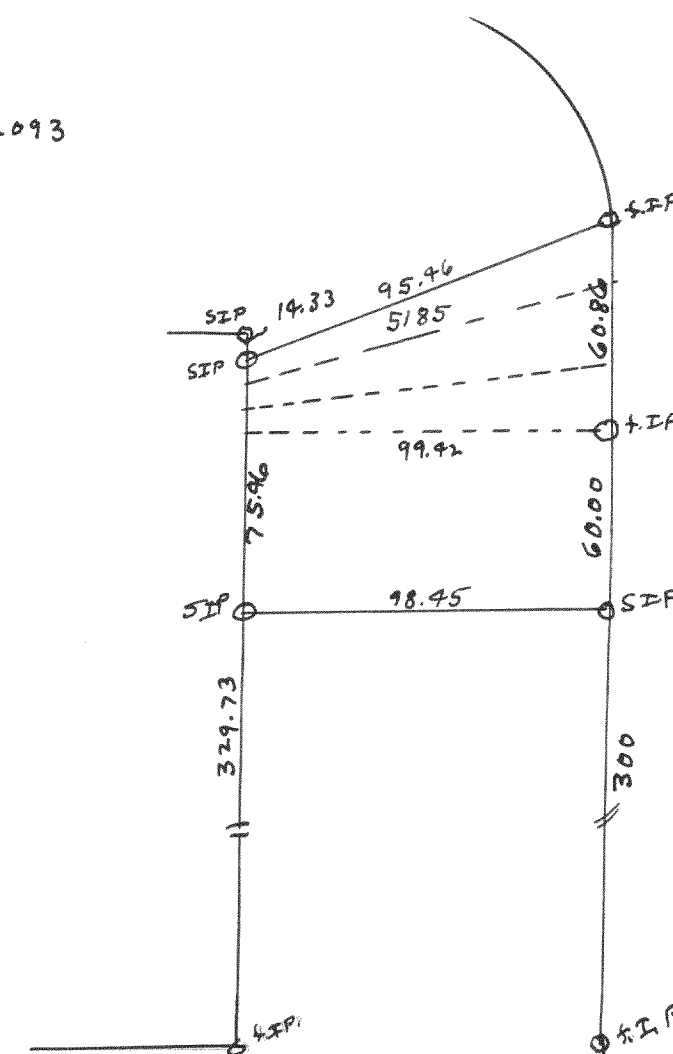

Plot of survey of lots 5185 to 5190 Sell Lake Subdivision
TINRIBE
June 8, 1949

Lloyd & Jensen
County Surveyor