



SURVEY NO. 1265

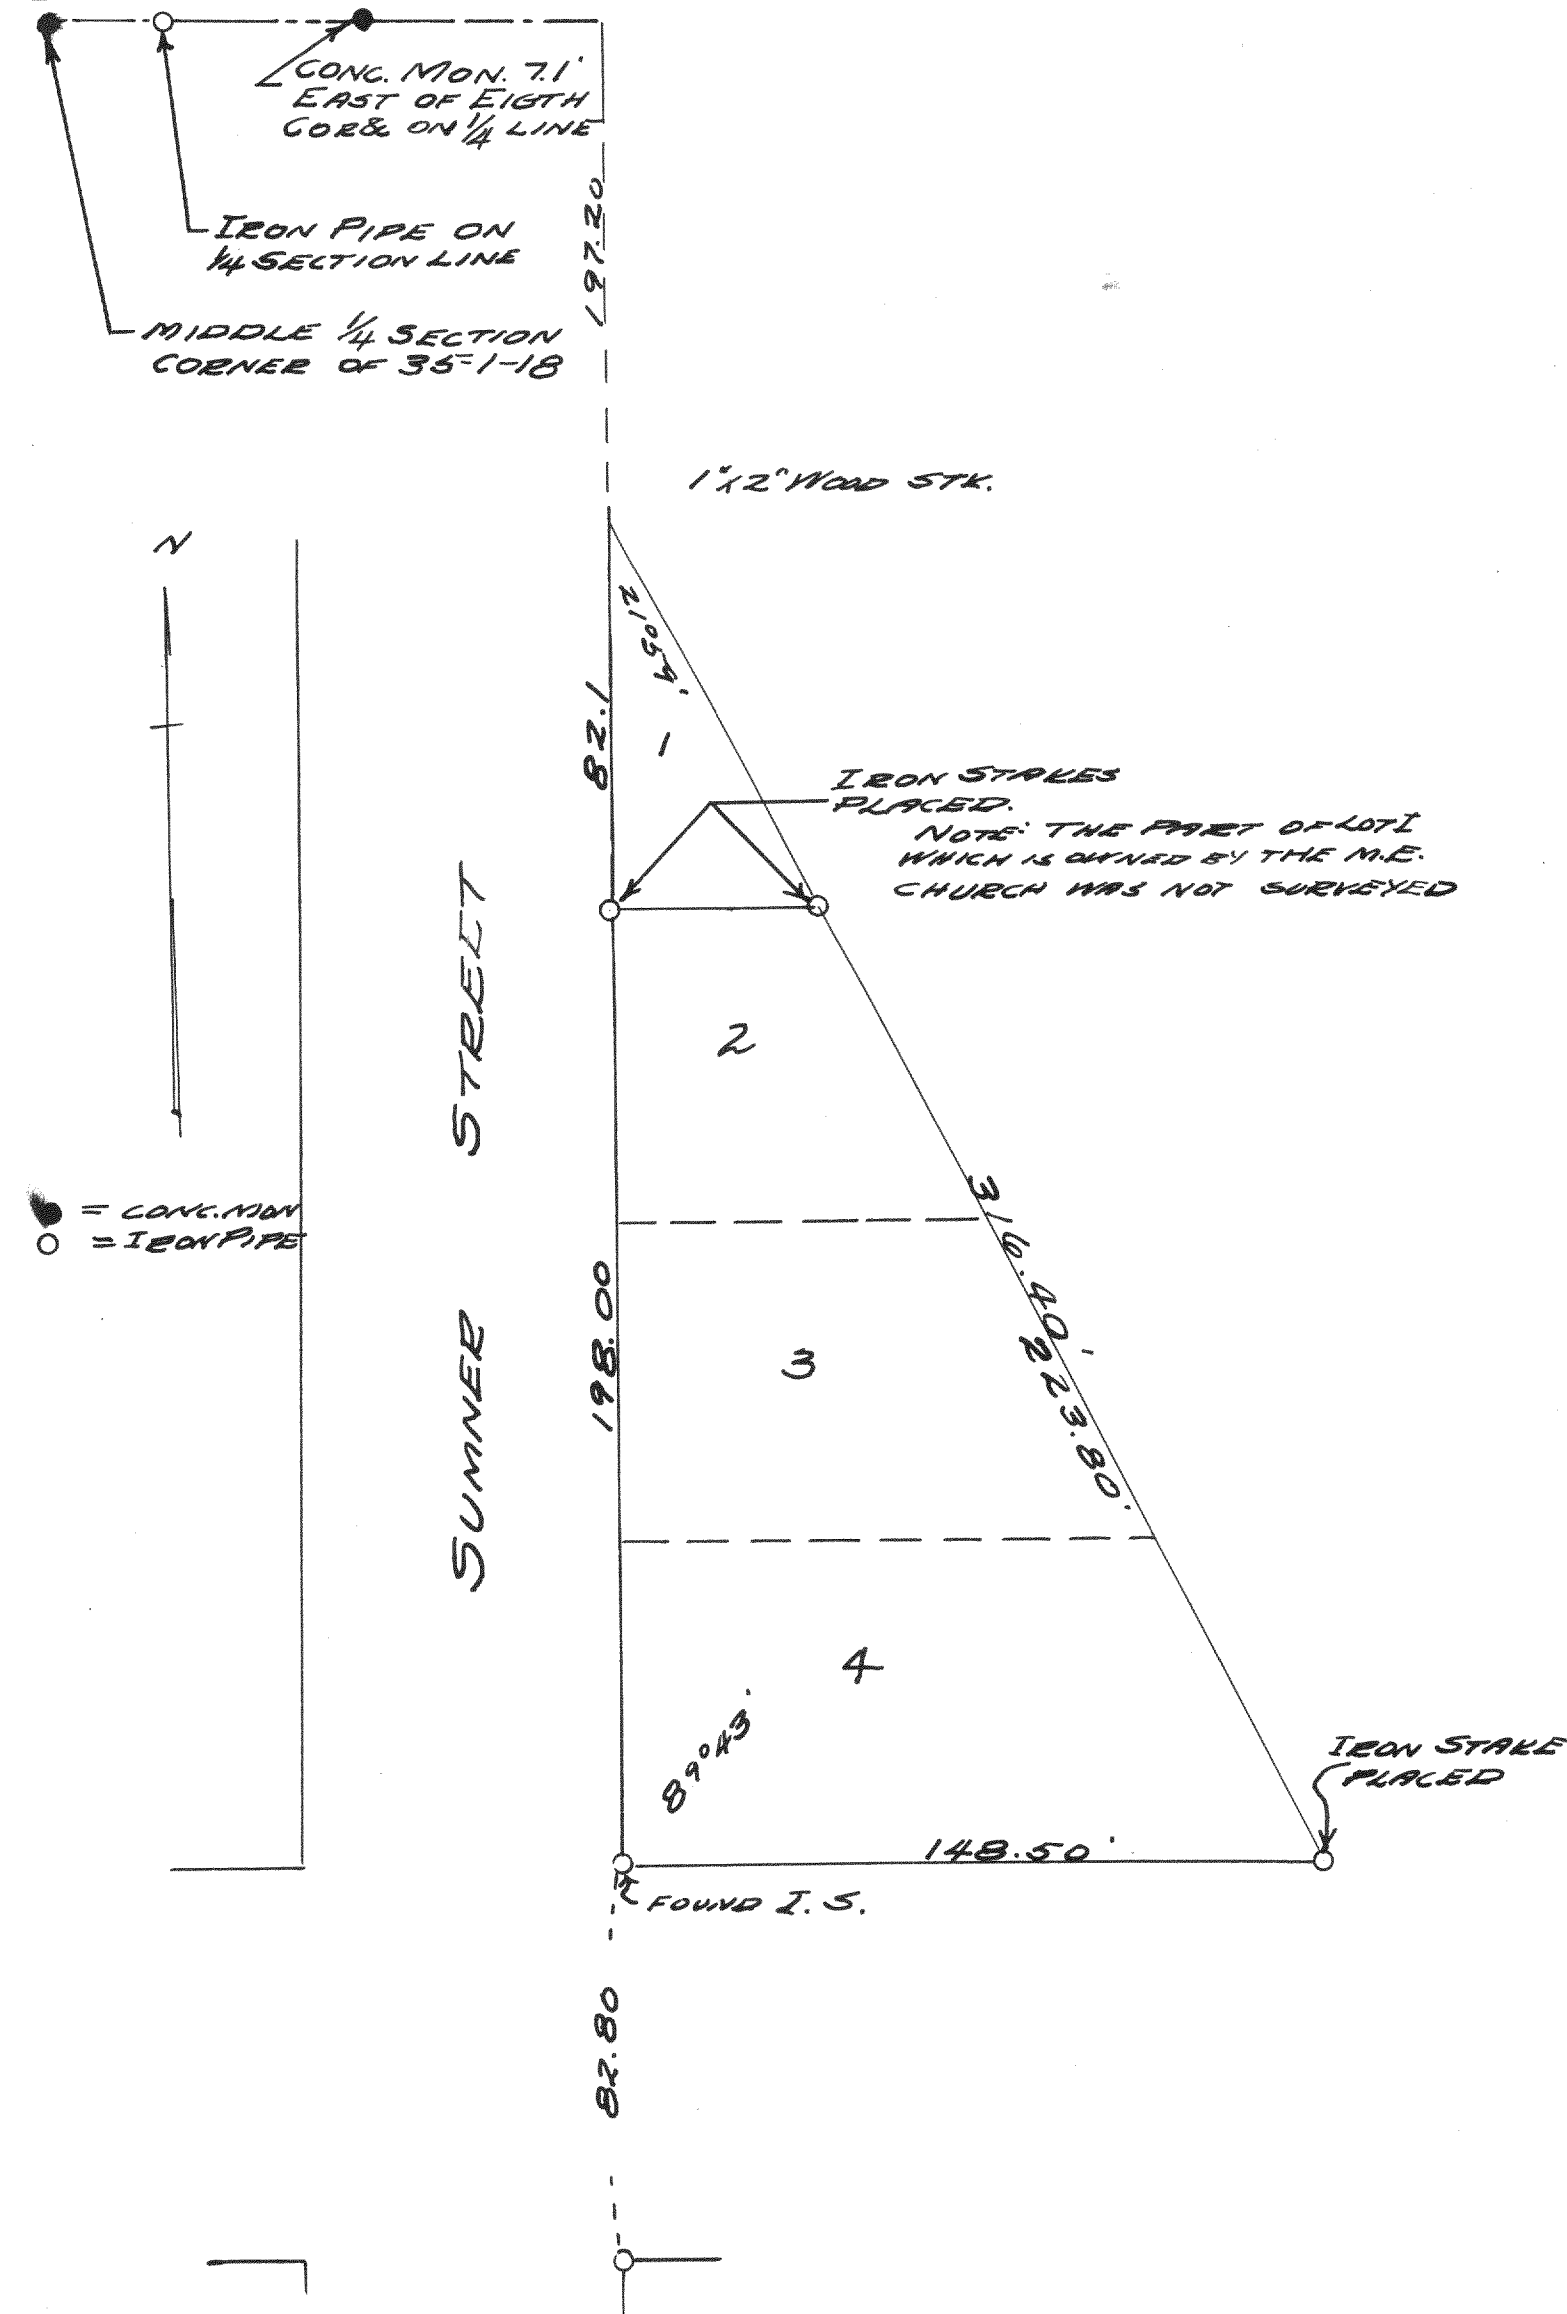

PLAT OF SURVEY OF LOTS 2, 3, & 4
OF BLOCK ONE OF FREEMAN'S 2ND
ADD. TO THE VILLAGE OF GENOA
MAY 22, 1941
Lloyd L. Jensen
N.E.J.

SURVEY NO. 1266

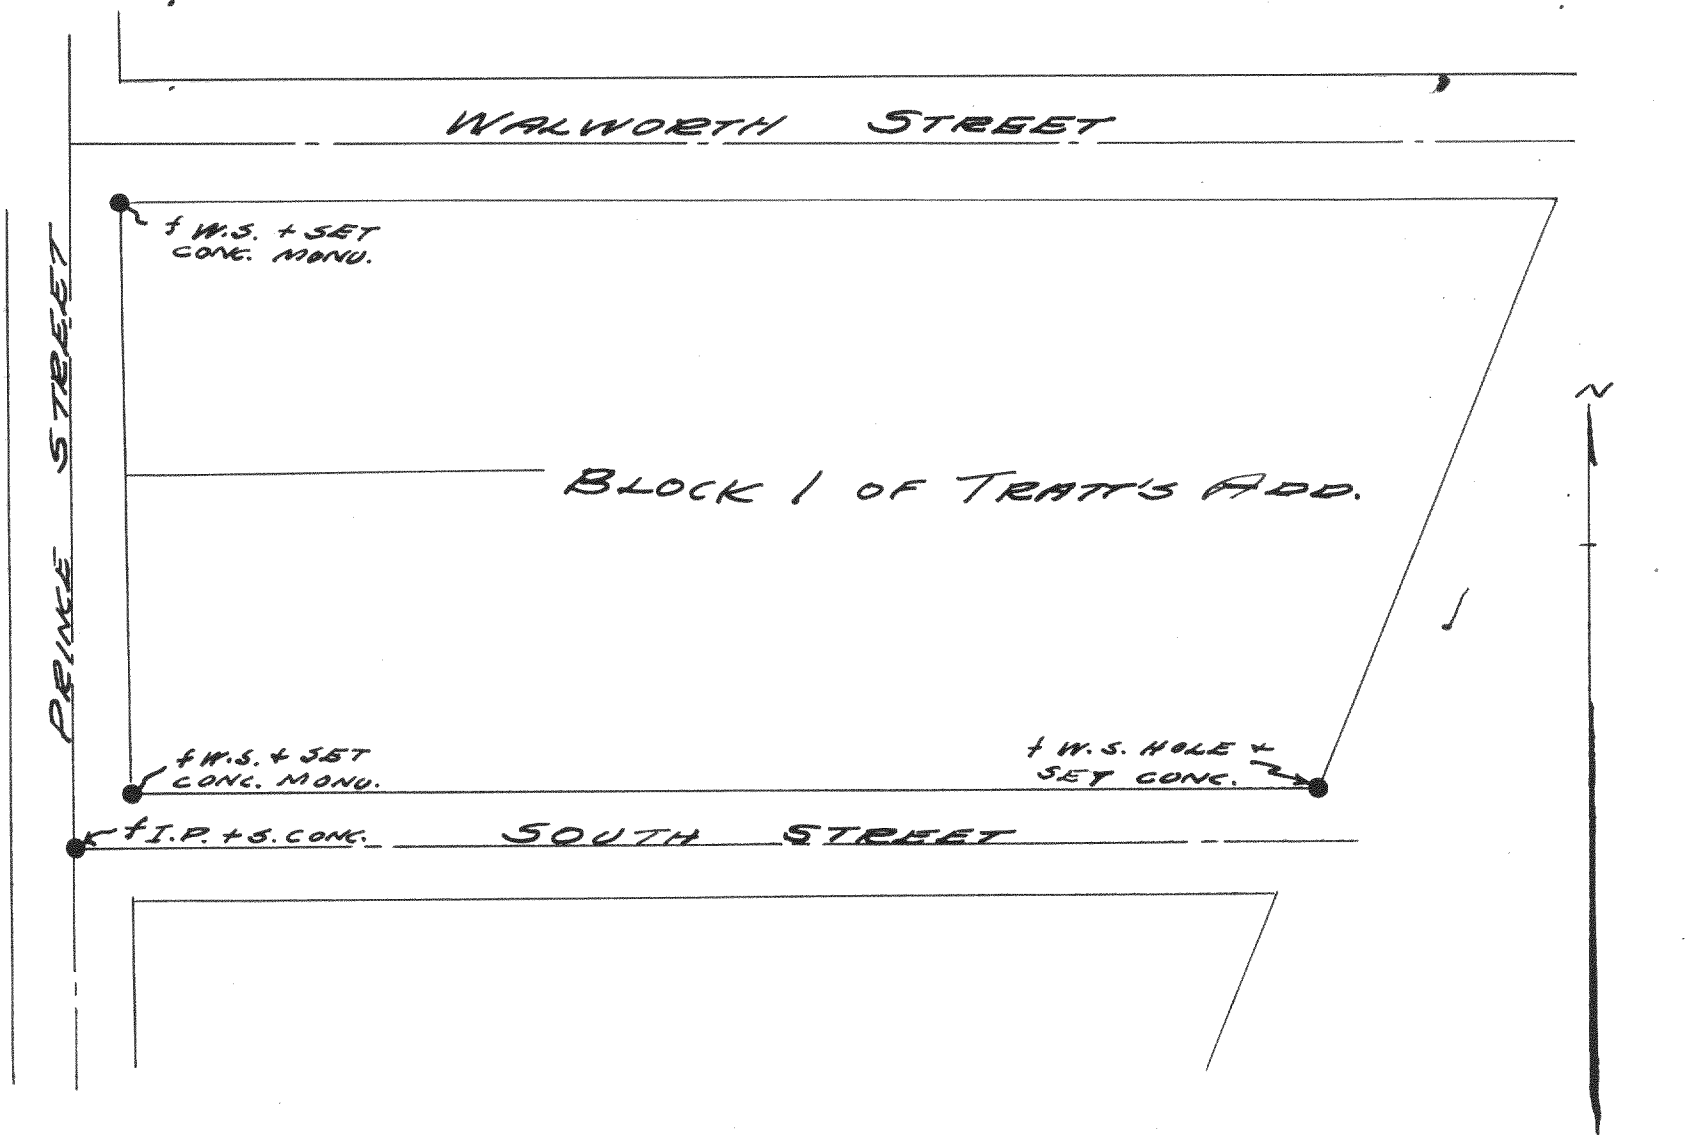

PLAT OF SURVEY TO LOCATE THE
BLOCK CORNERS OF BLOCK 1 OF TRATT'S
ADDITION TO THE CITY OF WHITEWATER,
WALWORTH COUNTY, WISCONSIN

DEC. 1941

Lloyd L. Jensen
N.E.J.