



2101

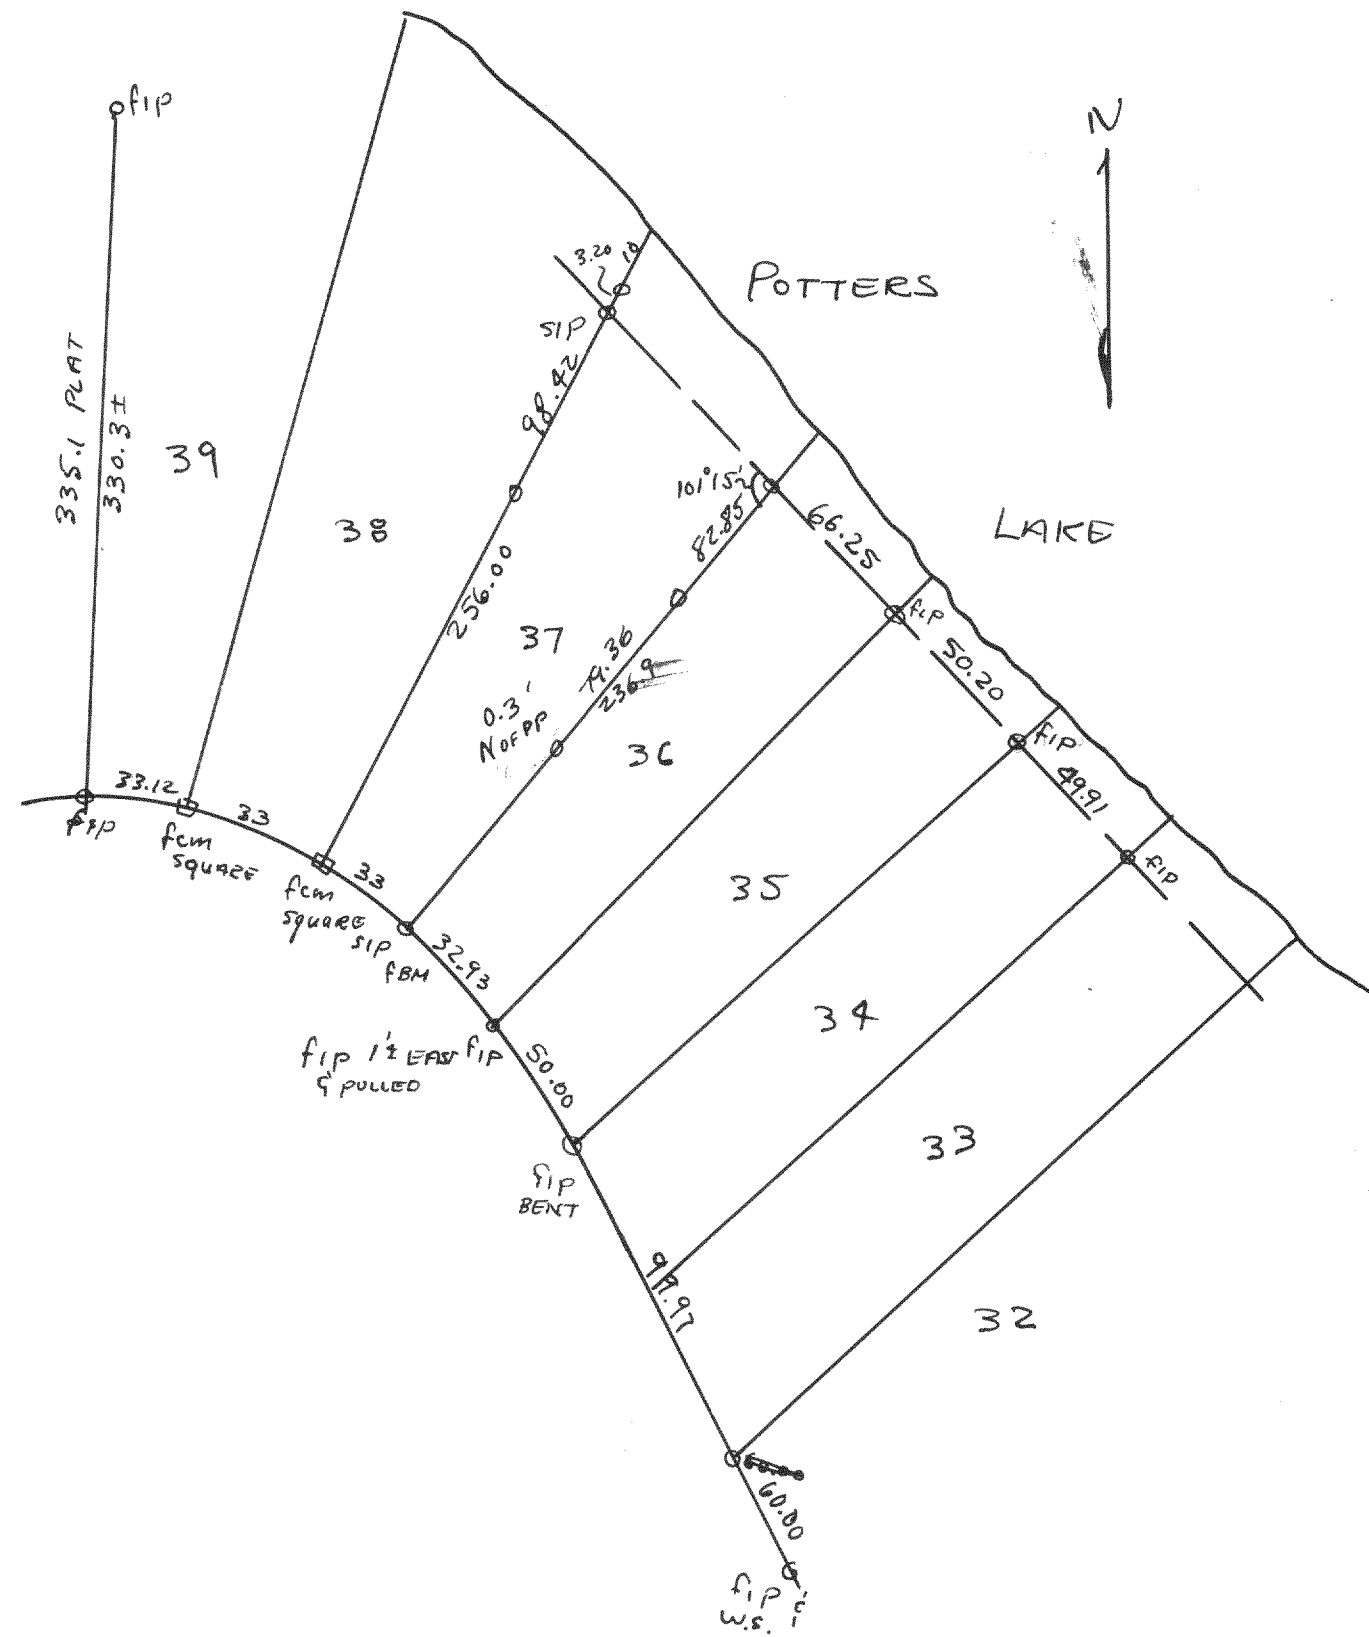

Plat of survey of lot 37 of Shorewood Subd of Potter's Lake located in Sec 10, 11, 14 & 15, T4N R18E, Walworth Co., Wis.
April 19, 1949
Lloyd L. Jensen
County Surveyor

2102

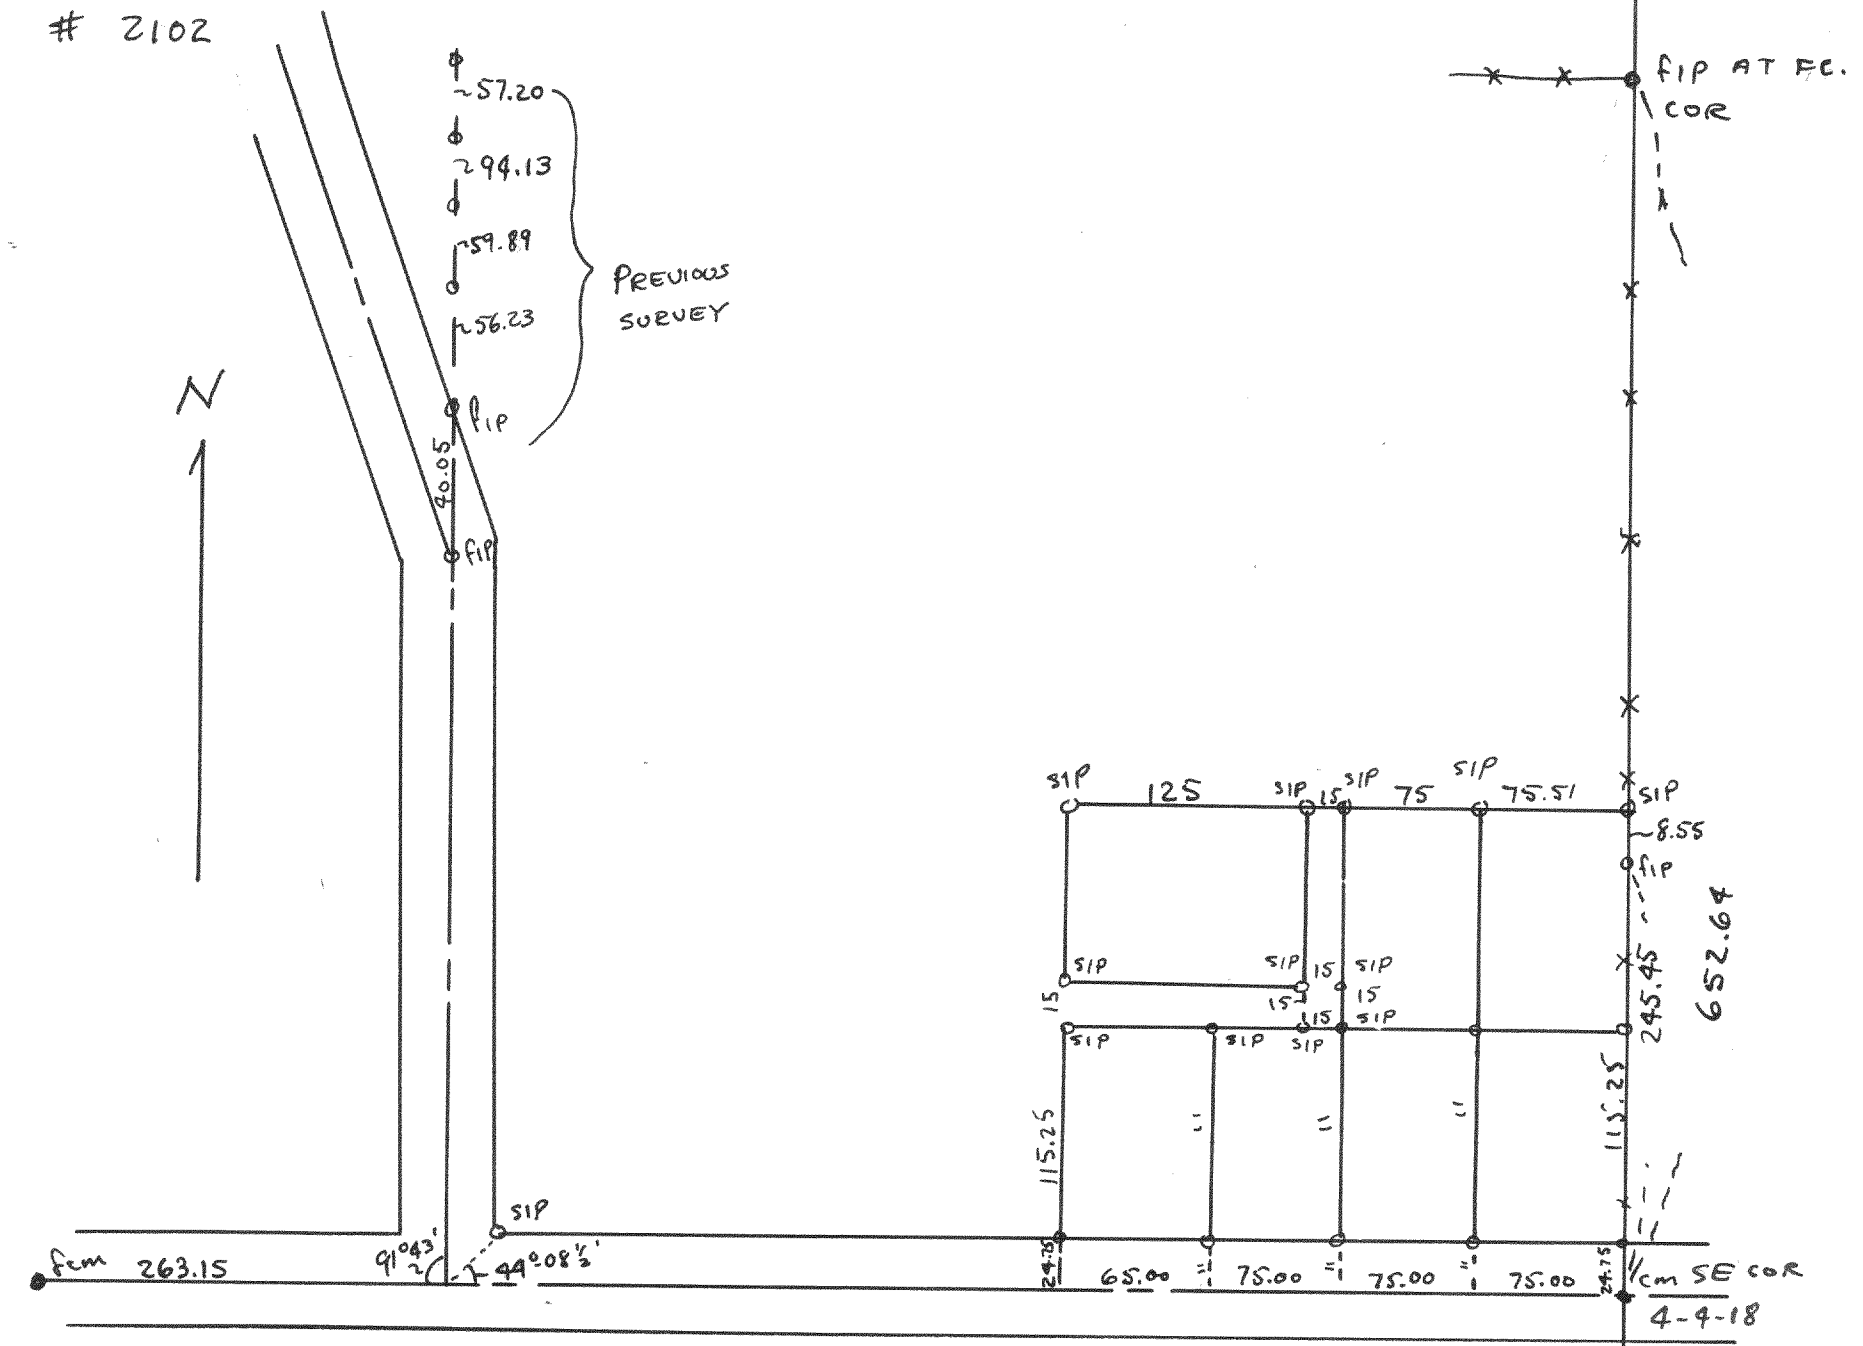

Plat of survey of a parcel of land located in the SE 1/4 of Sec 7 T4N R18E of Walworth County, Wis.
1949

Lloyd L. Jensen
County Surveyor