



2112

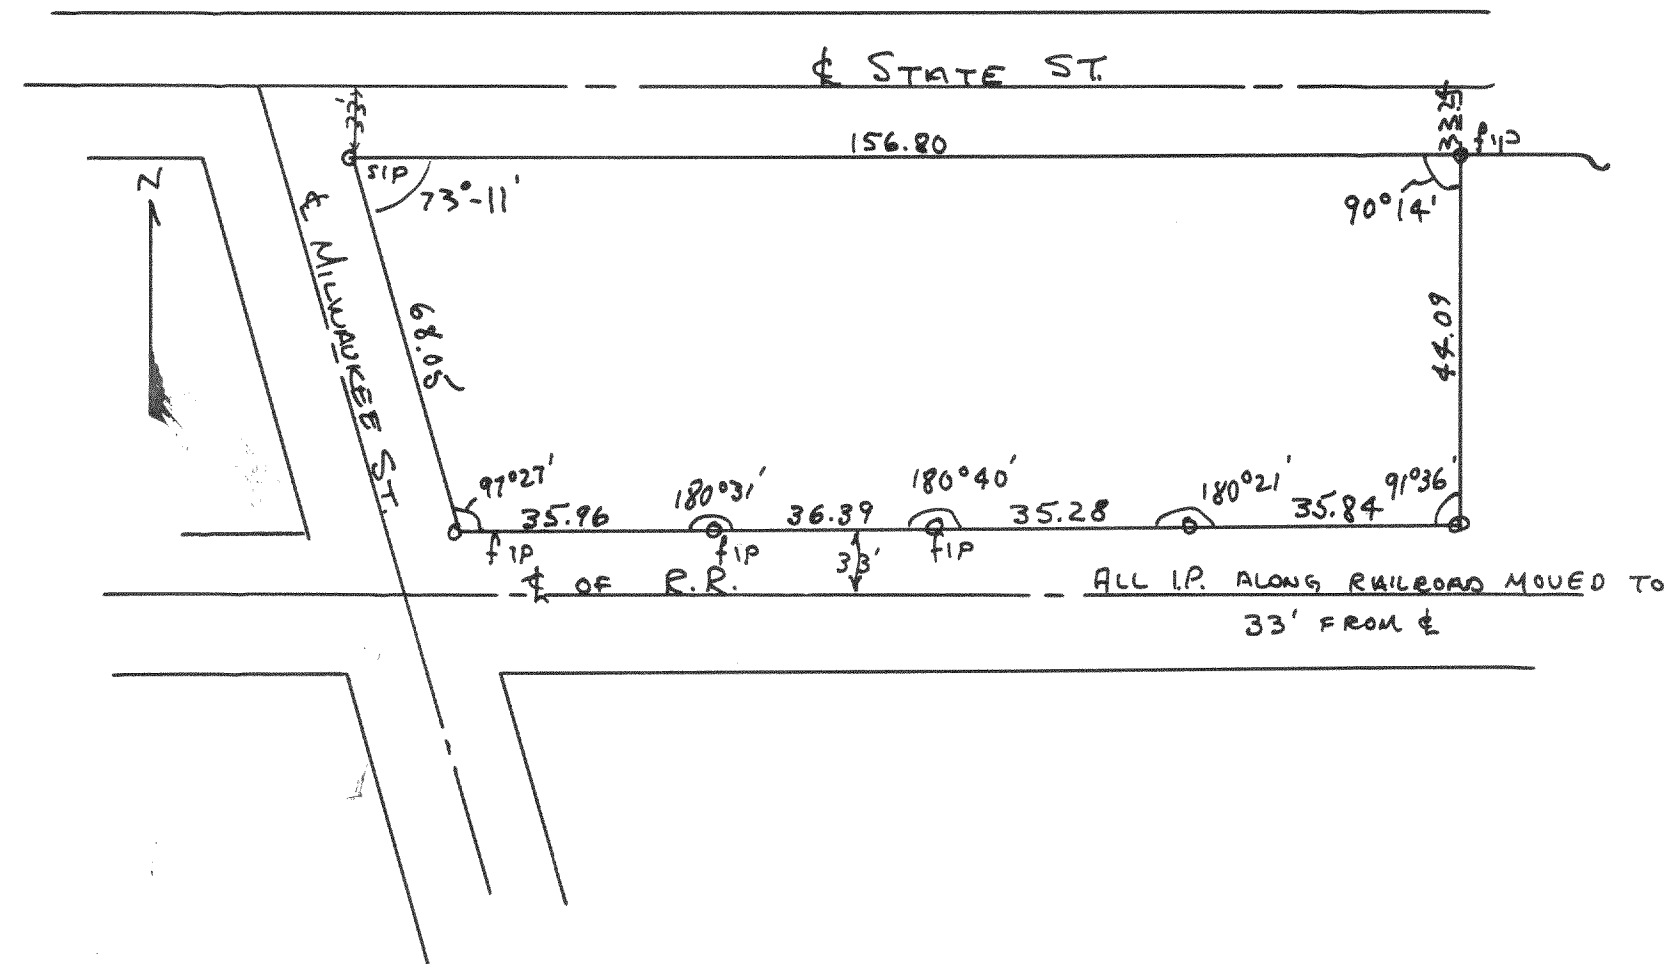


Plat of survey of a parcel of land located at the intersection of
State & Milwaukee Sts in the City of Whitewater, Walworth Co., Wis.
May 19, 1949
Lloyd L. Jensen
County Surveyor

#2113

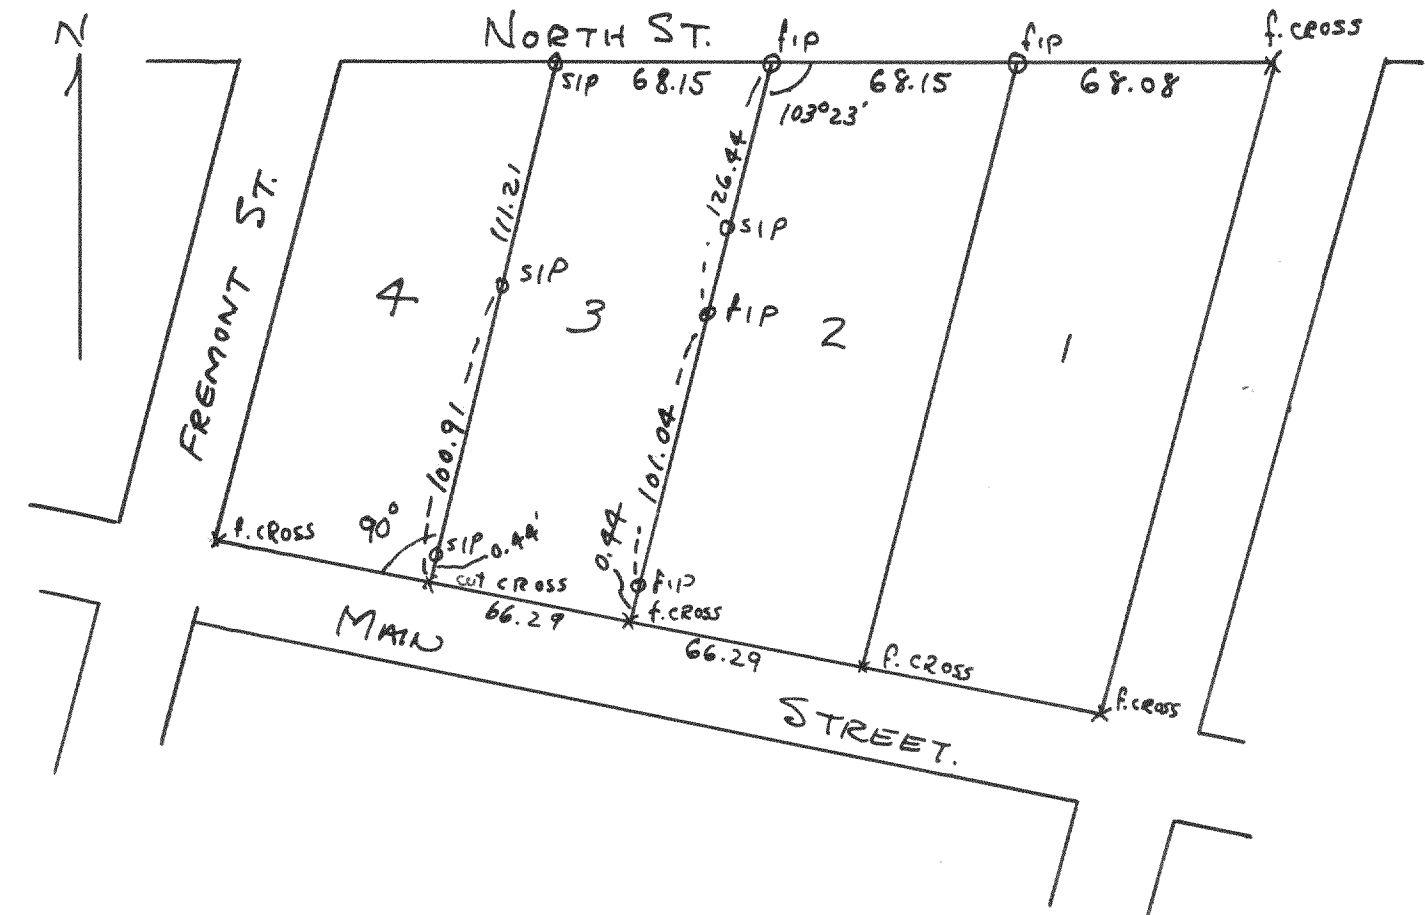


Plat of survey of lot 3 Block 3 of the Original Plat
of the City of Whitewater, Walworth Co., Wis.
Dec 22, 1949
Lloyd L. Jensen
County Surveyor

#2114

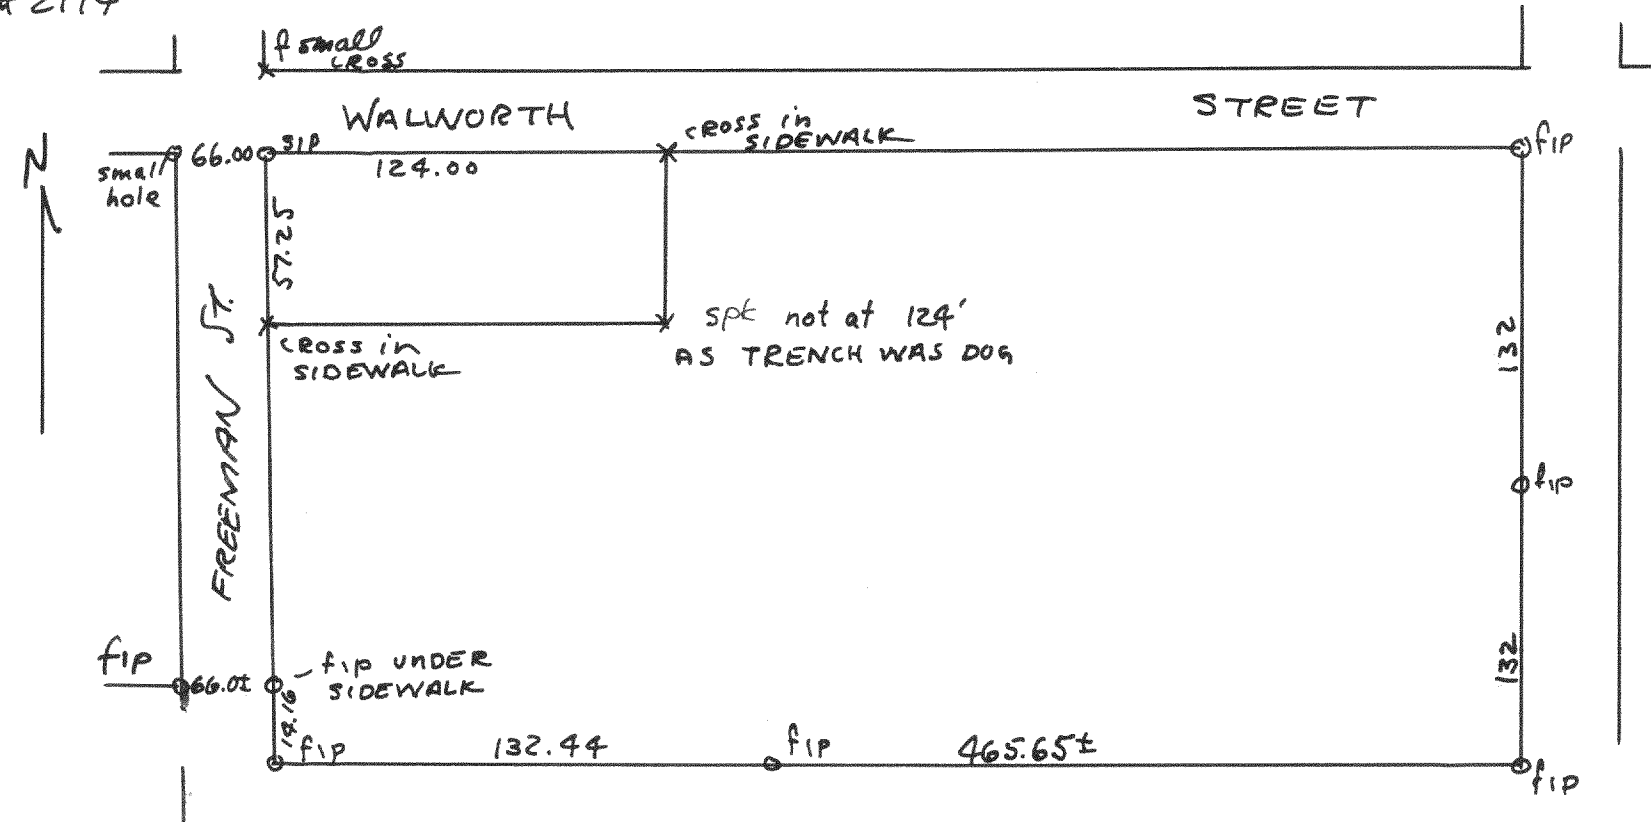

Plat of survey of part of lot 1 of Original Town located in the
Village of Aurora City, Walworth Co., Wis.
July 28, 1949
Lloyd L. Jensen
County Surveyor

#2115

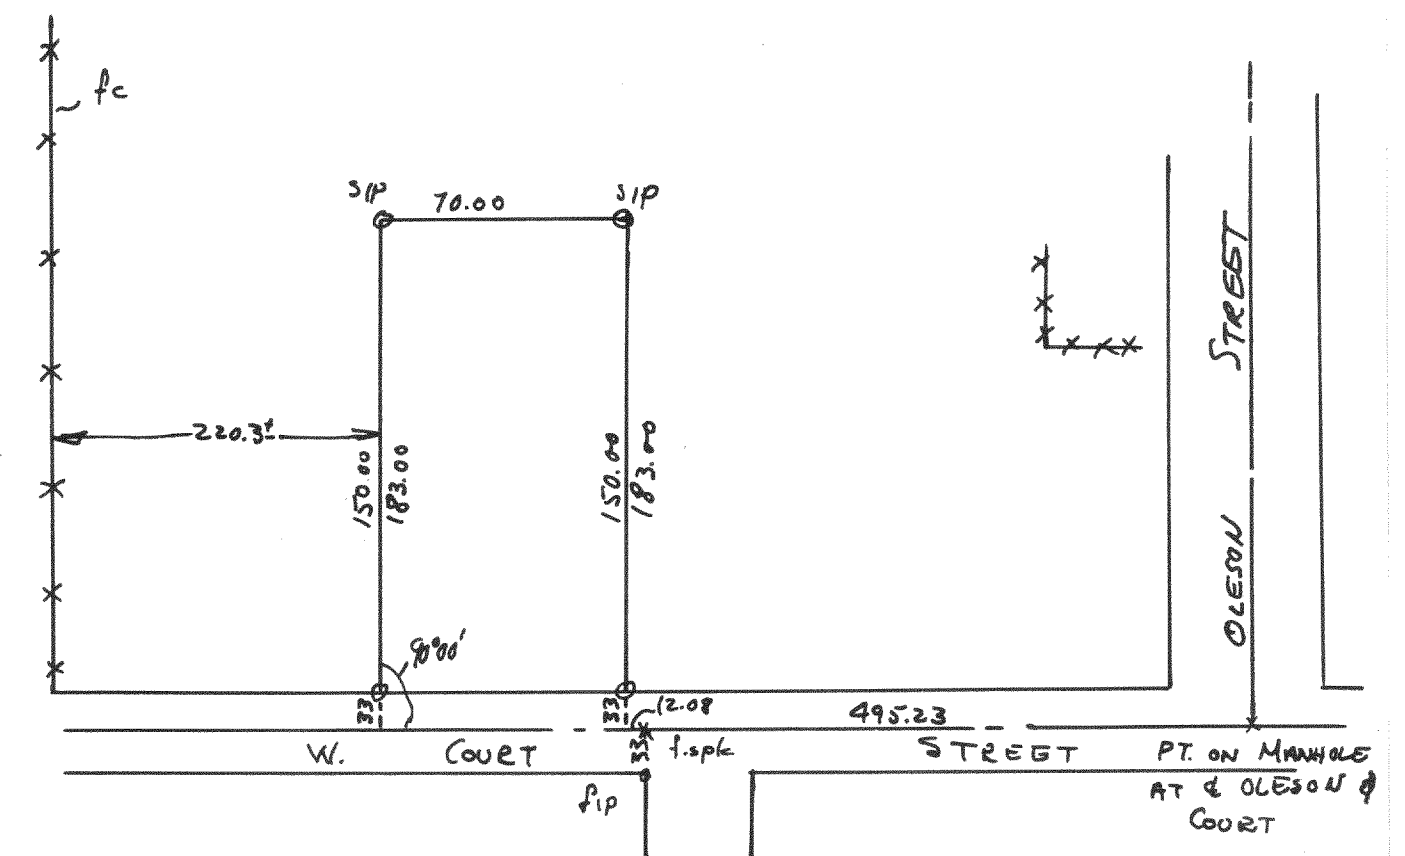

Plat of survey of parcel of land located on W. Court Street in the
City of Oshkosh, Walworth Co., Wis.
June 11, 1949
Lloyd L. Jensen
County Surveyor