



2118

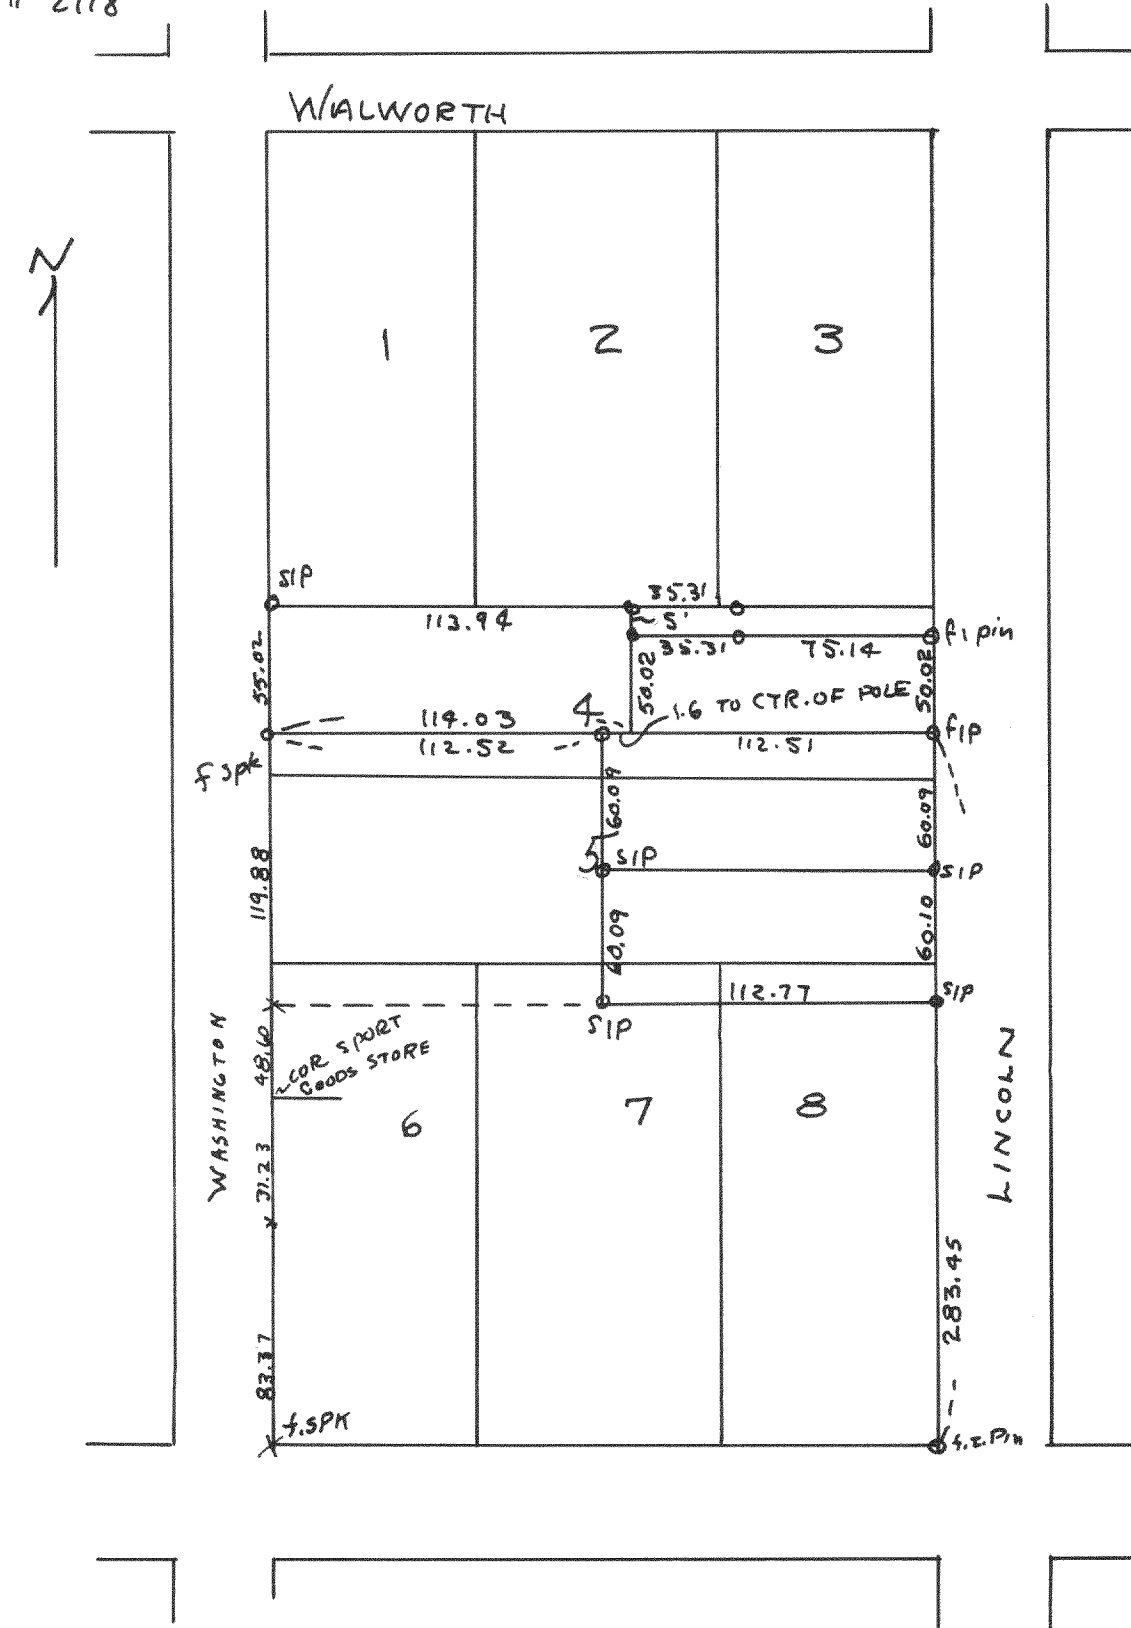

Plat of survey of part of lots 4, 5, 7 & 8 Block 24
of Original Plat. City of Elkhorn Nebraska County
1949 Lloyd L Jensen ~~Sec~~
County Surveyor

2110

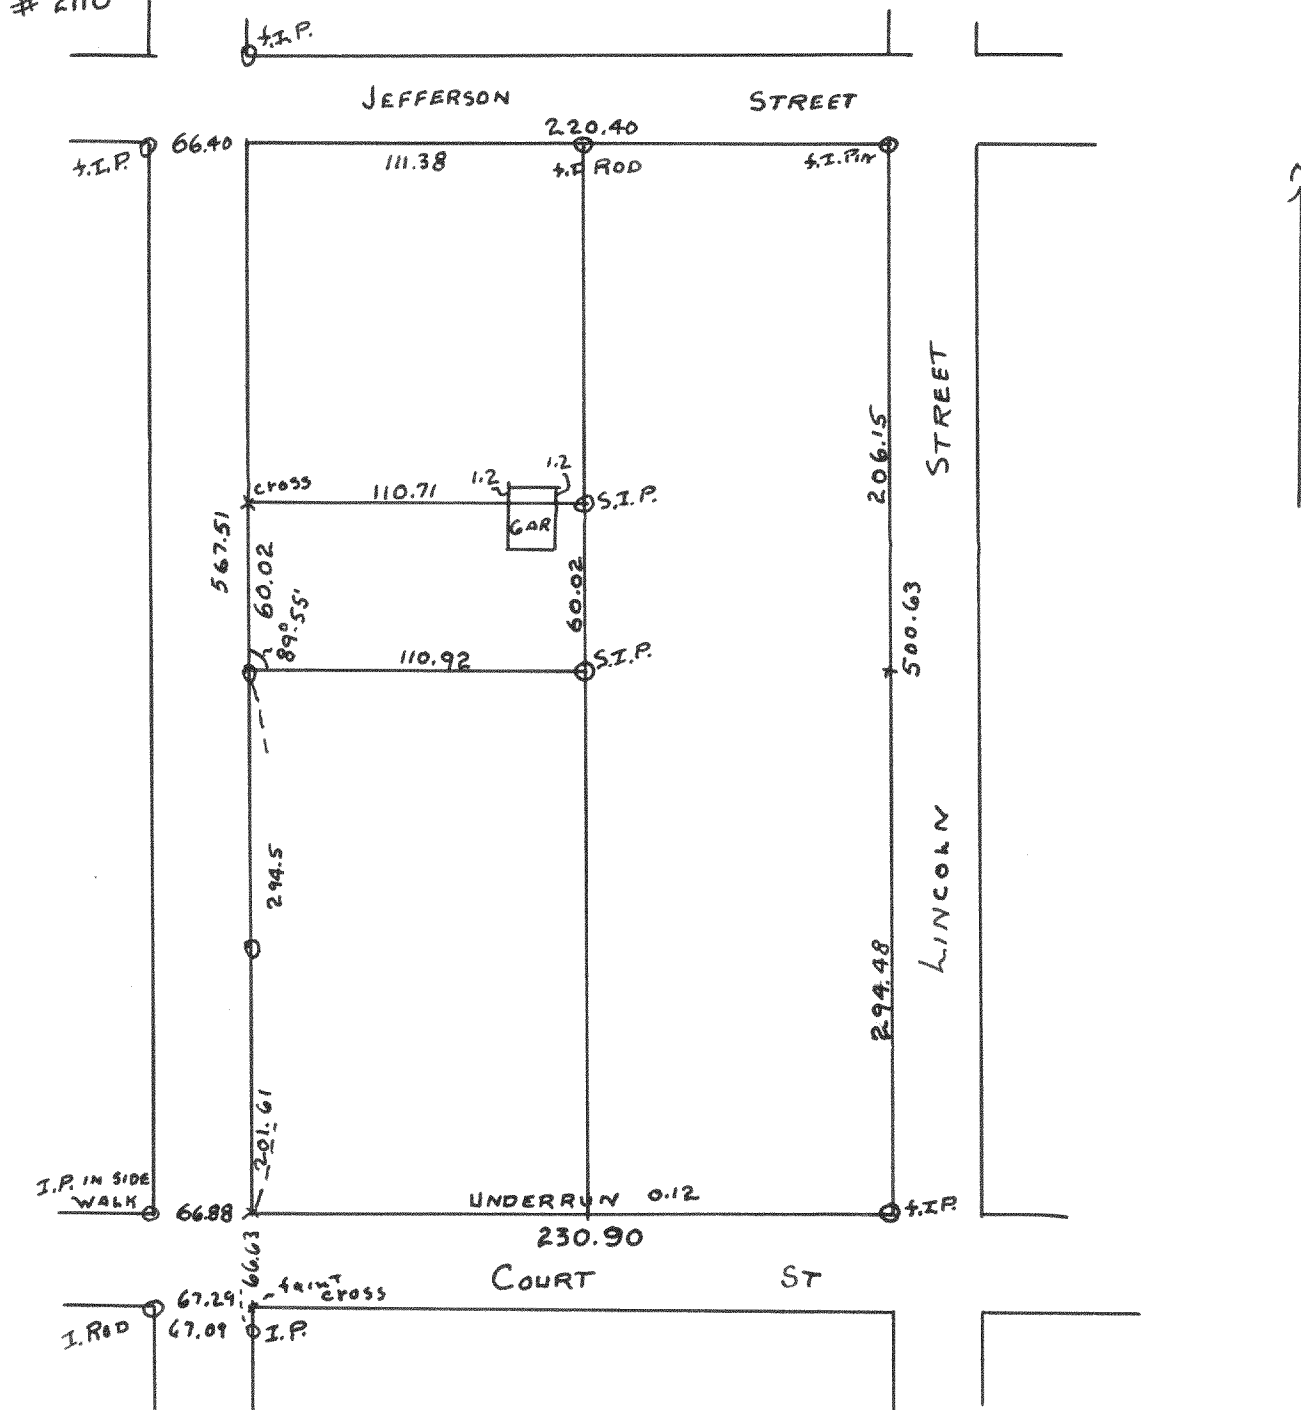

Plat of survey of parts of lots 3, 3, & 4 Block 14 of the
Original Plat of the City of Elkhorn Malworth County
April 13, 1949
Lloyd Jensen *LS*
County Surveyor