



460

2120

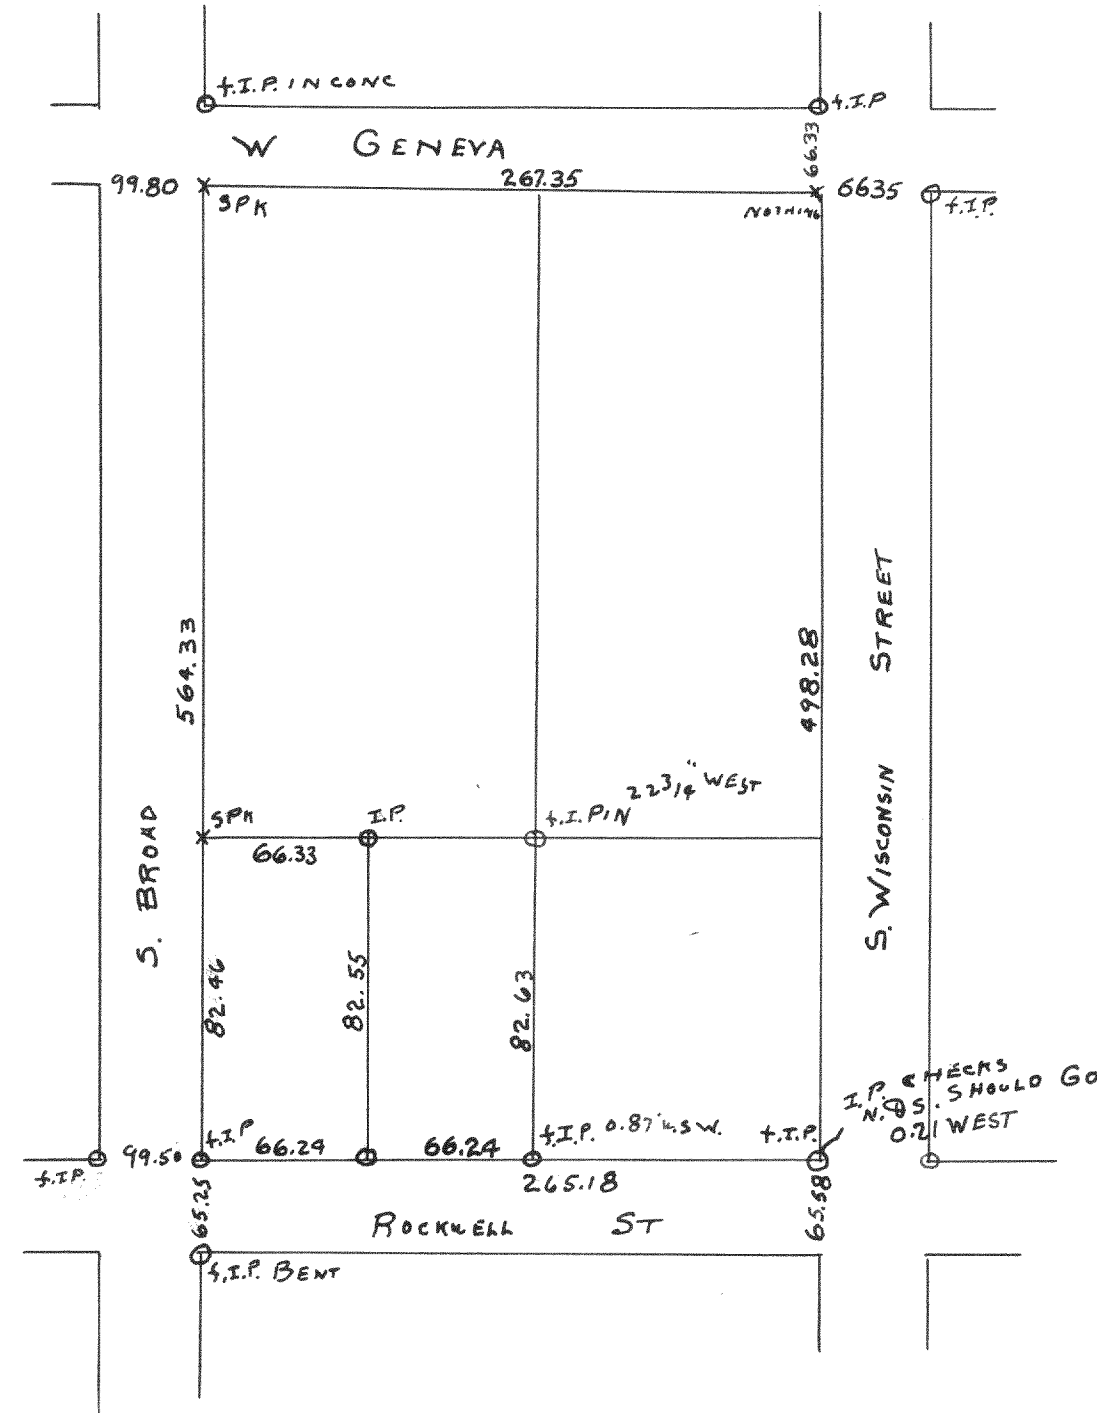

Plot of survey of E 1/2 lot 11 Block 31 in the
City of Elkhorn, Walworth County
April 13, 1949
Floyd S. Jensen *sd*
County Surveyor

2121

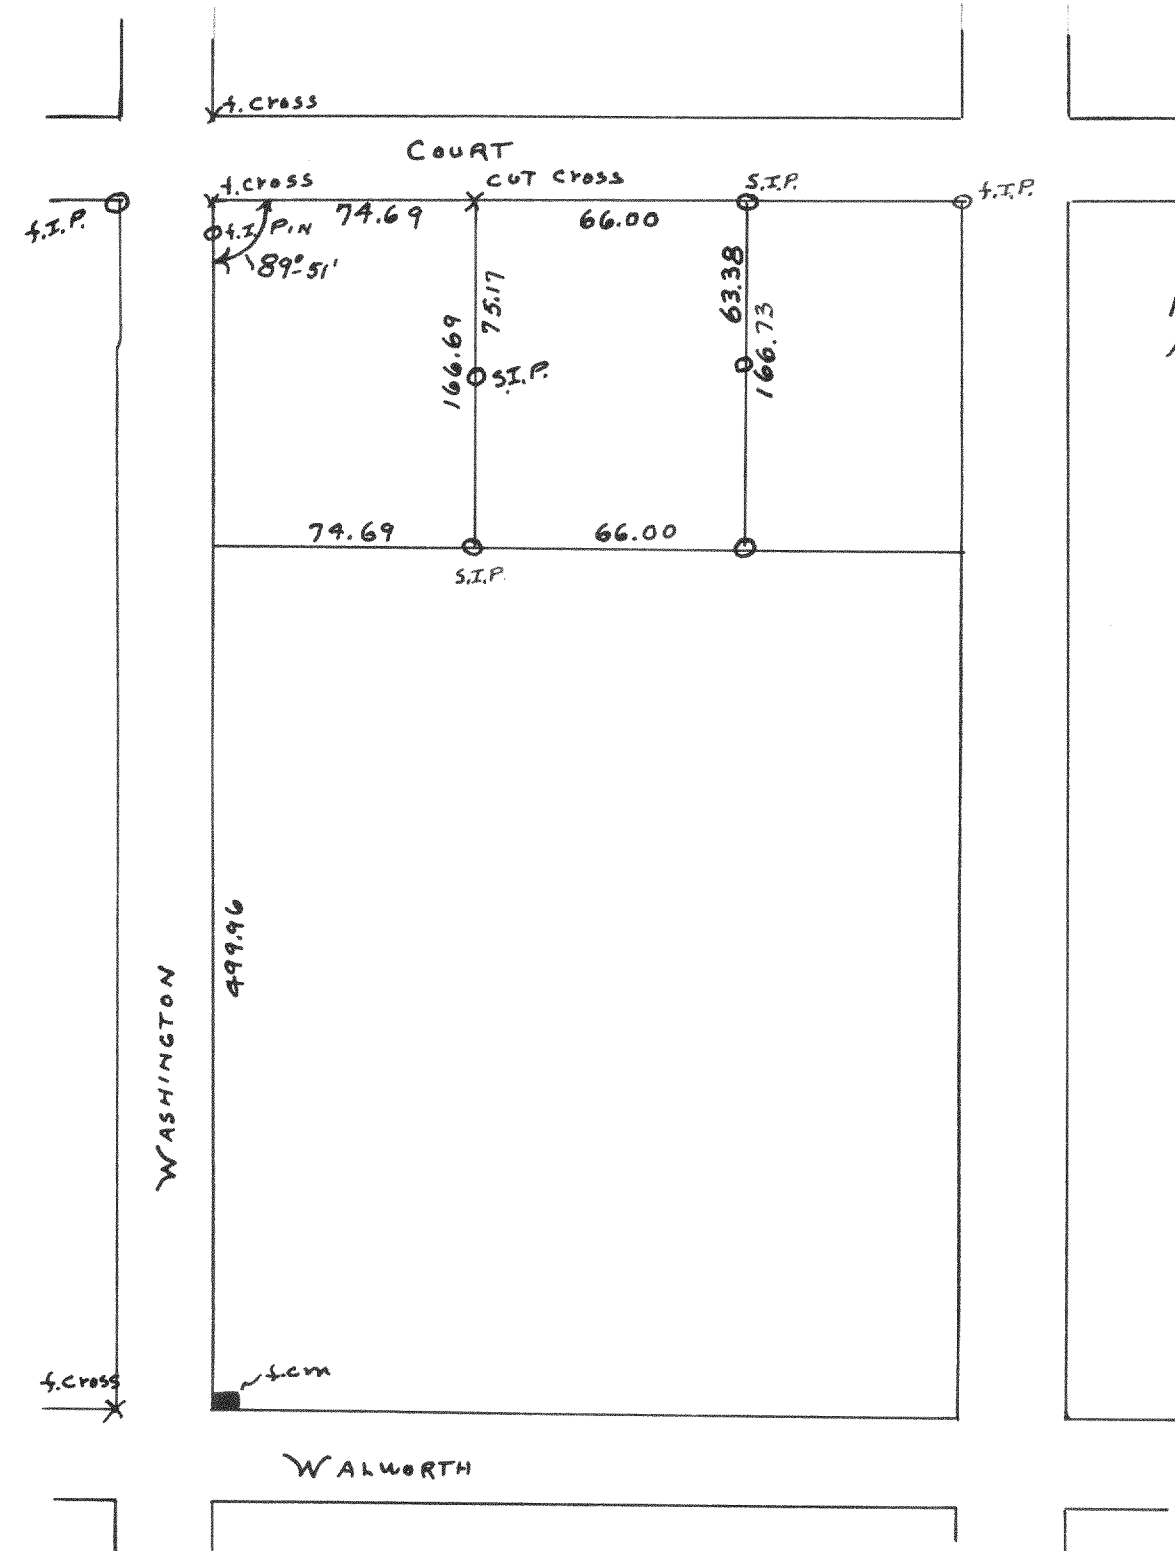

Plot of survey of part of lot 2 Block 21 in the
City of Elkhorn, Walworth County
June 10, 1949
L. L. Jensen *sd*
County Surveyor