



2124

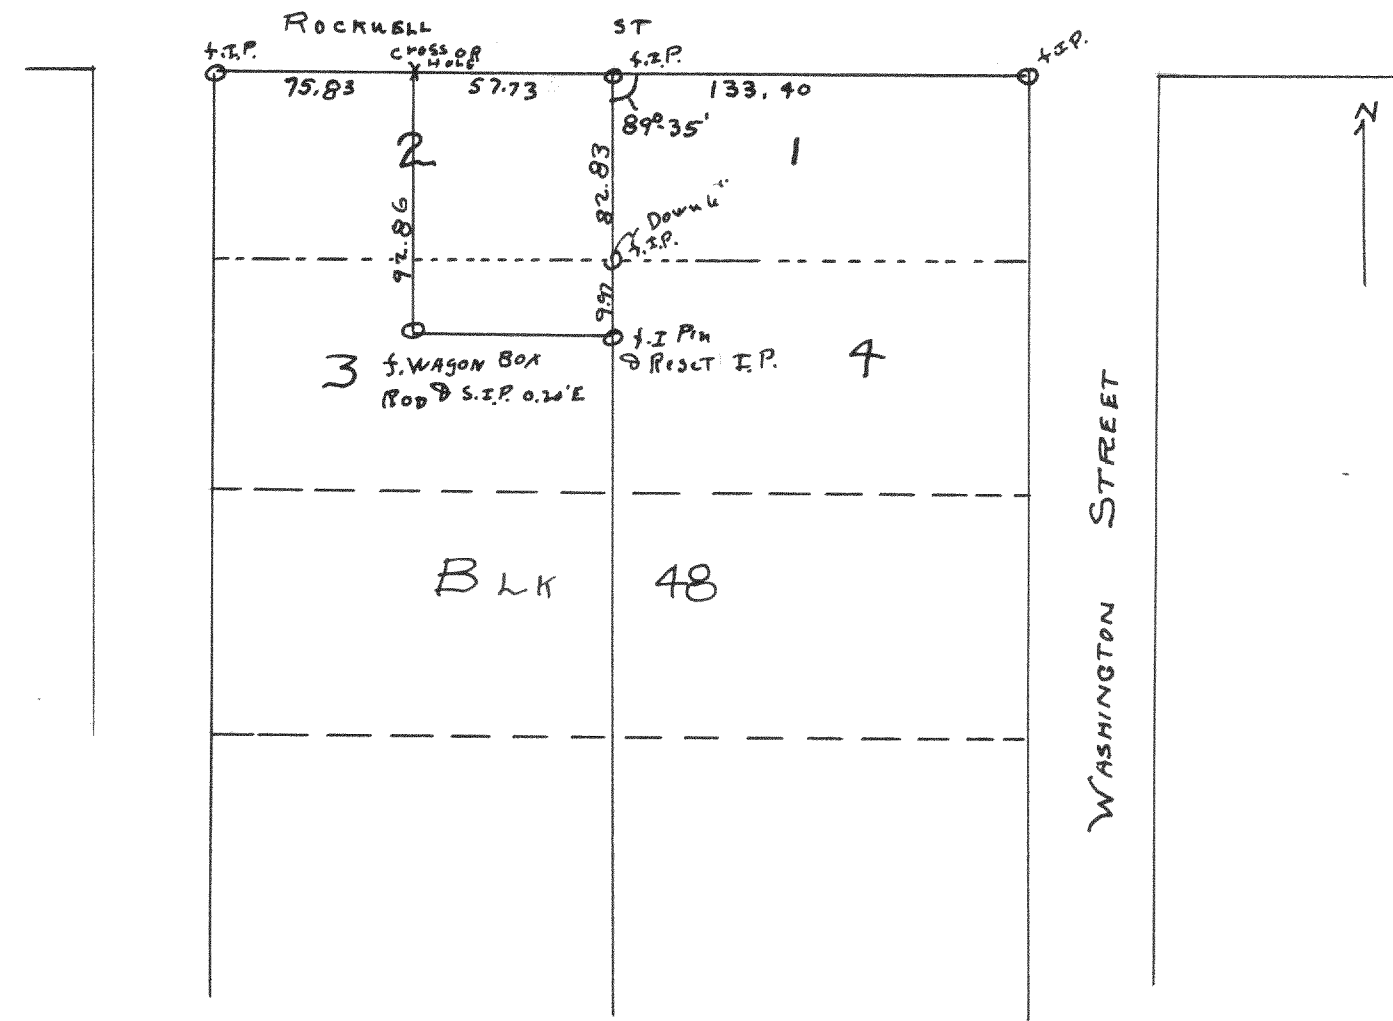

Plot of survey of part of lots 203 of Blk 48 in
Rockwell; 2nd addition in City of Elkhorn
Oct 18, 1999
Floyd Jensen


Floyd L Jensen RD
County Surveyor

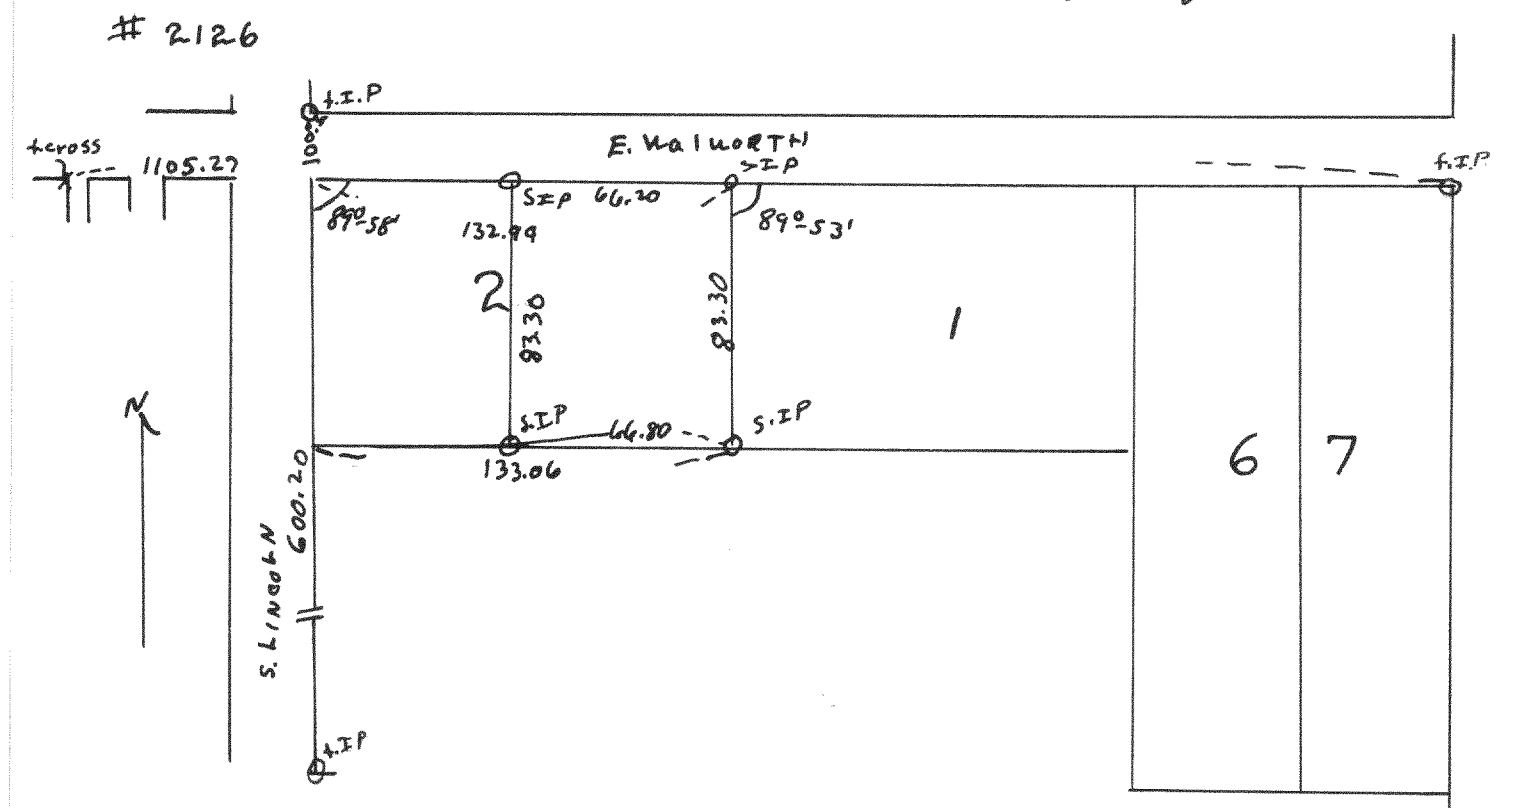

Plot of survey of the eastern part of lot 2 of Block 23 Rockwell's
addition - city of Elkhorn, Walworth County
Dec 3, 1949
Hoyt Jensen sds

Lloyd Jensen ad
County Surveyor


2125

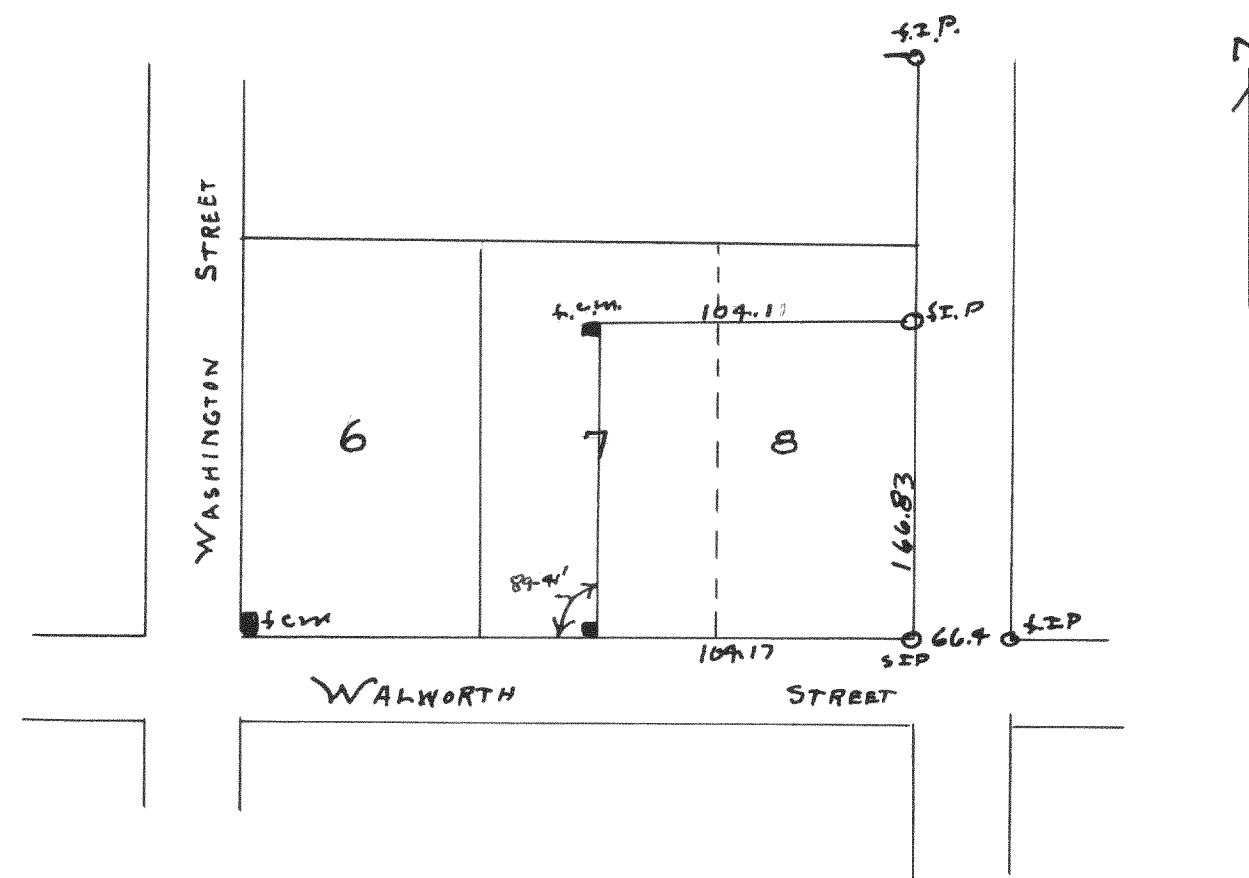

Plot of survey of part of lots 7 and 8 of Block 21 Original
Plot in the city of Elkhorn
1999 Lloyd Jensen *sd*

Lloyd Jensen Sec
County Surveyor

2127

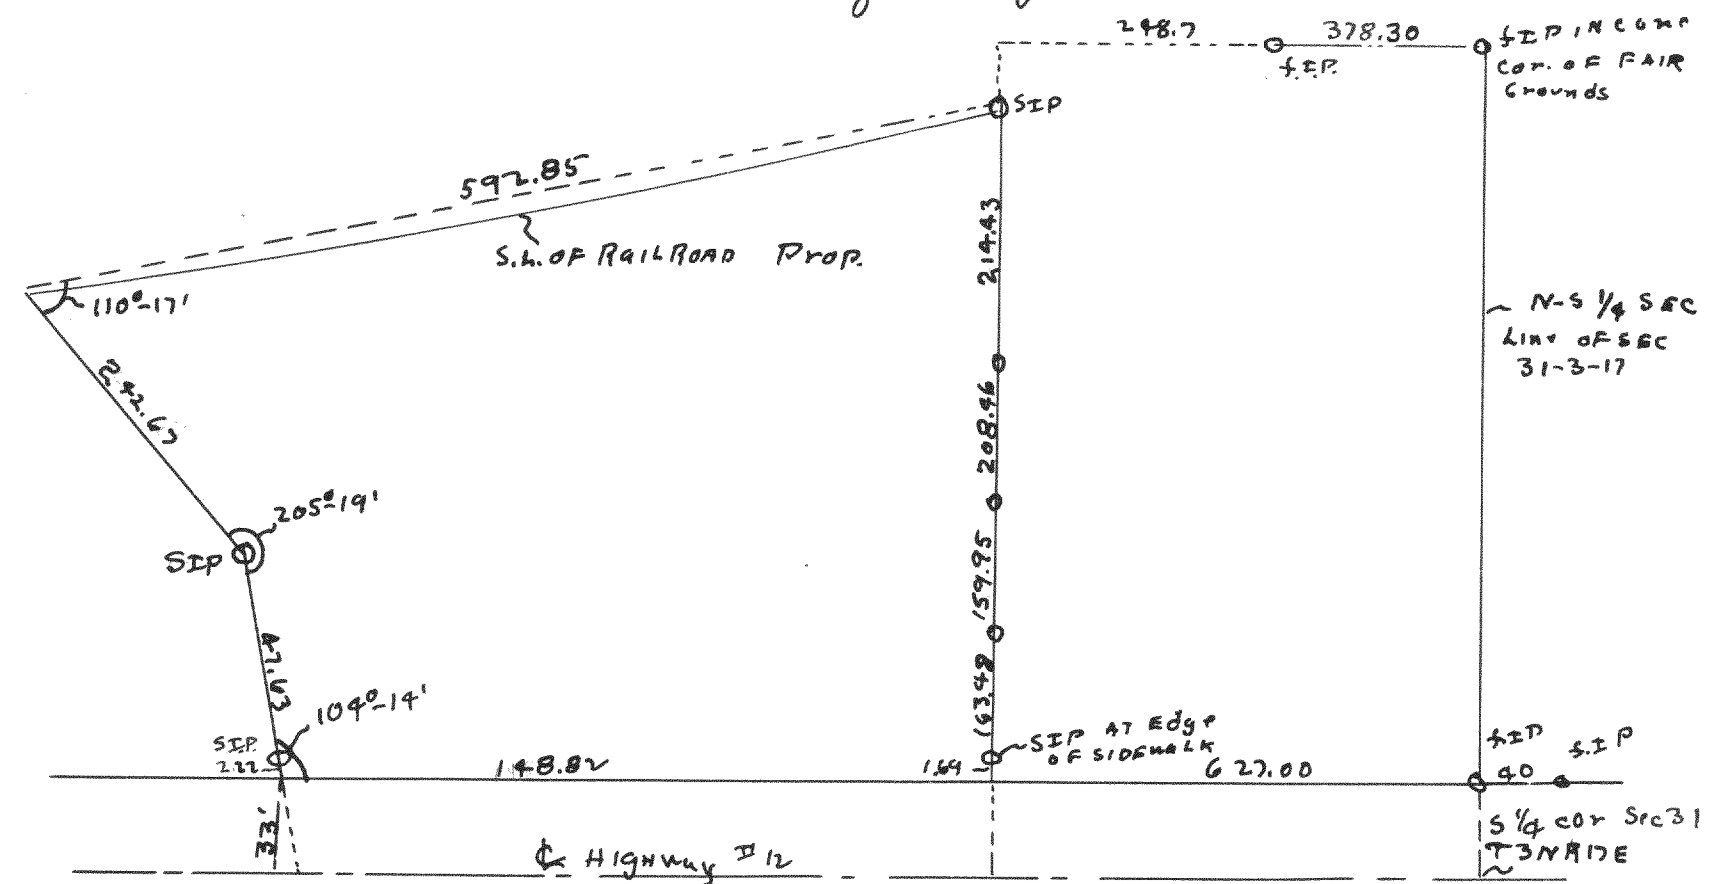

Plot of survey of a parcel of land located in the S $\frac{1}{4}$ of
Section 31 T3N R17E Malheur County
Dec 9, 1999 Lloyd L. Jensen

Lloyd L Jensen Esq
County Surveyor