



2142

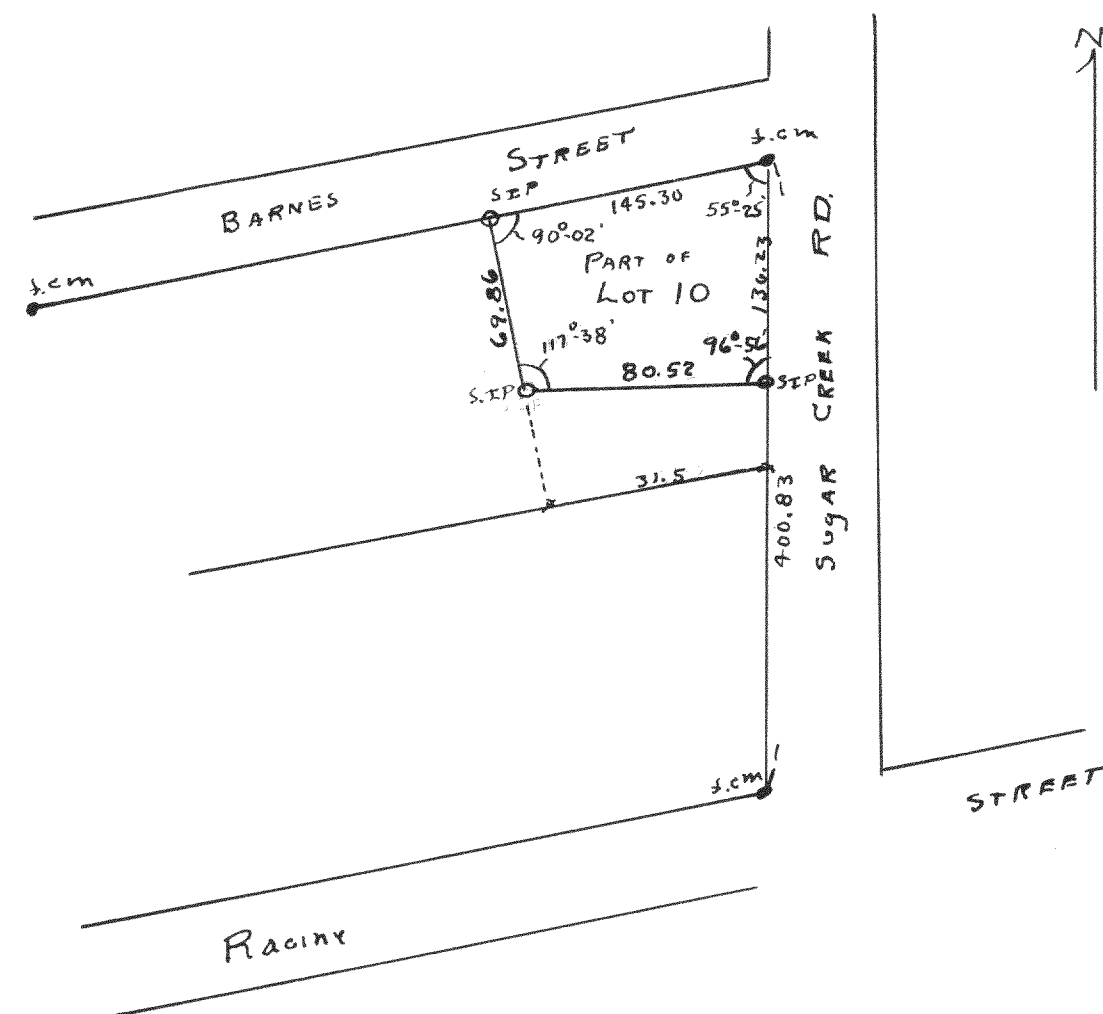


Plot of survey of part of lot 10 Block 4 of
Elmhurst Addition City of Delavan, Walworth County
April 11, 1949
Lloyd S Jensen *SD*
County Surveyor

2143

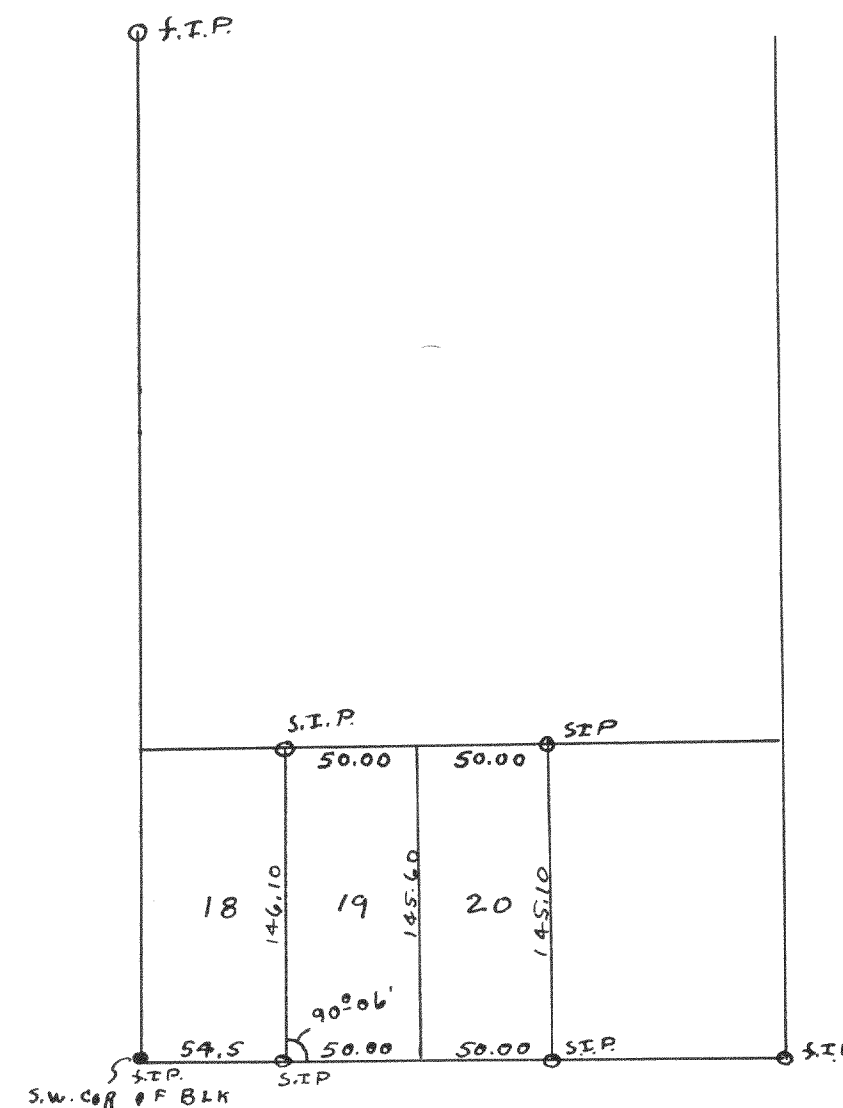


Plot of survey of lots 19 & 20 Block one of Starks Subdivision
of Williams Bay, Walworth County
Oct 12, 1948
Lloyd S Jensen *SD*
County Surveyor

2144

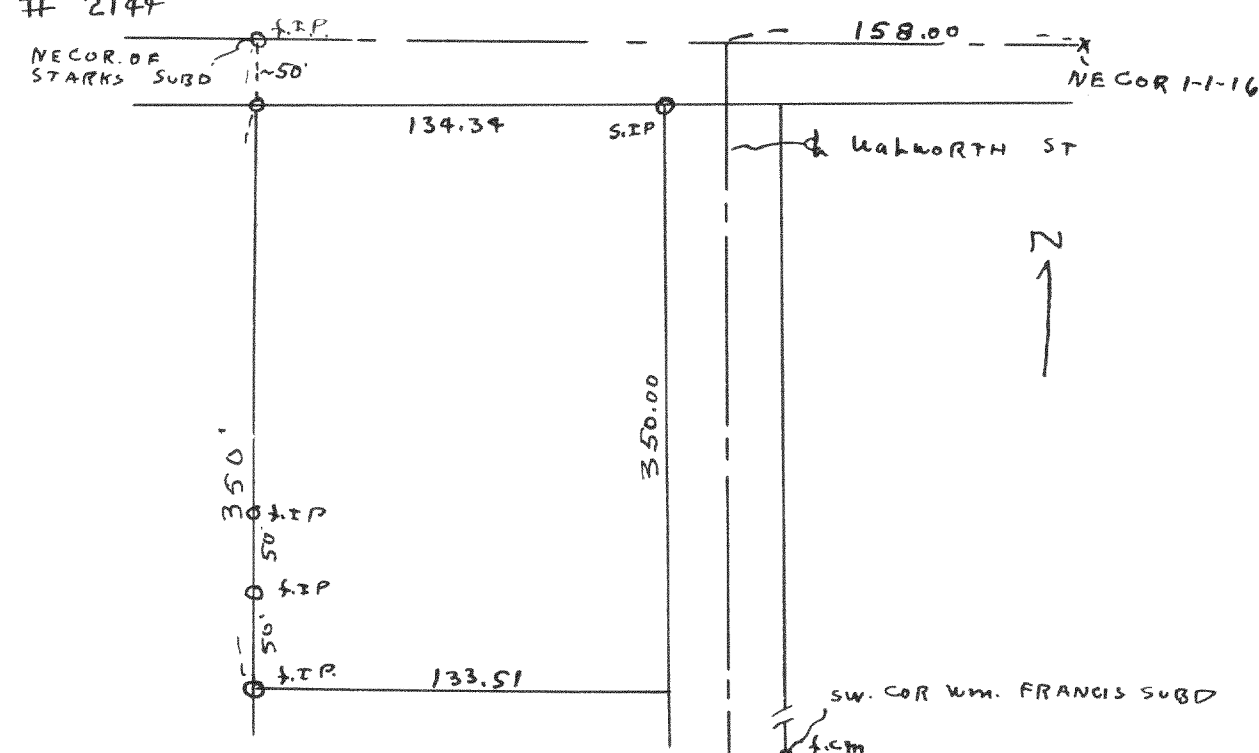

Plot of survey of a parcel of land located in the Northeast 1/4
of Section 1 T1N R16E and the Village of Williams Bay, Walworth Co
1948
Lloyd S Jensen *SD*
County Surveyor

2145

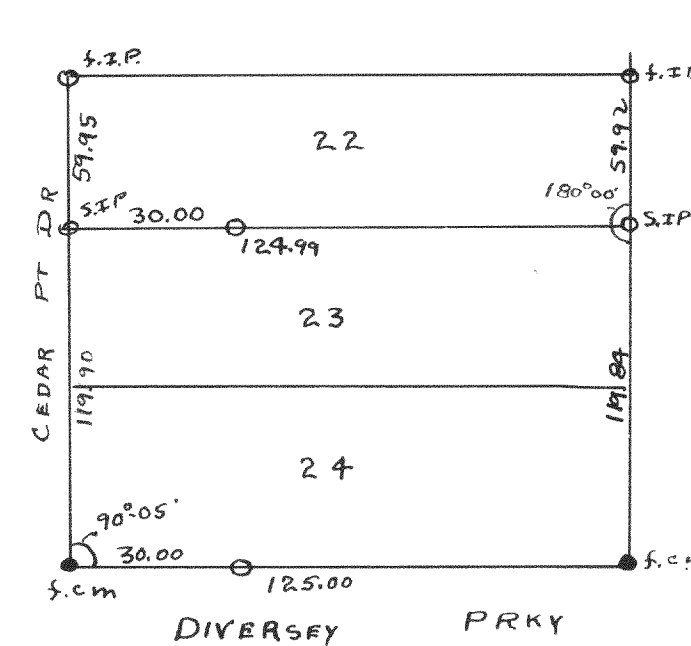

Plot of survey of lots 23 & 24 Cedar Point Park Original Subdivision, Village
of Williams Bay, Walworth County
Feb. 1949
Lloyd S Jensen *SD*
County Surveyor