



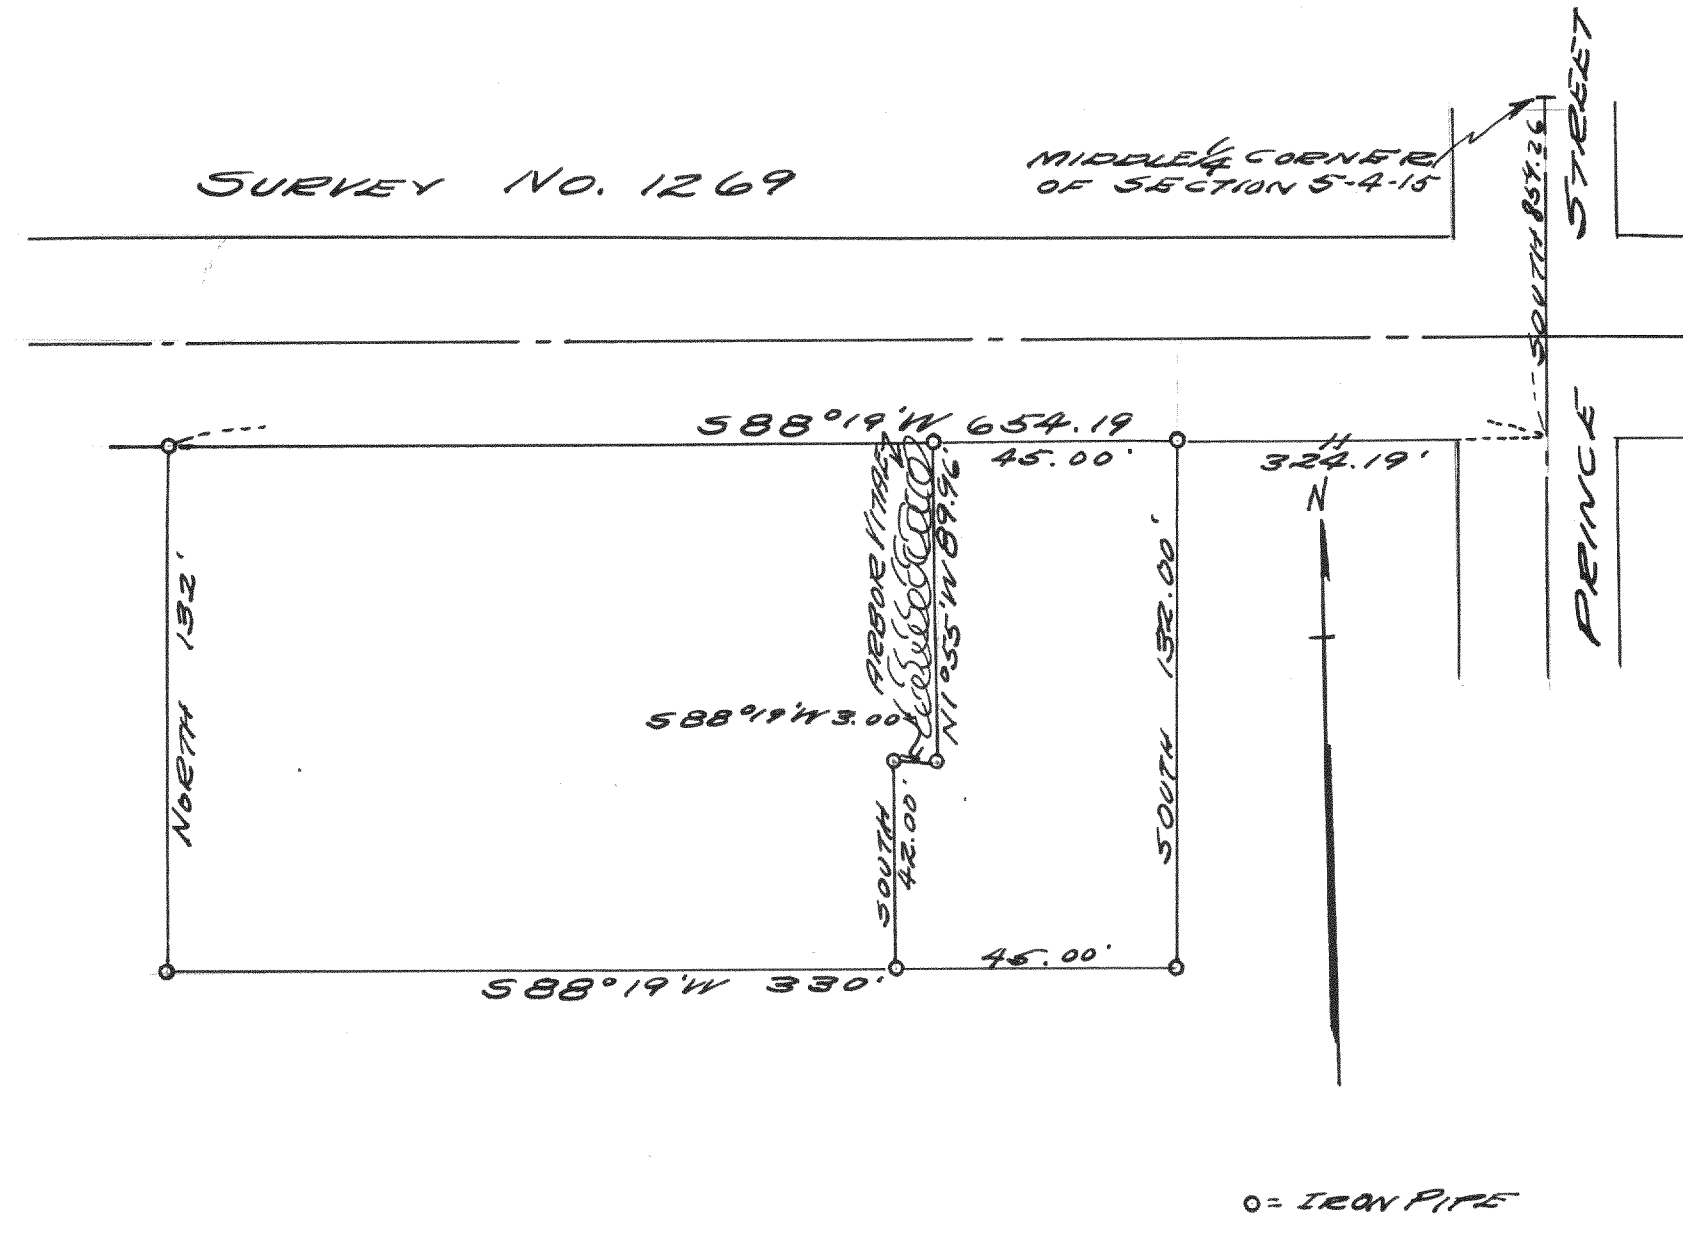

PLAT OF SURVEY OF LAND LOCATED IN THE SW $\frac{1}{4}$ OF
SECTION 5 TAN, R15E, IN THE CITY OF WHITEWATER,
WALWORTH COUNTY, WISCONSIN.
JULY 1, 1941
Lloyd L. Jensen
H.E.J.

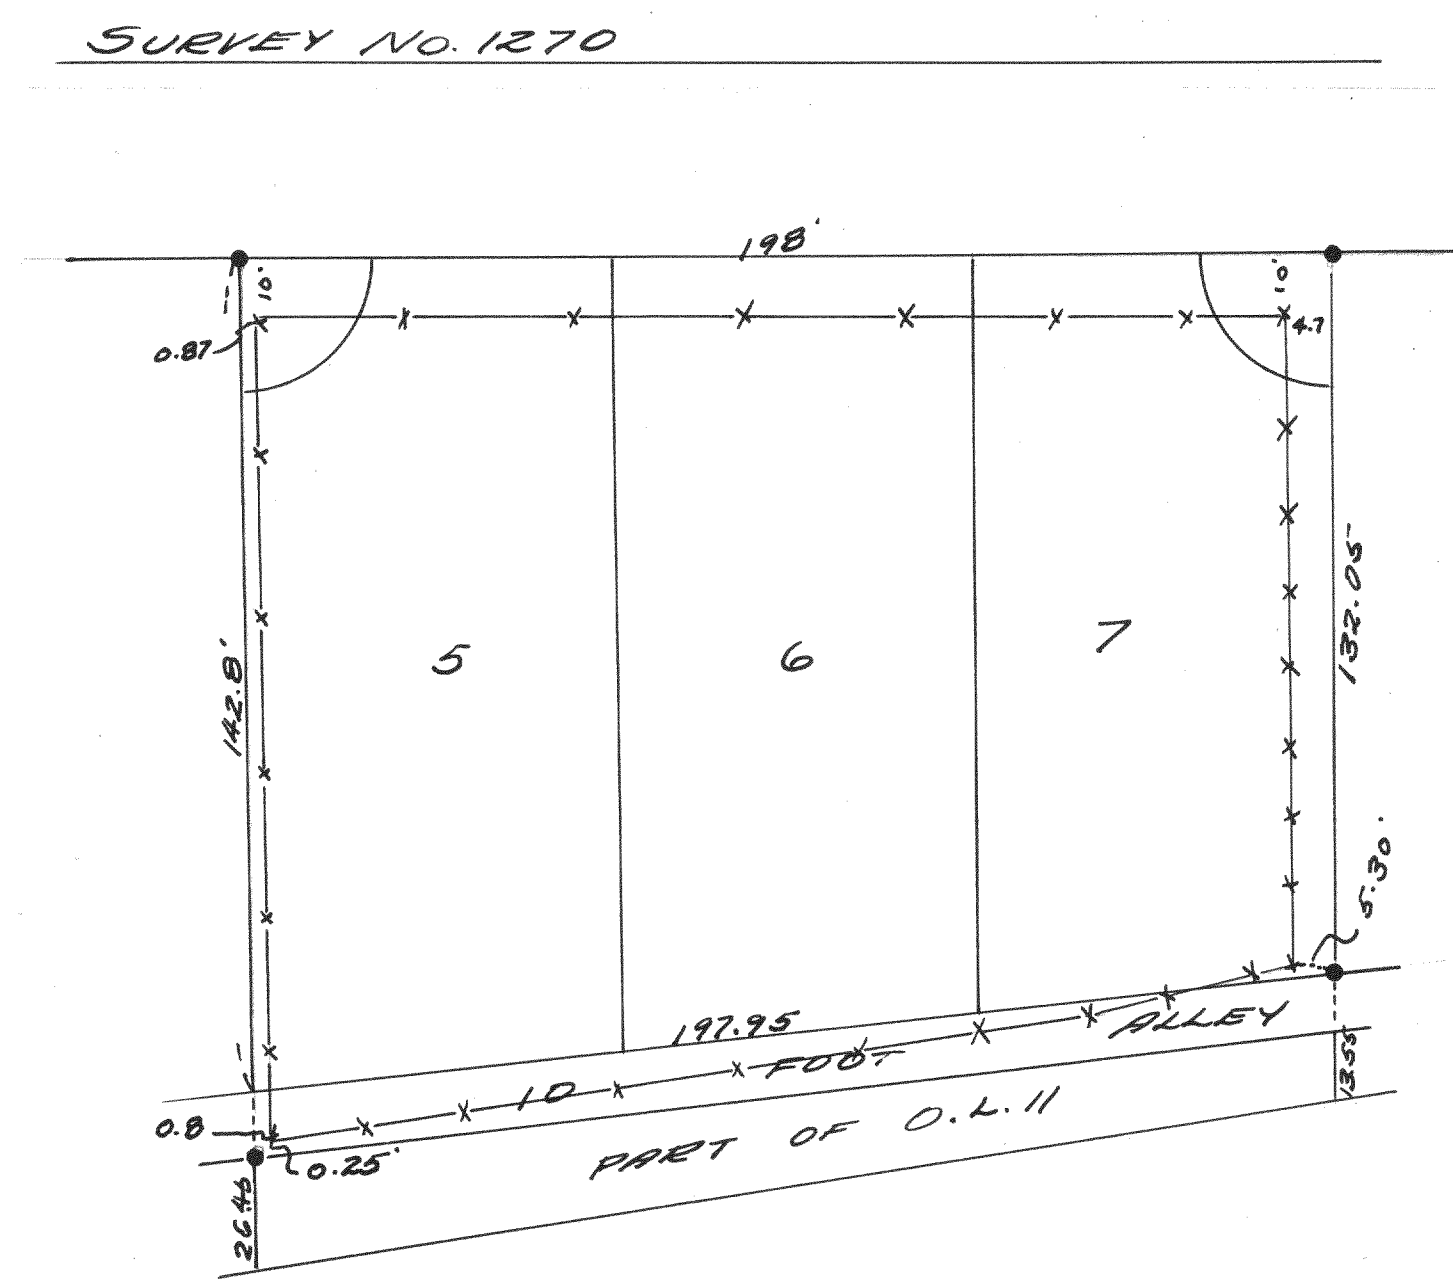

PLAT OF SURVEY OF LOTS 5, 6 & 7 OF BLOCK
3 OF TRIPP & POSEY'S SUBDIVISION OF BLOCK 10
OF TRIPP'S 2ND ADDITION TO THE CITY OF
WHITEWATER, WALWORTH CO., WISCONSIN.
JULY, 1941
Lloyd L. Jensen
H.E.J.