



2146

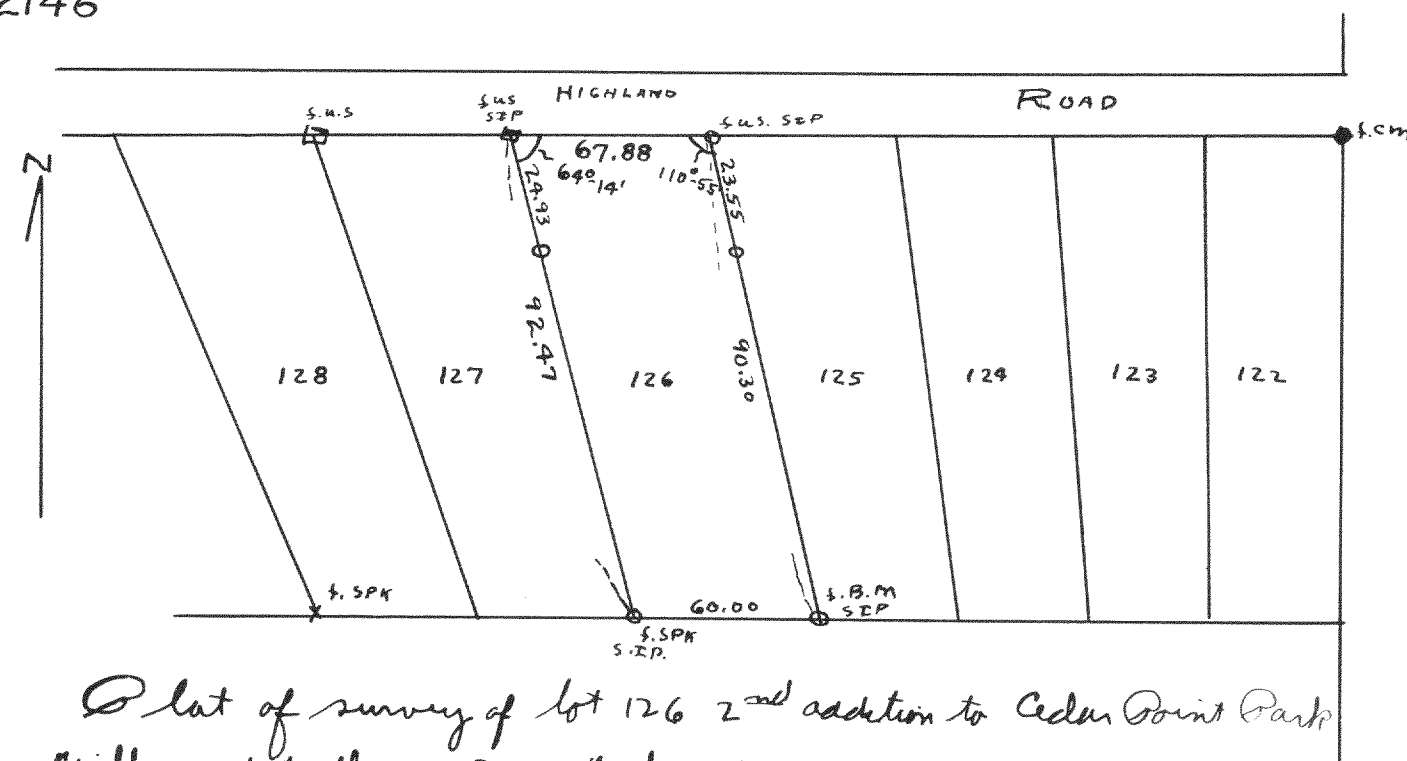


Plat of survey of lot 126 2nd addition to Cedar Point Park
Village of Williams Bay, Walworth County
April 1, 1949
Lloyd & Jensen ^{SD}
County Surveyor

2148

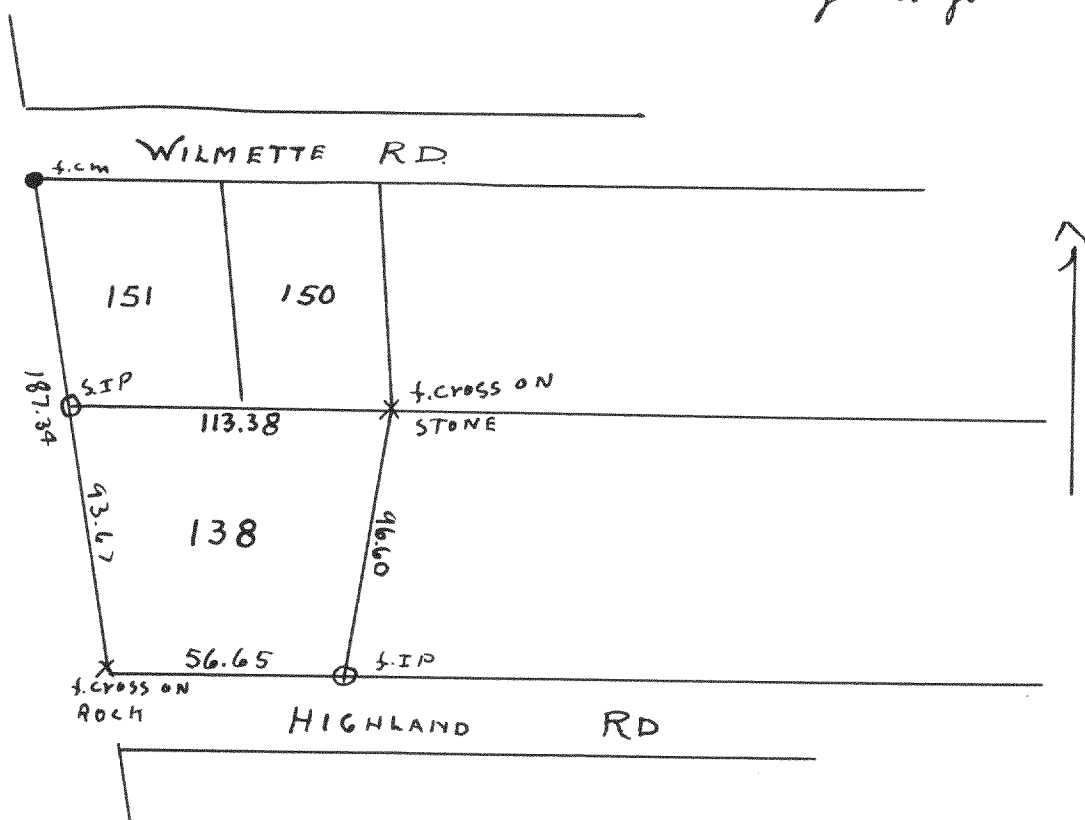


Plat of survey of lot 138 2nd addition of Cedar Point Park
Village of Williams Bay, Walworth County
May 6, 1949
Lloyd & Jensen ^{SD}
County Surveyor

2147

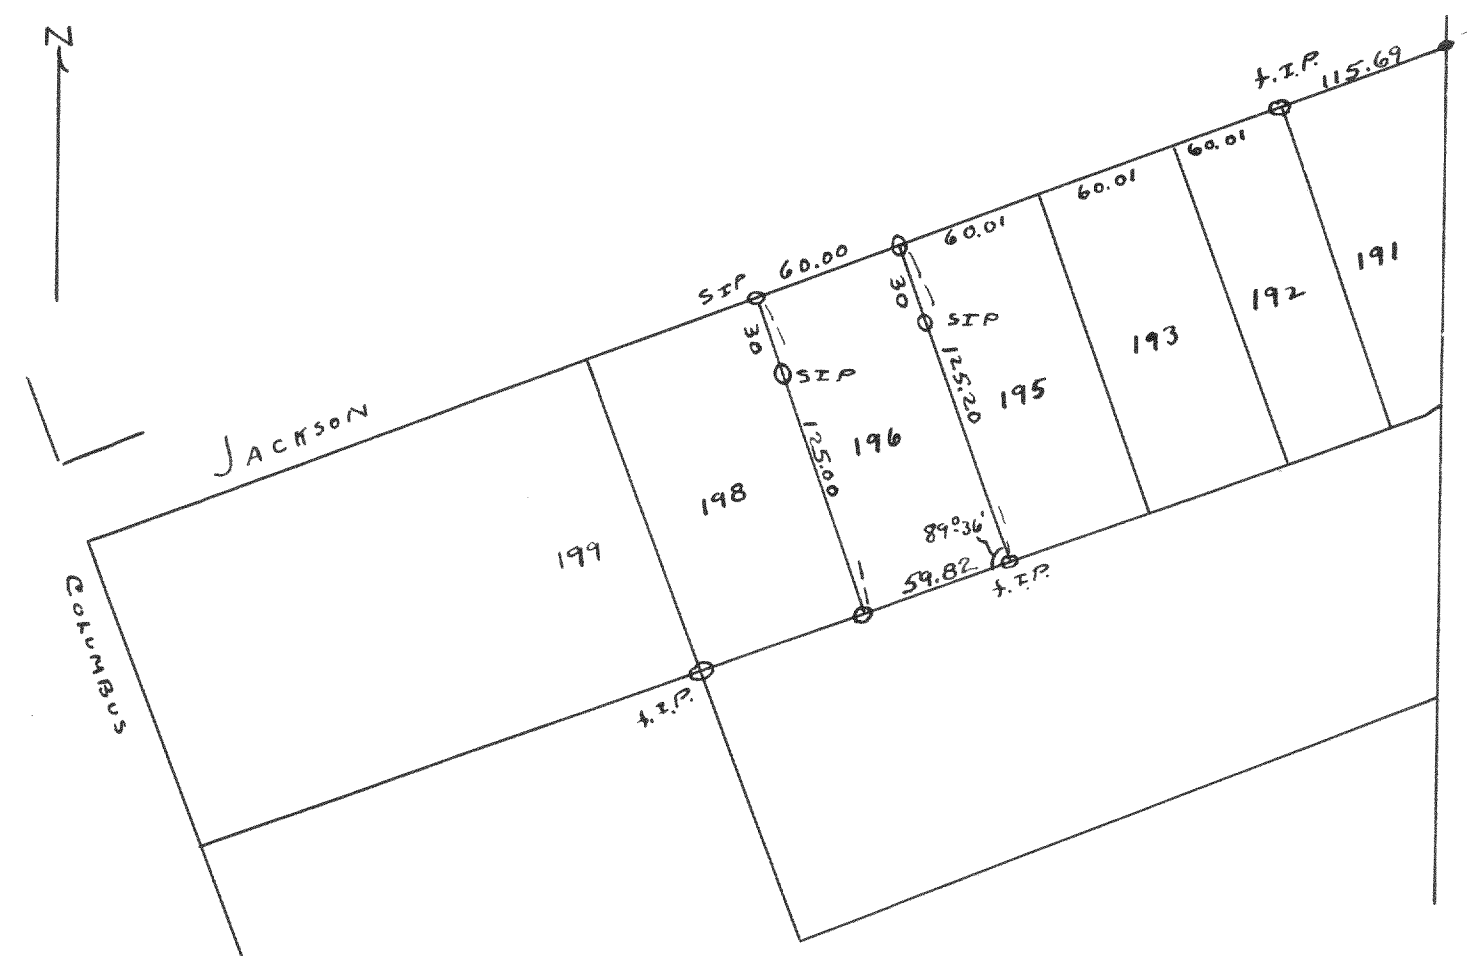

Plat of survey of lot 196 Cedar Point Park Subdivision located
in the Village of Williams Bay, Walworth County
April 12, 1949

2149

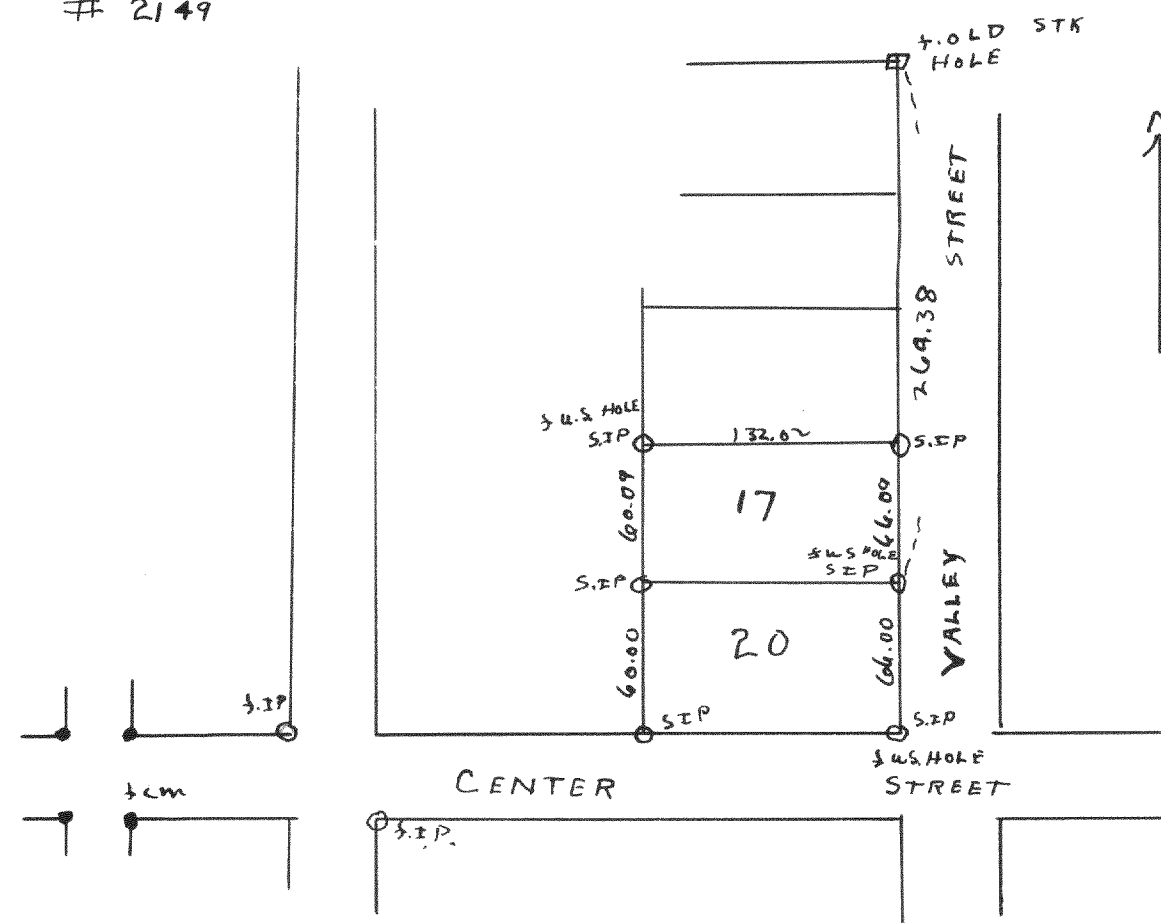

Plat of survey of lots 17 & 20 Block 11 of Williams 2nd Addition - Village of Williams Bay.
May 1949
Lloyd & Jensen ^{SD}
County Surveyor