



2150

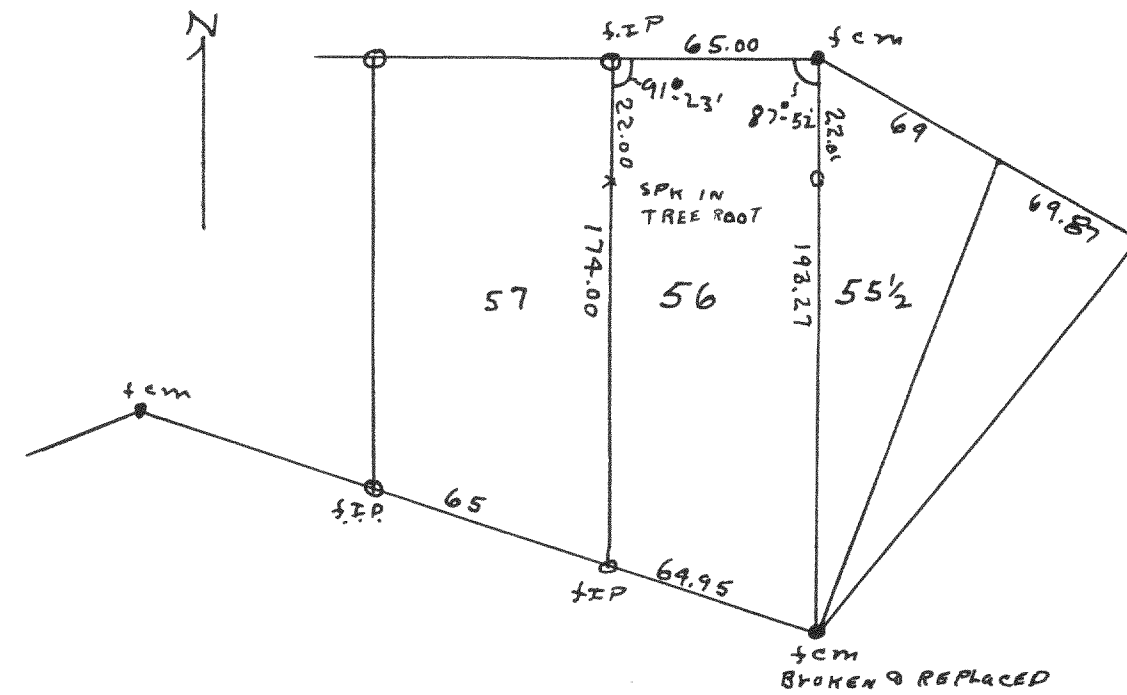


Plot of survey of lot 56 Cedar Point Park 1st addition
Village of Williams Bay Walworth County
May 19 49
Lloyd S Jensen ~~SD~~
County Surveyor

#2152

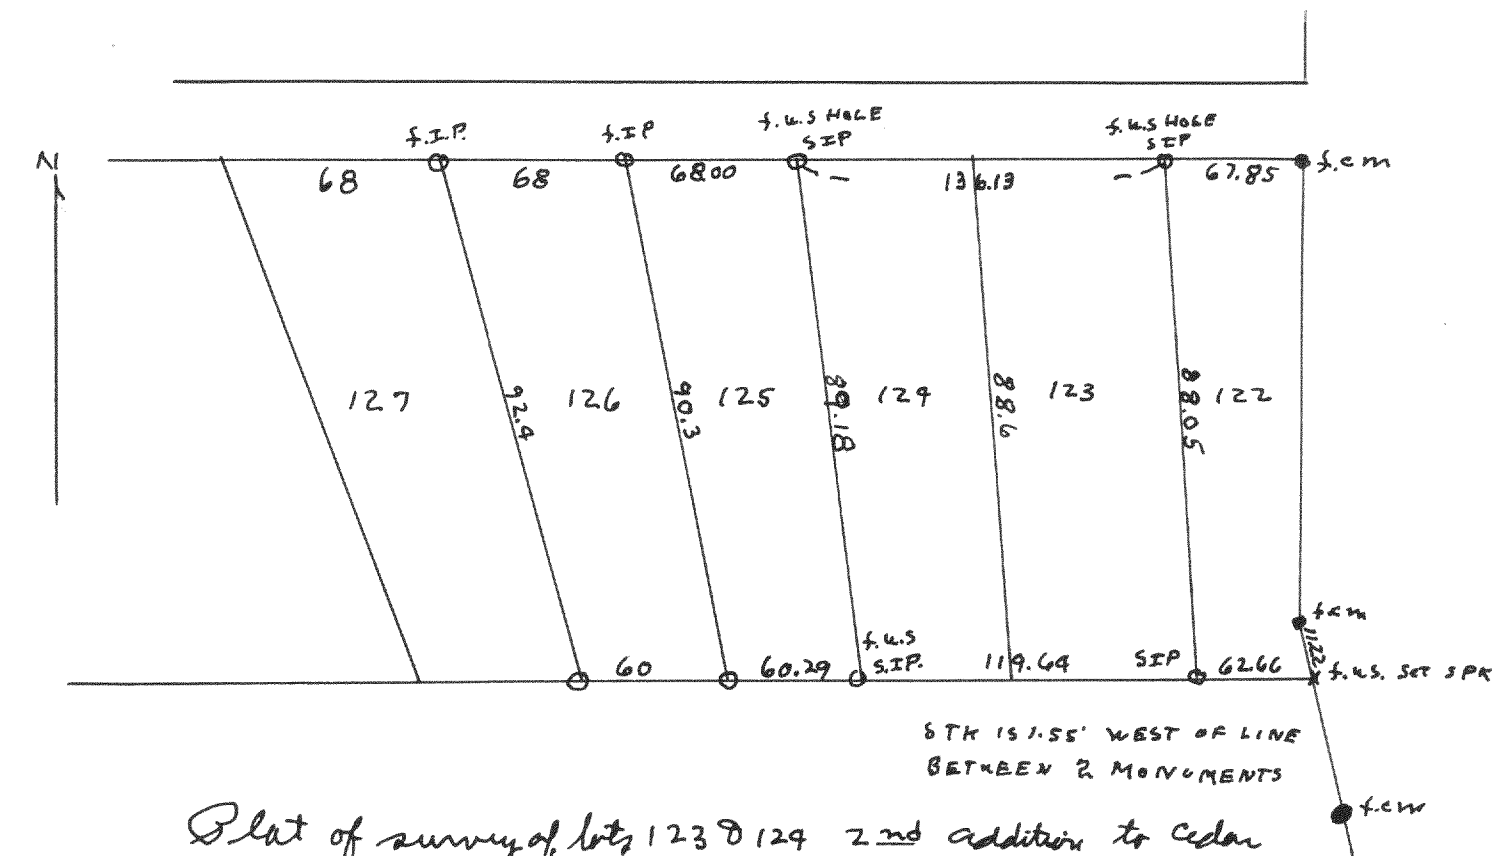


Plat of survey of lots 123 & 124 2nd addition to Cedar
Point Park, Village of Williams Bay, Walworth County
May 27, 1949
Lloyd S Jensen 2nd
County Surveyor

2153

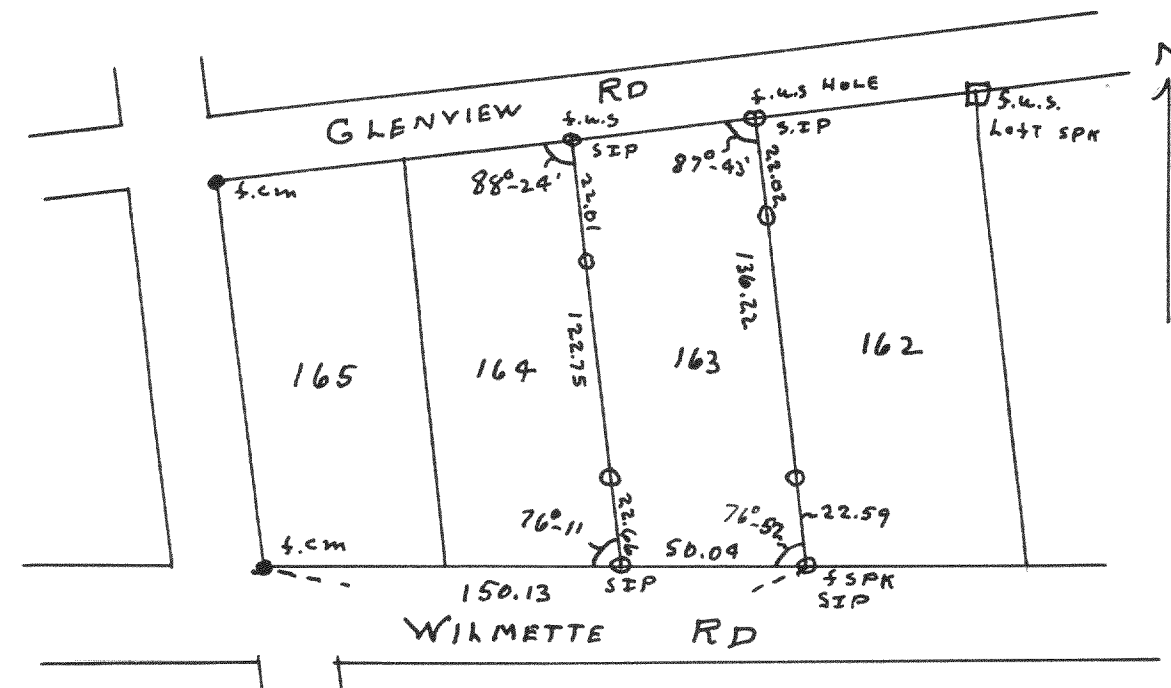

Plot of survey of lot 163 2nd Addition Cedar Point Park
Village of Williams Bay Walworth County
May 29, 1949
Lloyd S. Jensen
County Surveyor

2154

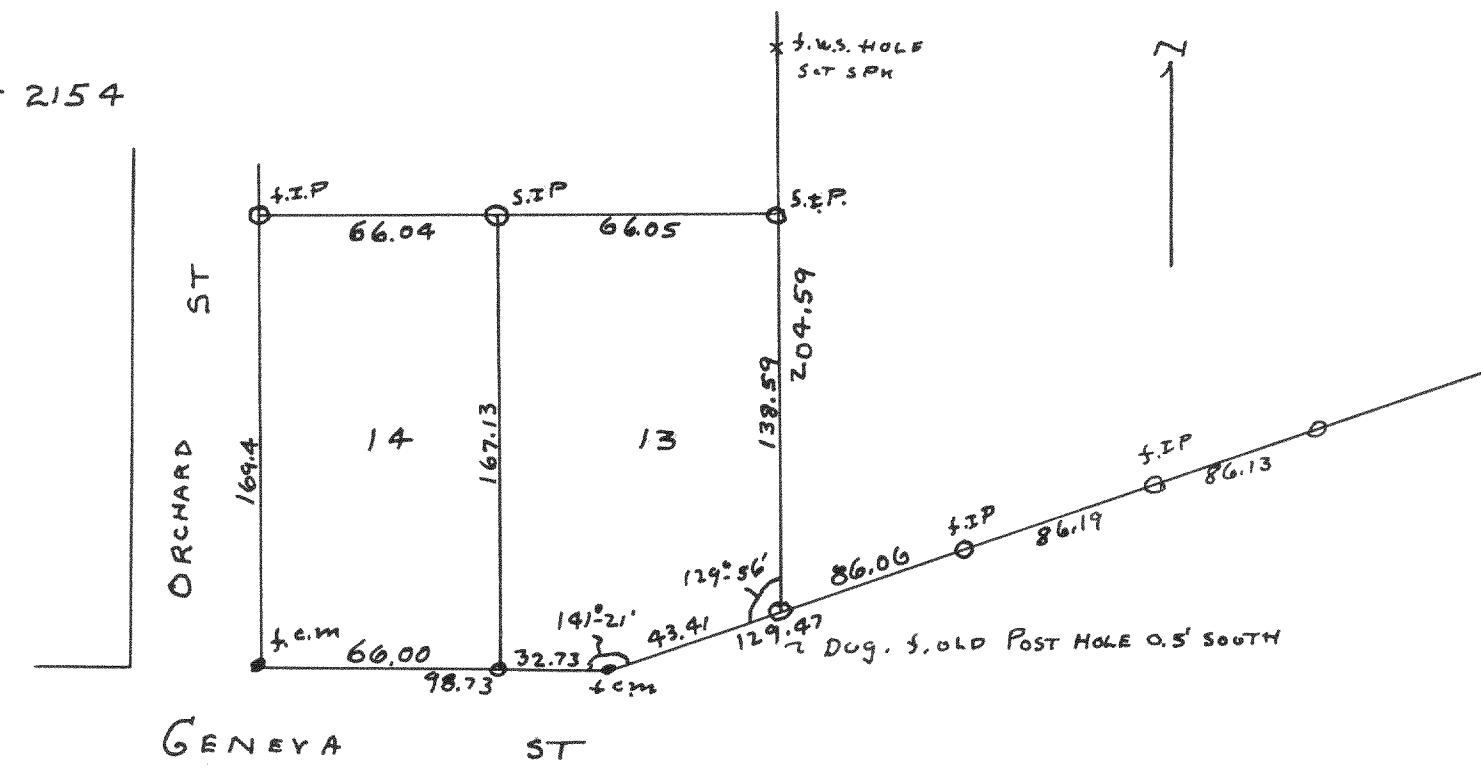

Plot of survey of lots 13 & 14 Block 7, Williams 2nd Addition, Village of
Williams Bay, Malheur County
June 8, 1949
Lloyd I. Jensen
County Surveyor