


472


2155

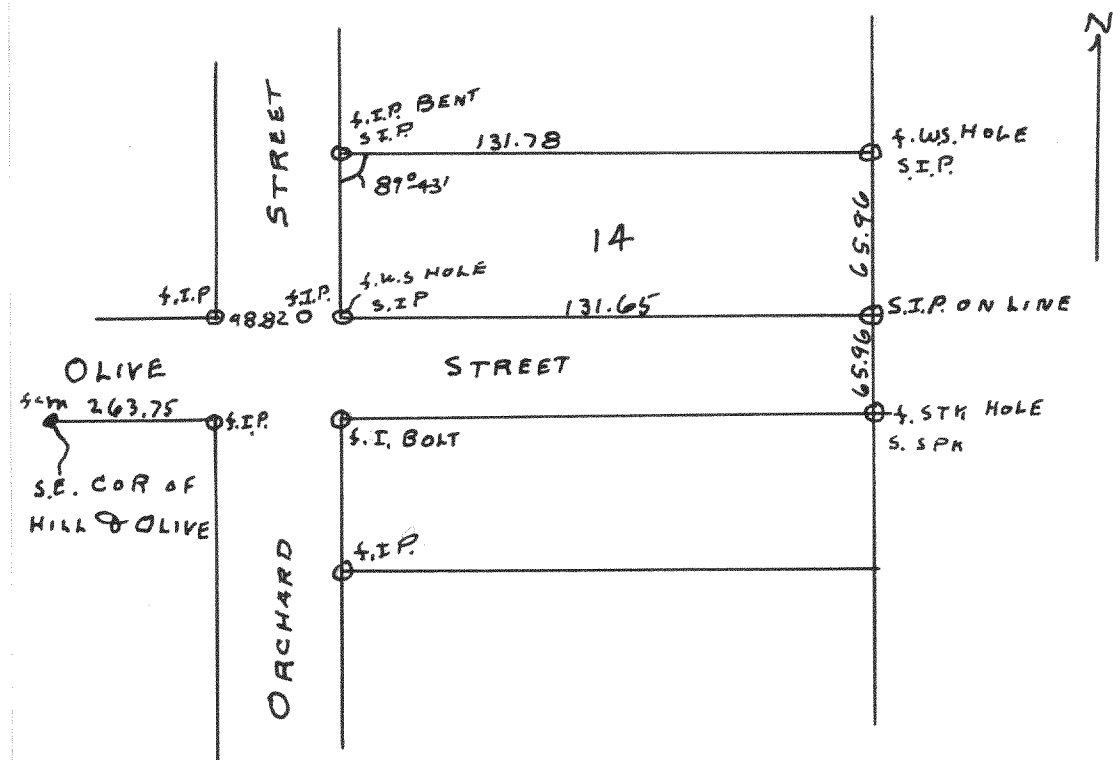

Plot of survey of lot 14 Forkwoods 2nd Addition
Village of Williams Bay, Walworth County
June 8, 1949

Lloyd E Jensen *sd*
County Surveyor


2156

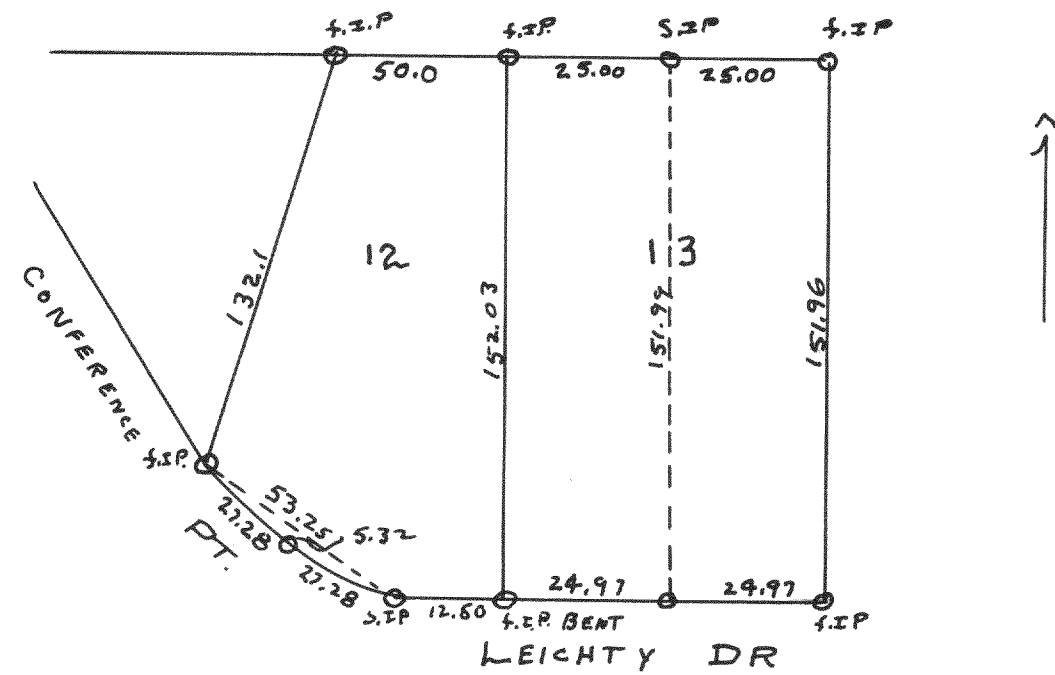

Plot of survey of lots 12 & the west 1/2 of lot 13 Summer Haven
Subdivision located in the Village of Williams Bay, Walworth County
1949

Lloyd E Jensen *sd*
County Surveyor


2157

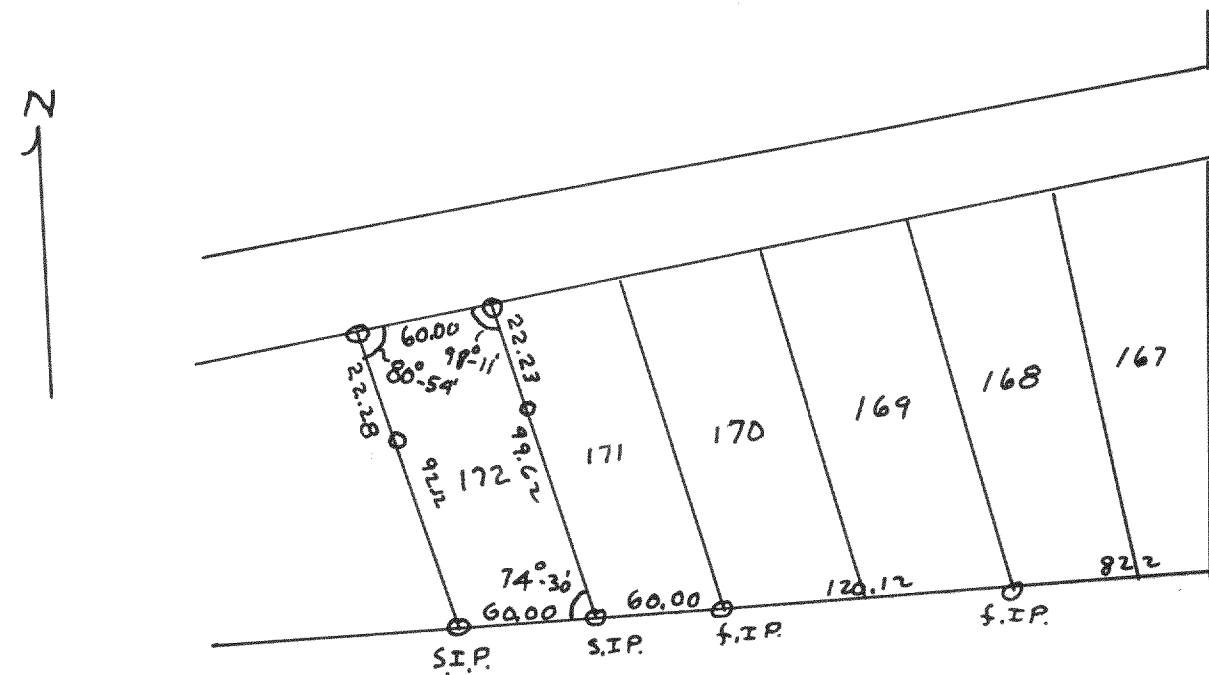

Plot of survey of lot 172 2nd Addition to Cedar Point Park Subdivision
Village of Williams Bay, Walworth County
1949

Lloyd E Jensen *sd*
County Surveyor

2158

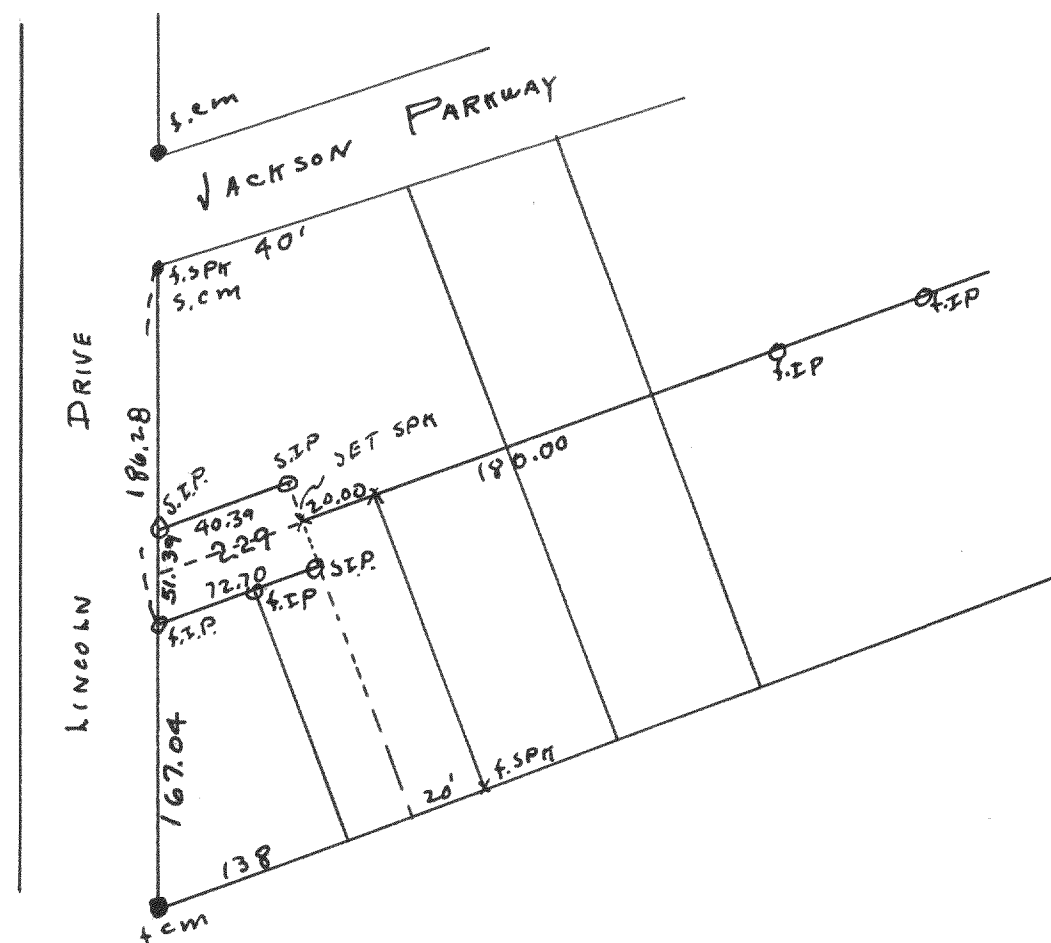

Plot of survey of lot 229 Original Subdivision of Cedar
Point Park Subdivision Village of Williams Bay, Walworth County
July 27, 1949

Lloyd E Jensen *sd*
County Surveyor