



2169

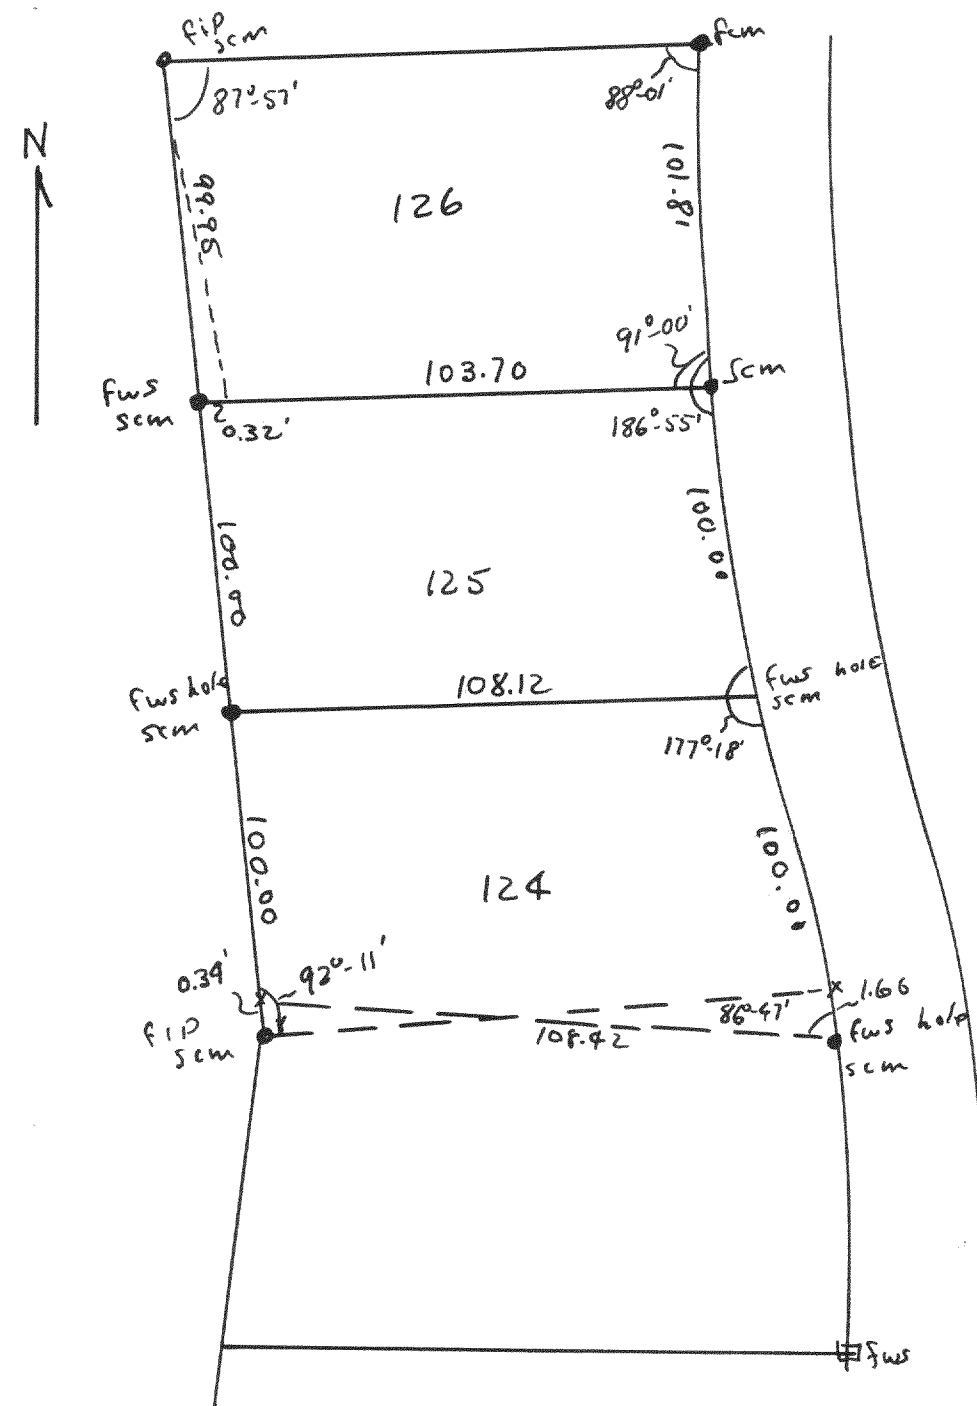

Plat of survey of lots 124, 125, 126 Country Club Estates Unit 2,
Village of Fontana, Walworth County, Wis.
April 23, 1949
Lloyd L. Jensen
County Surveyor

#2170

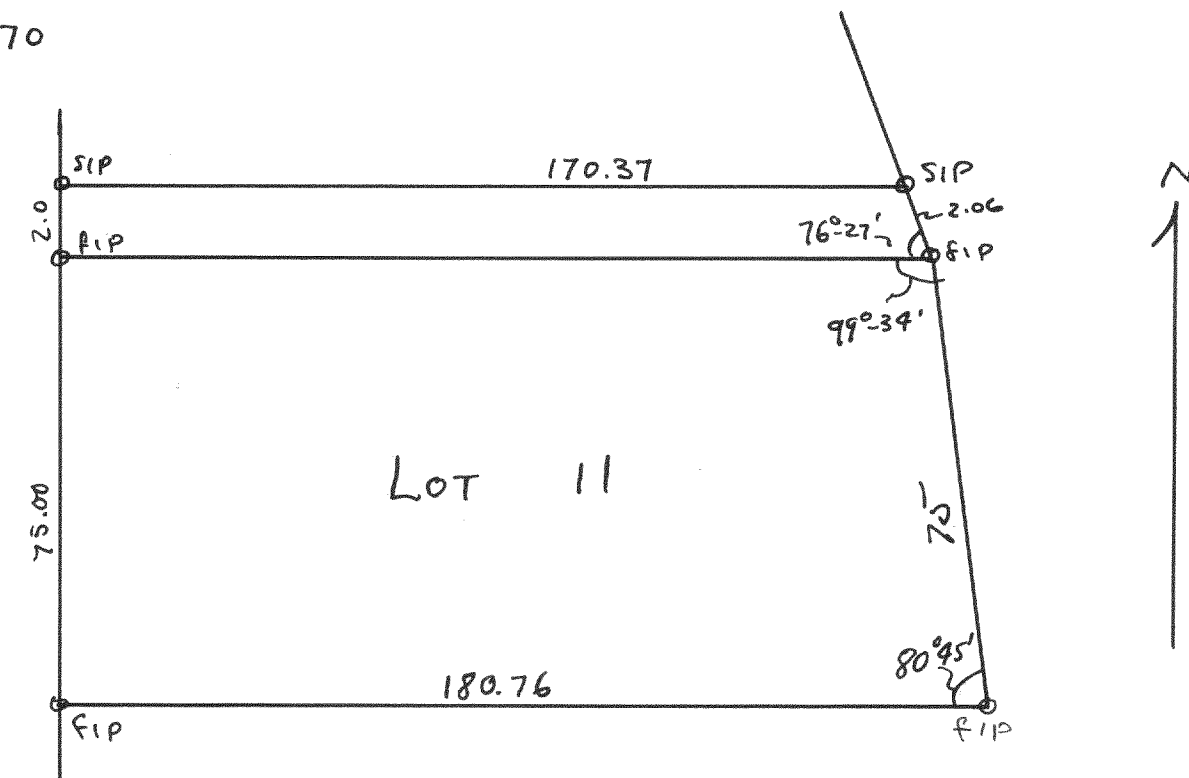

Plat of survey of Lot 11, & the South 2 feet of Lot 12
Block 6 of Wooddale Subd. located in Sec 9, T14N R17E,
Walworth County Wis.
Sept 15, 1949

Lloyd L. Jensen
County Surveyor