


2174

2175

Plat of survey of Mar- del Estates Subdivision
located in Section 18 City of Delavan, Walworth County,
Wisconsin. See recorded plat on file in the Register of Deeds
in the County Court House

1949

Floyd E Jensen *sd*
County Surveyor

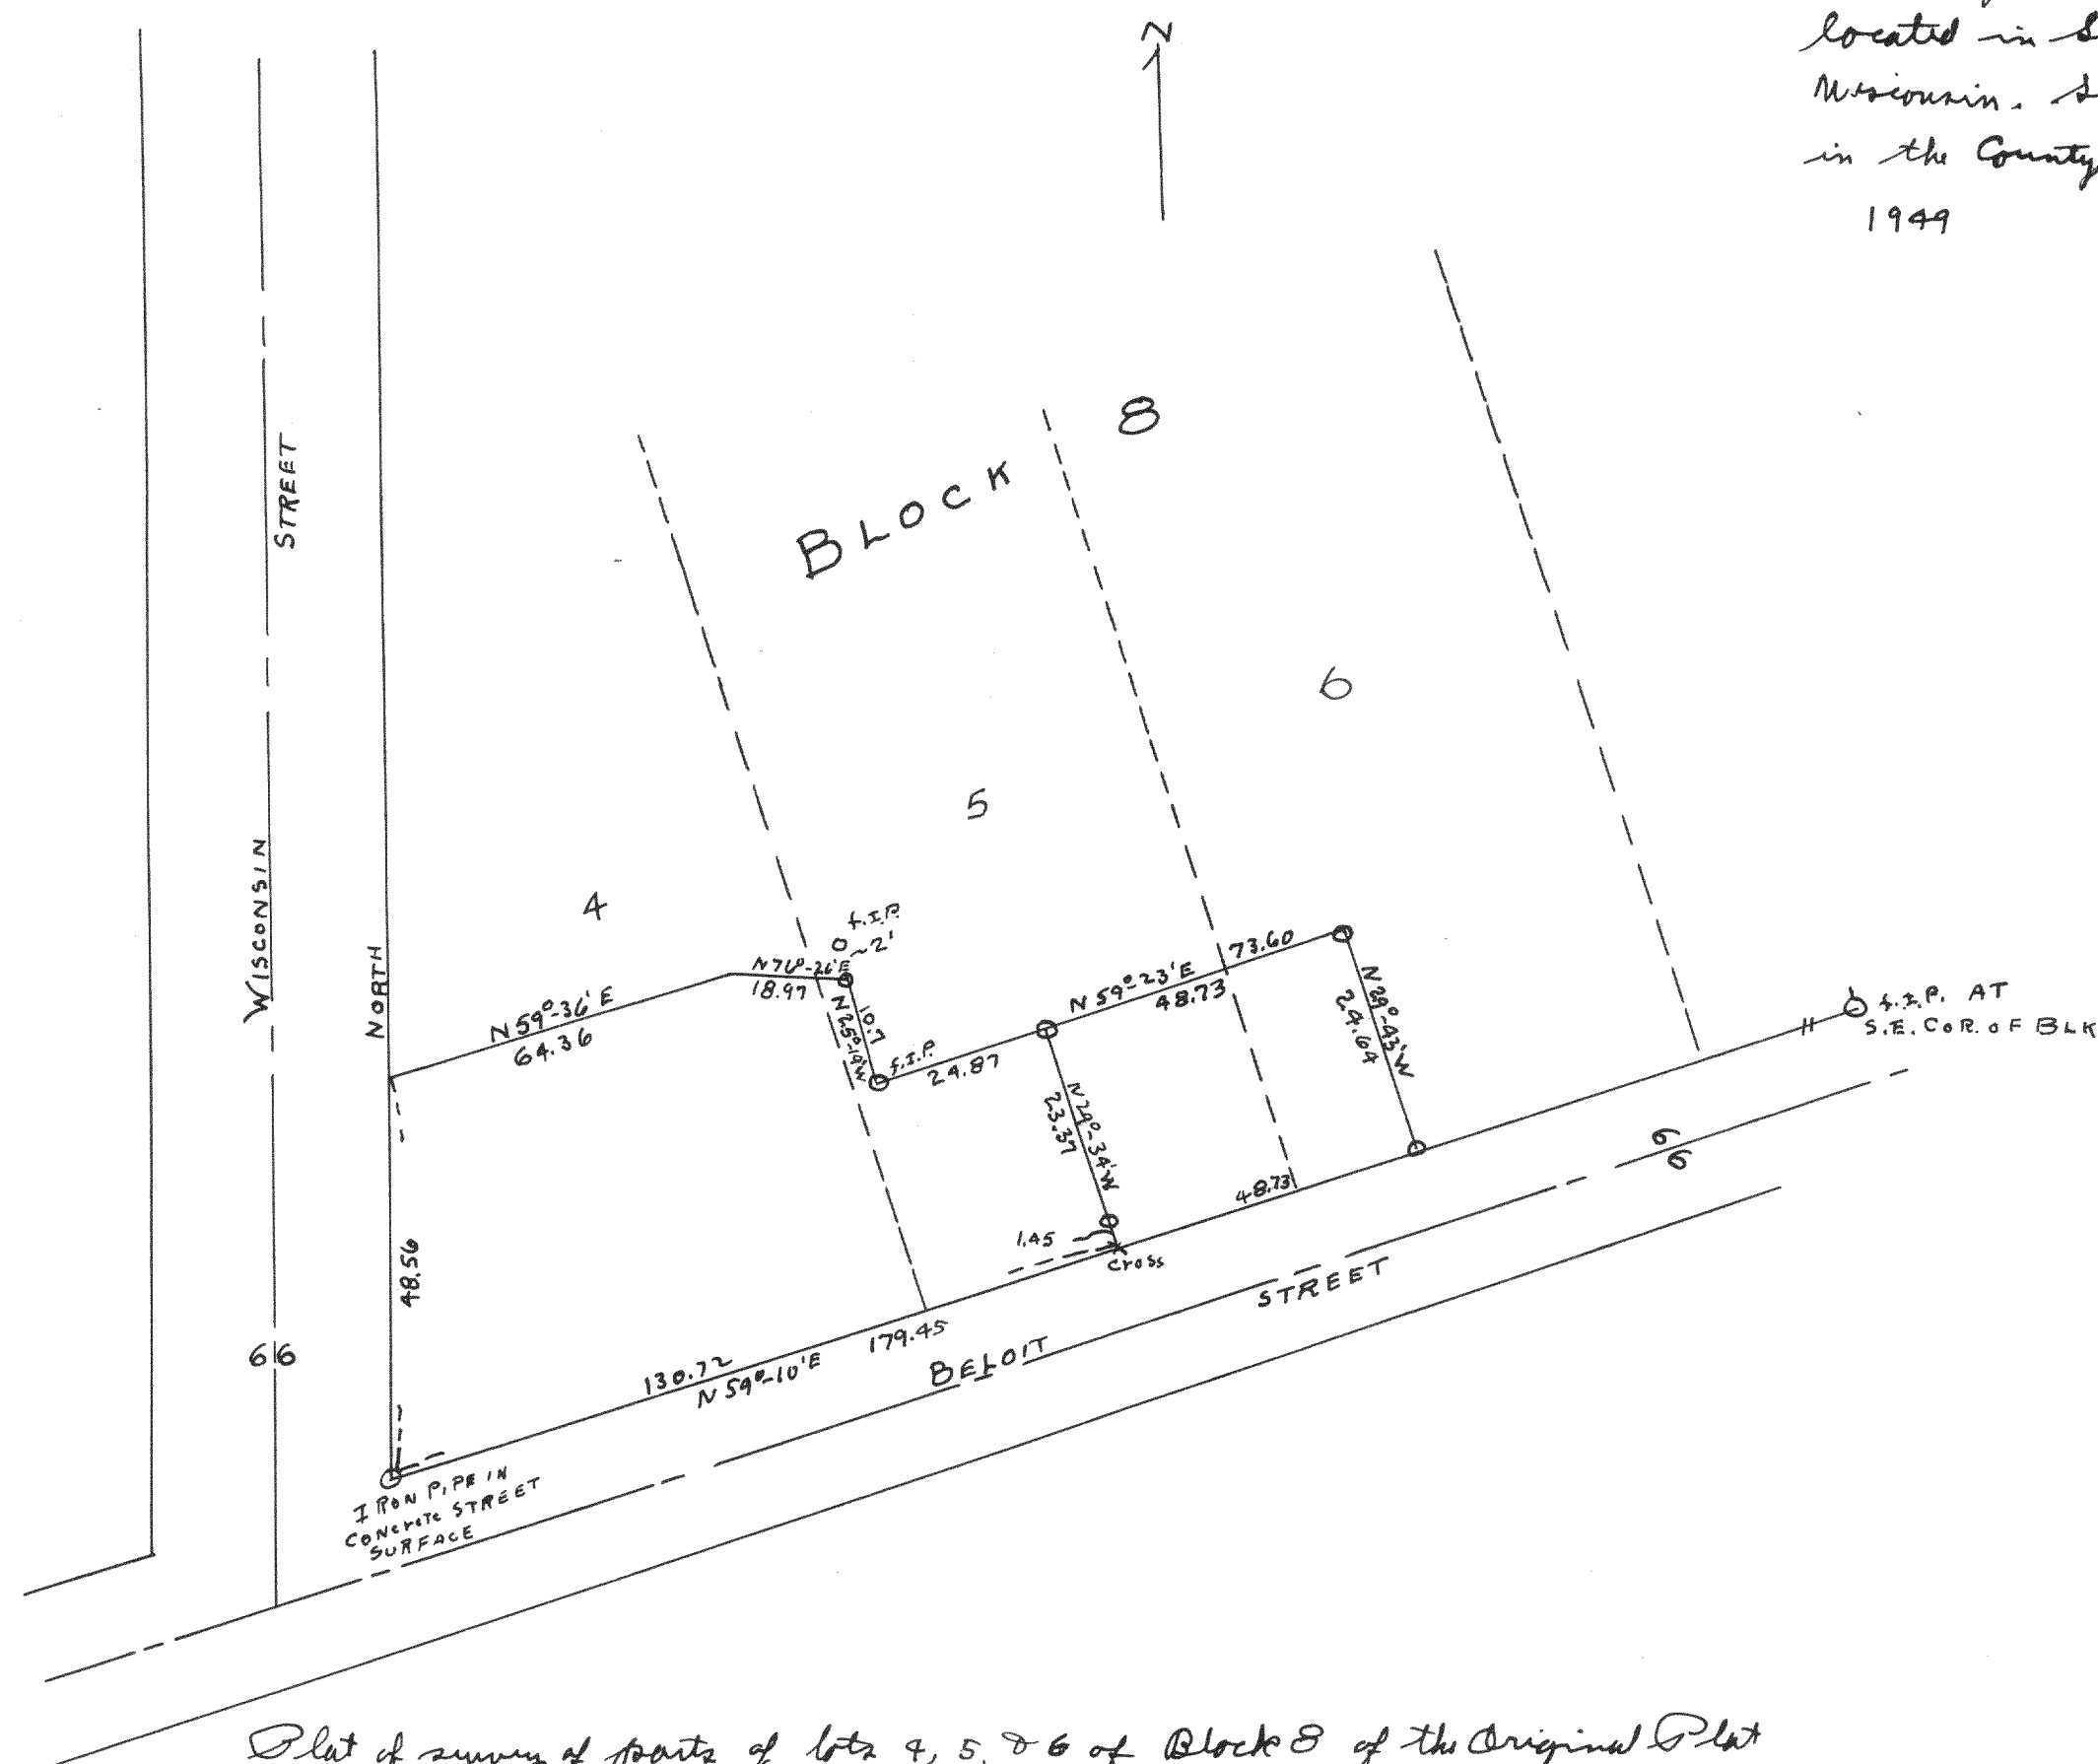

Plat of survey of parts of lots 4, 5, & 6 of Block 8 of the Original Plat
of the Village of Delavan, Walworth County
July 20, 1949

Floyd E Jensen *sd*
County Surveyor