



#2180

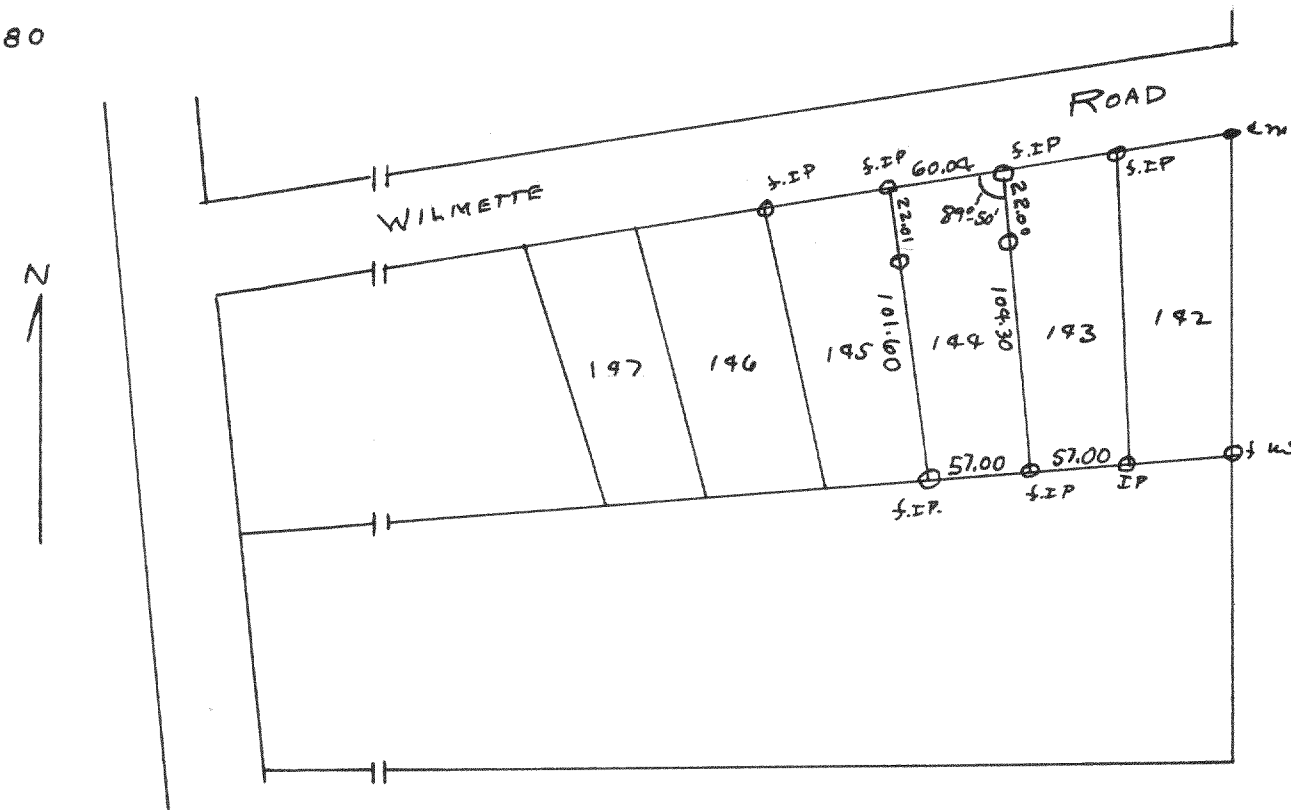


Plat of survey of lot 144 Cedar Point Park 2nd Addition
located in the Village of Williams Bay Walworth County
Aug 15, 1949
Lloyd E Jensen
County Surveyor

2181

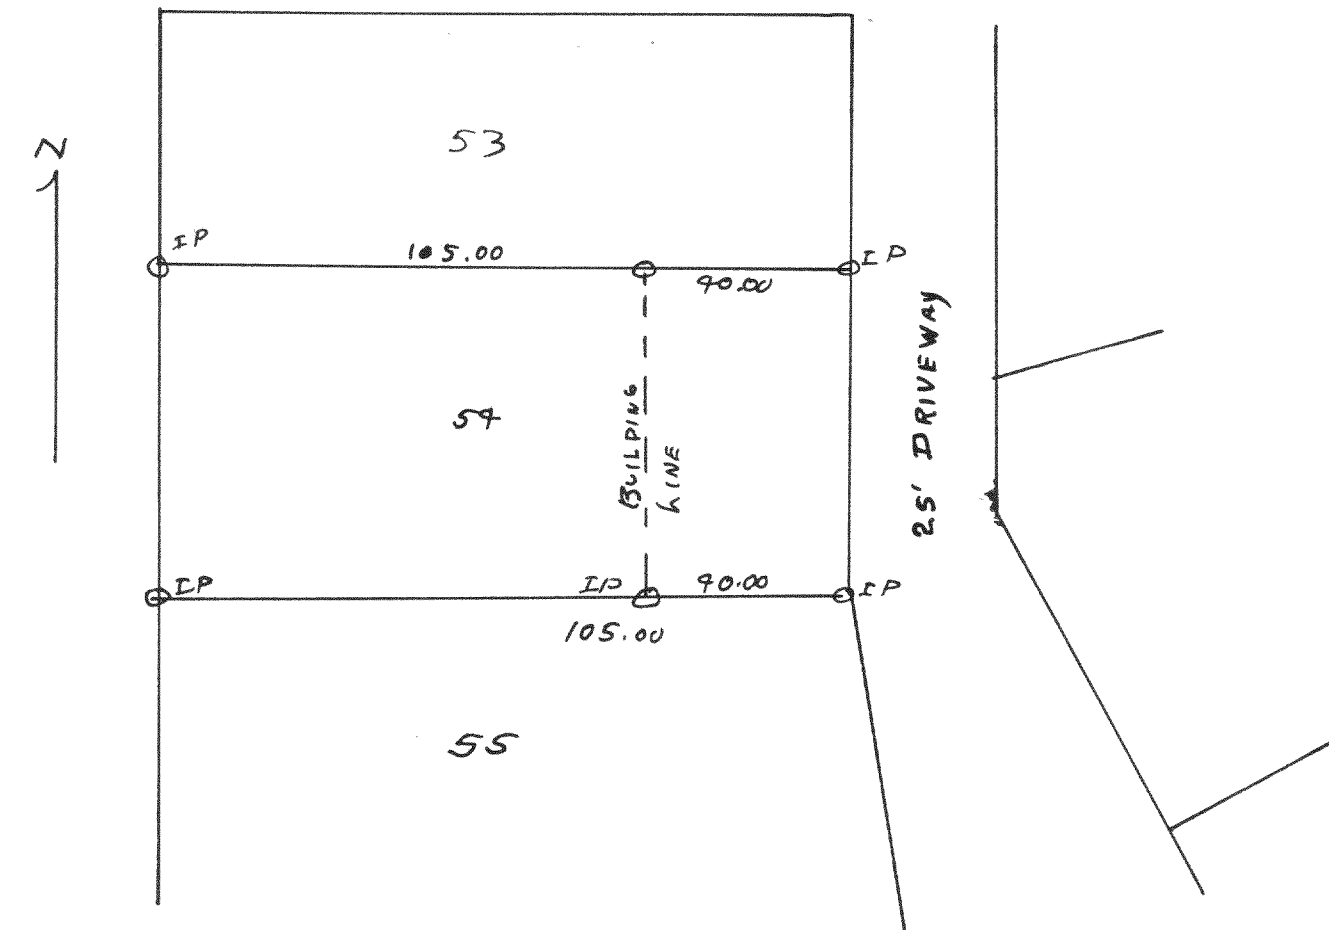


Plat of survey of lot 57 of Cedar Point Park Original Subdivision
located in the Village of Williams Bay Walworth County
April 1, 1999
Floyd L Jensen *Sts*
County Surveyor

2182

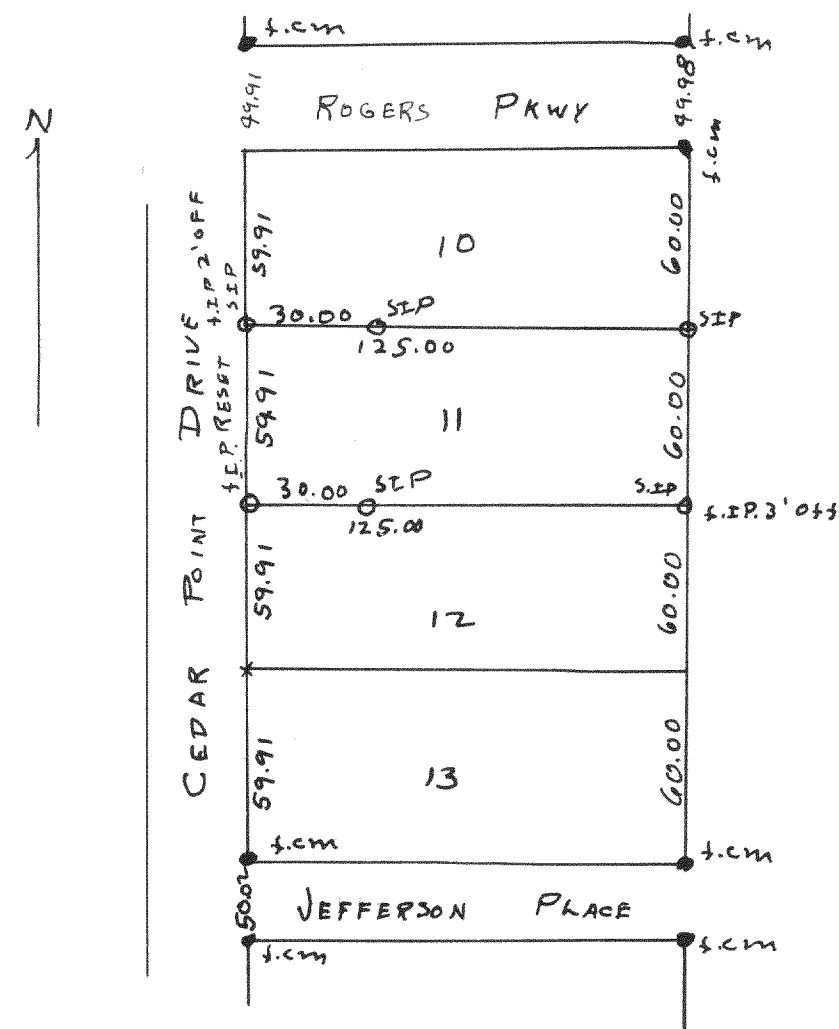

Plot of survey of lot 11 Cedar Point Park Original
located in Williams Bay, Walworth County
April 29, 1999
Floyd Jensen SD
County Surveyor

#2183

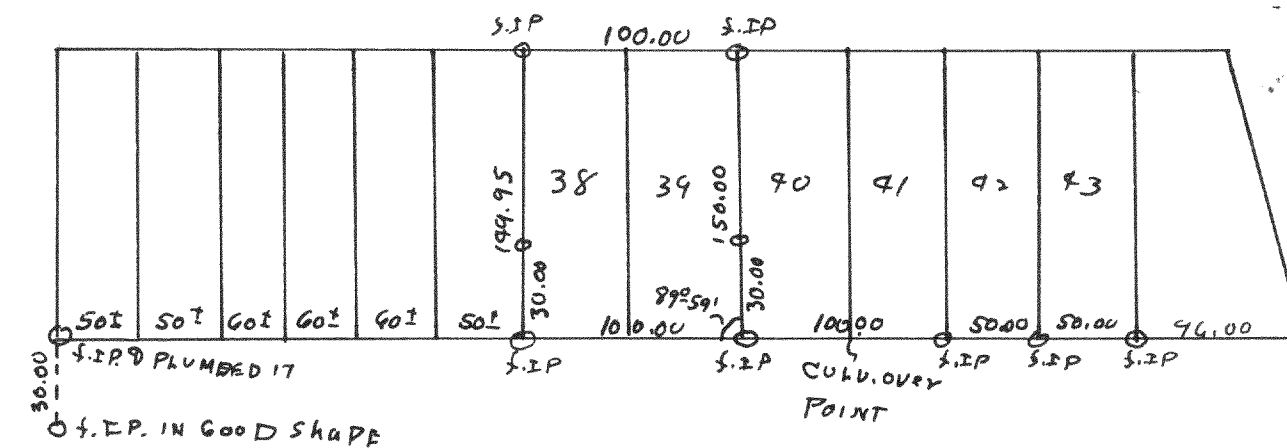

Plot of survey of lots 38 & 39 of Summer Haven Subdivision
located in the Village of Williams Bay Walworth County, Wisconsin
1949
Lloyd E Jensen *etd*
County Surveyor