


#2184




Floyd S Jensen 122
County Surveyor

7

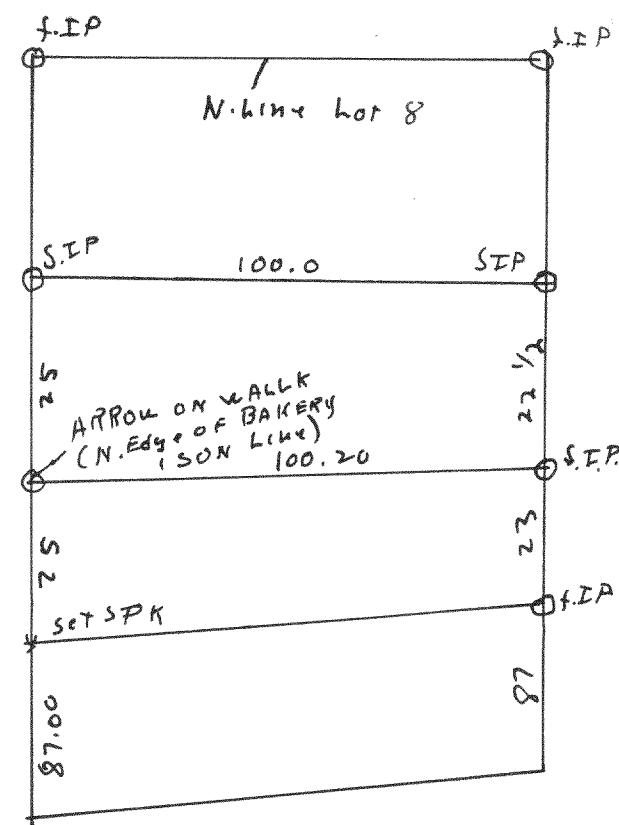


Lloyd Jensen Esq
County Surveyor

2

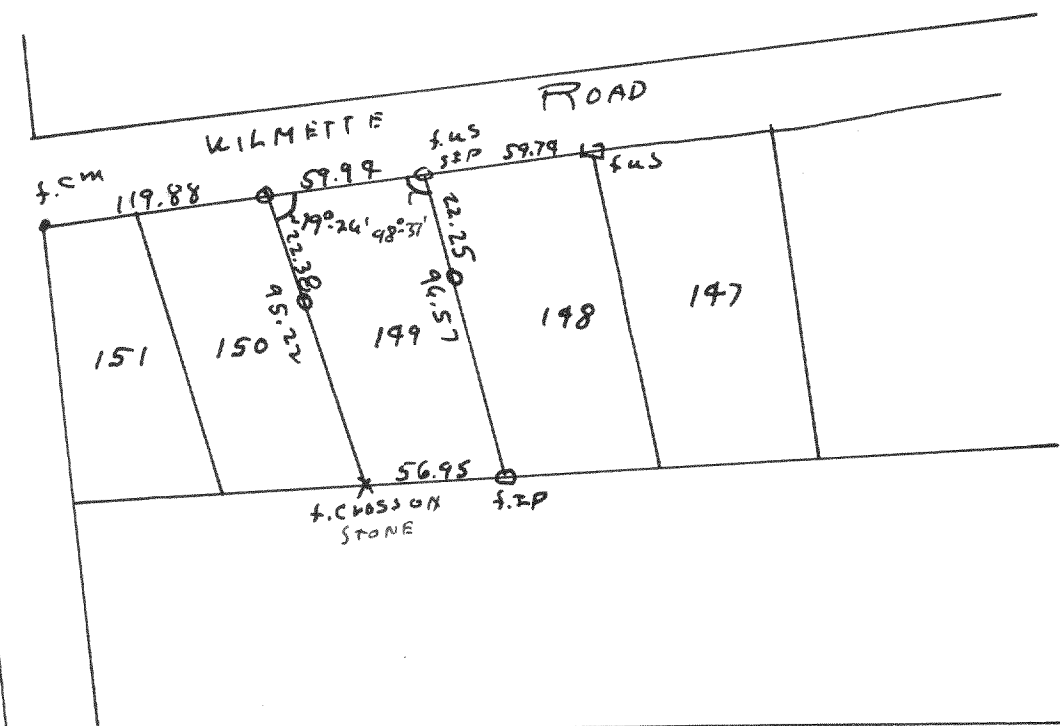

Plot of survey of lot 149 of Cedar Point Park 2nd add
located in the Village of Williams Bay Walworth County
1949
Lloyd L Jensen Esq
County Surveyor

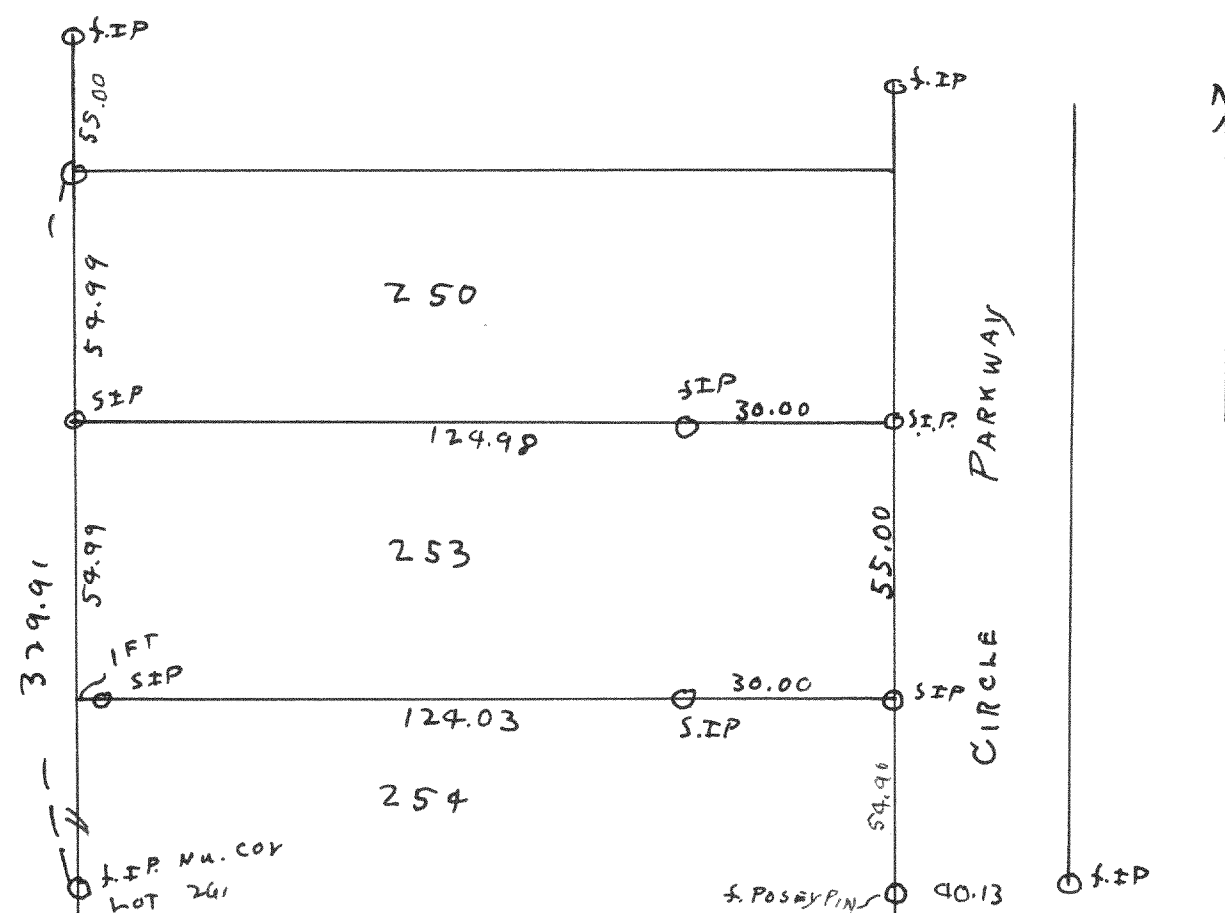

Plot of survey of lot 253 of the 3rd addition to Cedar Point
Park subdivision, Village of Williams Bay, Walworth County
Feb 7, 1950
Floyd Jensen 1255
County Surveyor