


2197

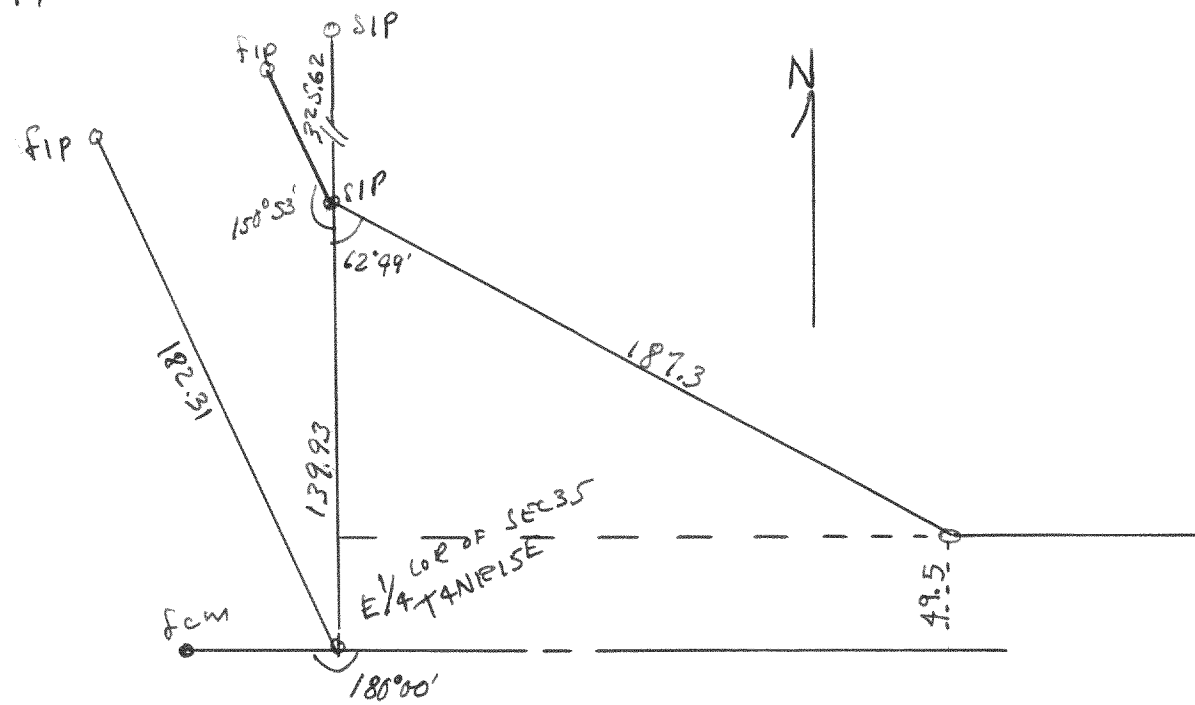


Plat of survey of land deeded to Kachell for additional R.O. W to Kachell farm located in Section 36, T4N R15E of Walworth County Wis.

Sept 25, 1950

Lloyd L. Jensen
County Surveyor

2198

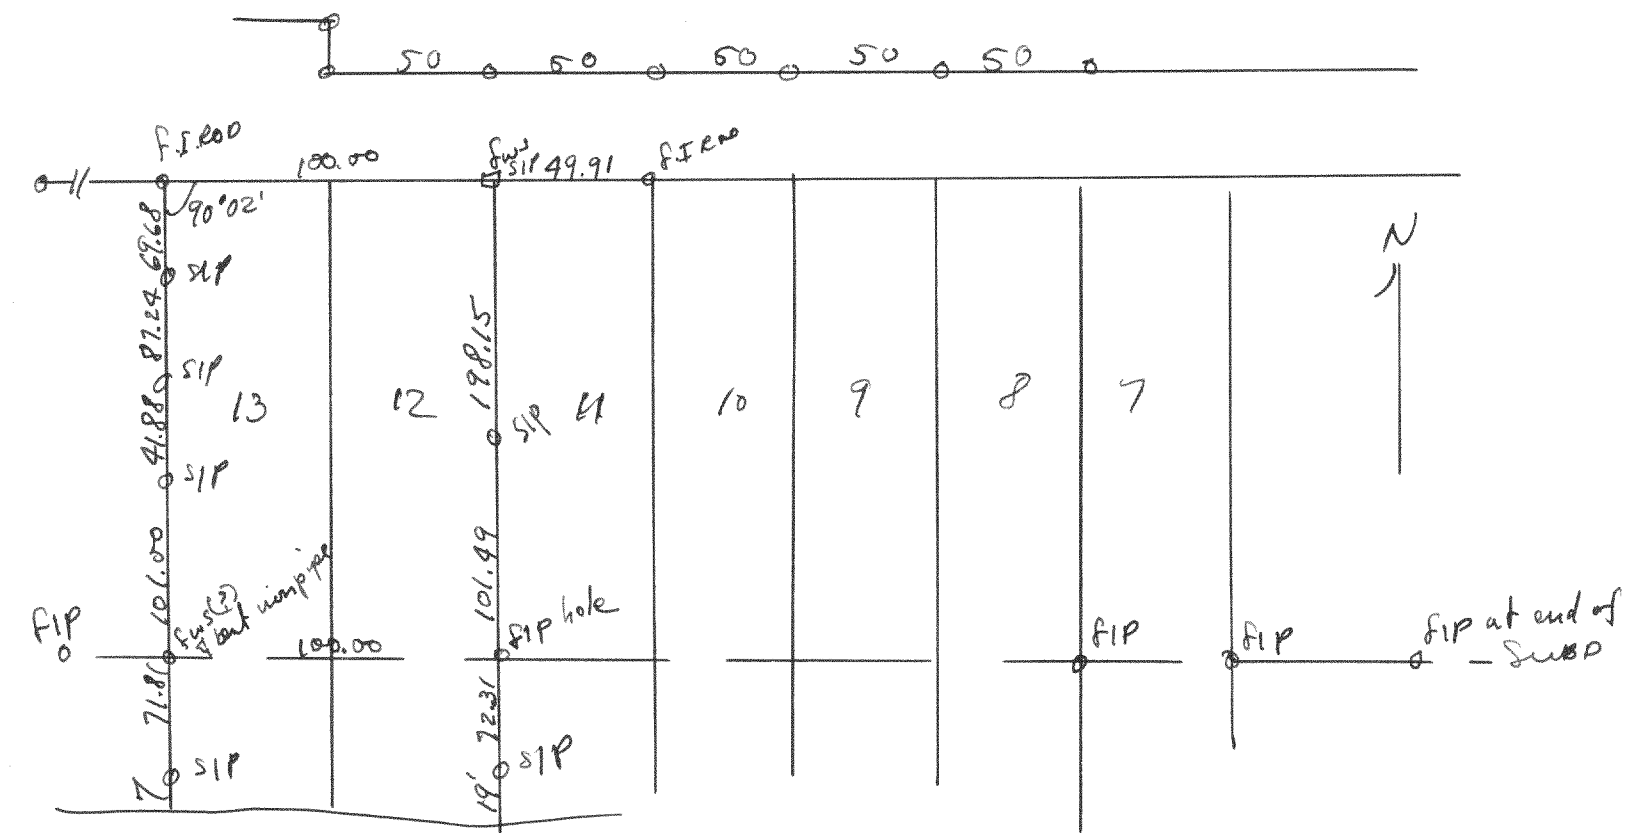


Plat of survey of lots 12 & 13 of Oak Park Subdivision located in Sec 11, T3N R15E of Walworth County Wis.

April 14, 1950

Lloyd L. Jensen
County Surveyor

2199

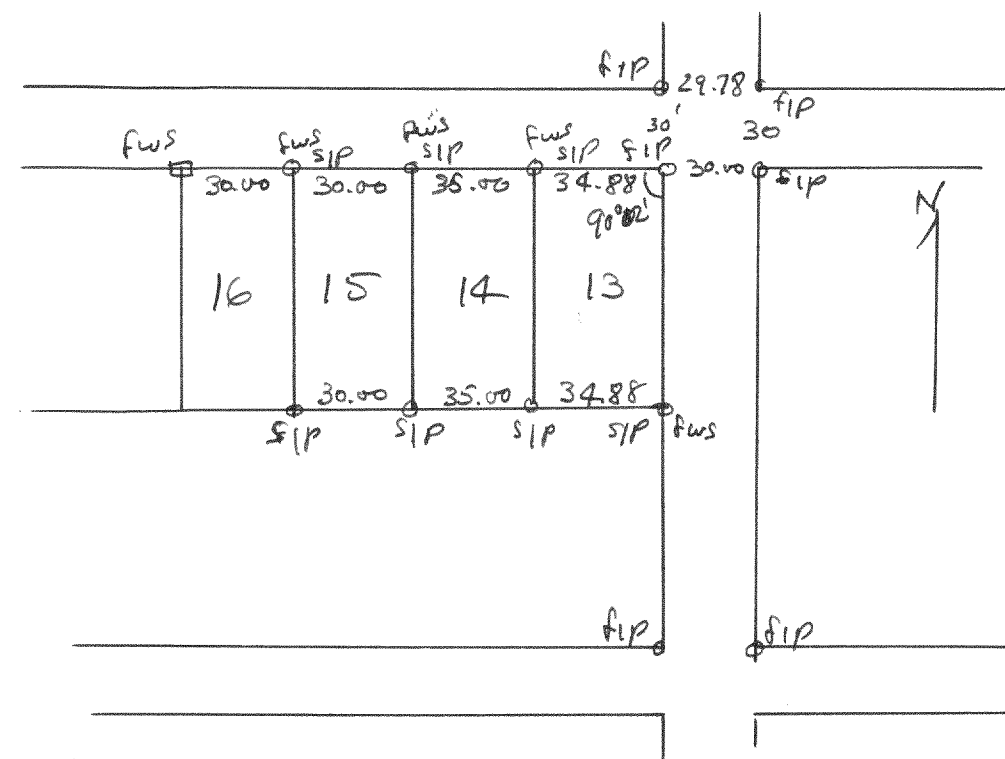


Plat of survey of lots 13, 14, & 15, Blk 11, Skansen Subd. located in Sec 9, T3N R15E of Walworth County, Wis.

June 27, 1950

Lloyd L. Jensen
County Surveyor

2200

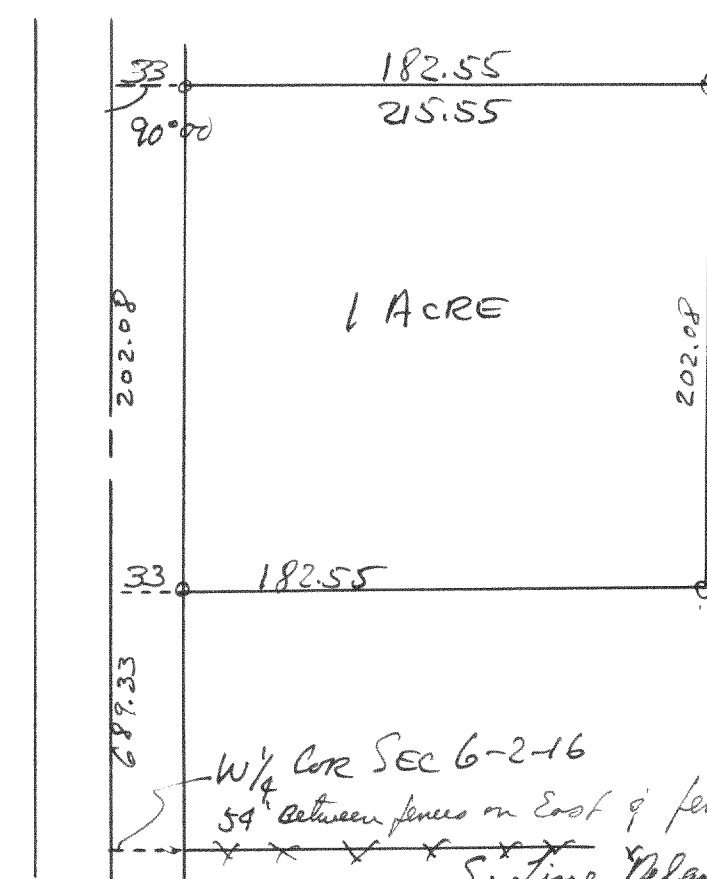

W 1/4 COR SEC 6-2-16
54' between fences on East of fence extended from South
S. Line Delaney Farm

Plat of survey of a 1 acre parcel survey for Gallup and Delaney Farm located in the NW 1/4 of Sec 6, T2N R15E, Walworth County, Wis.

March 28, 1950

Lloyd L. Jensen
County Surveyor