


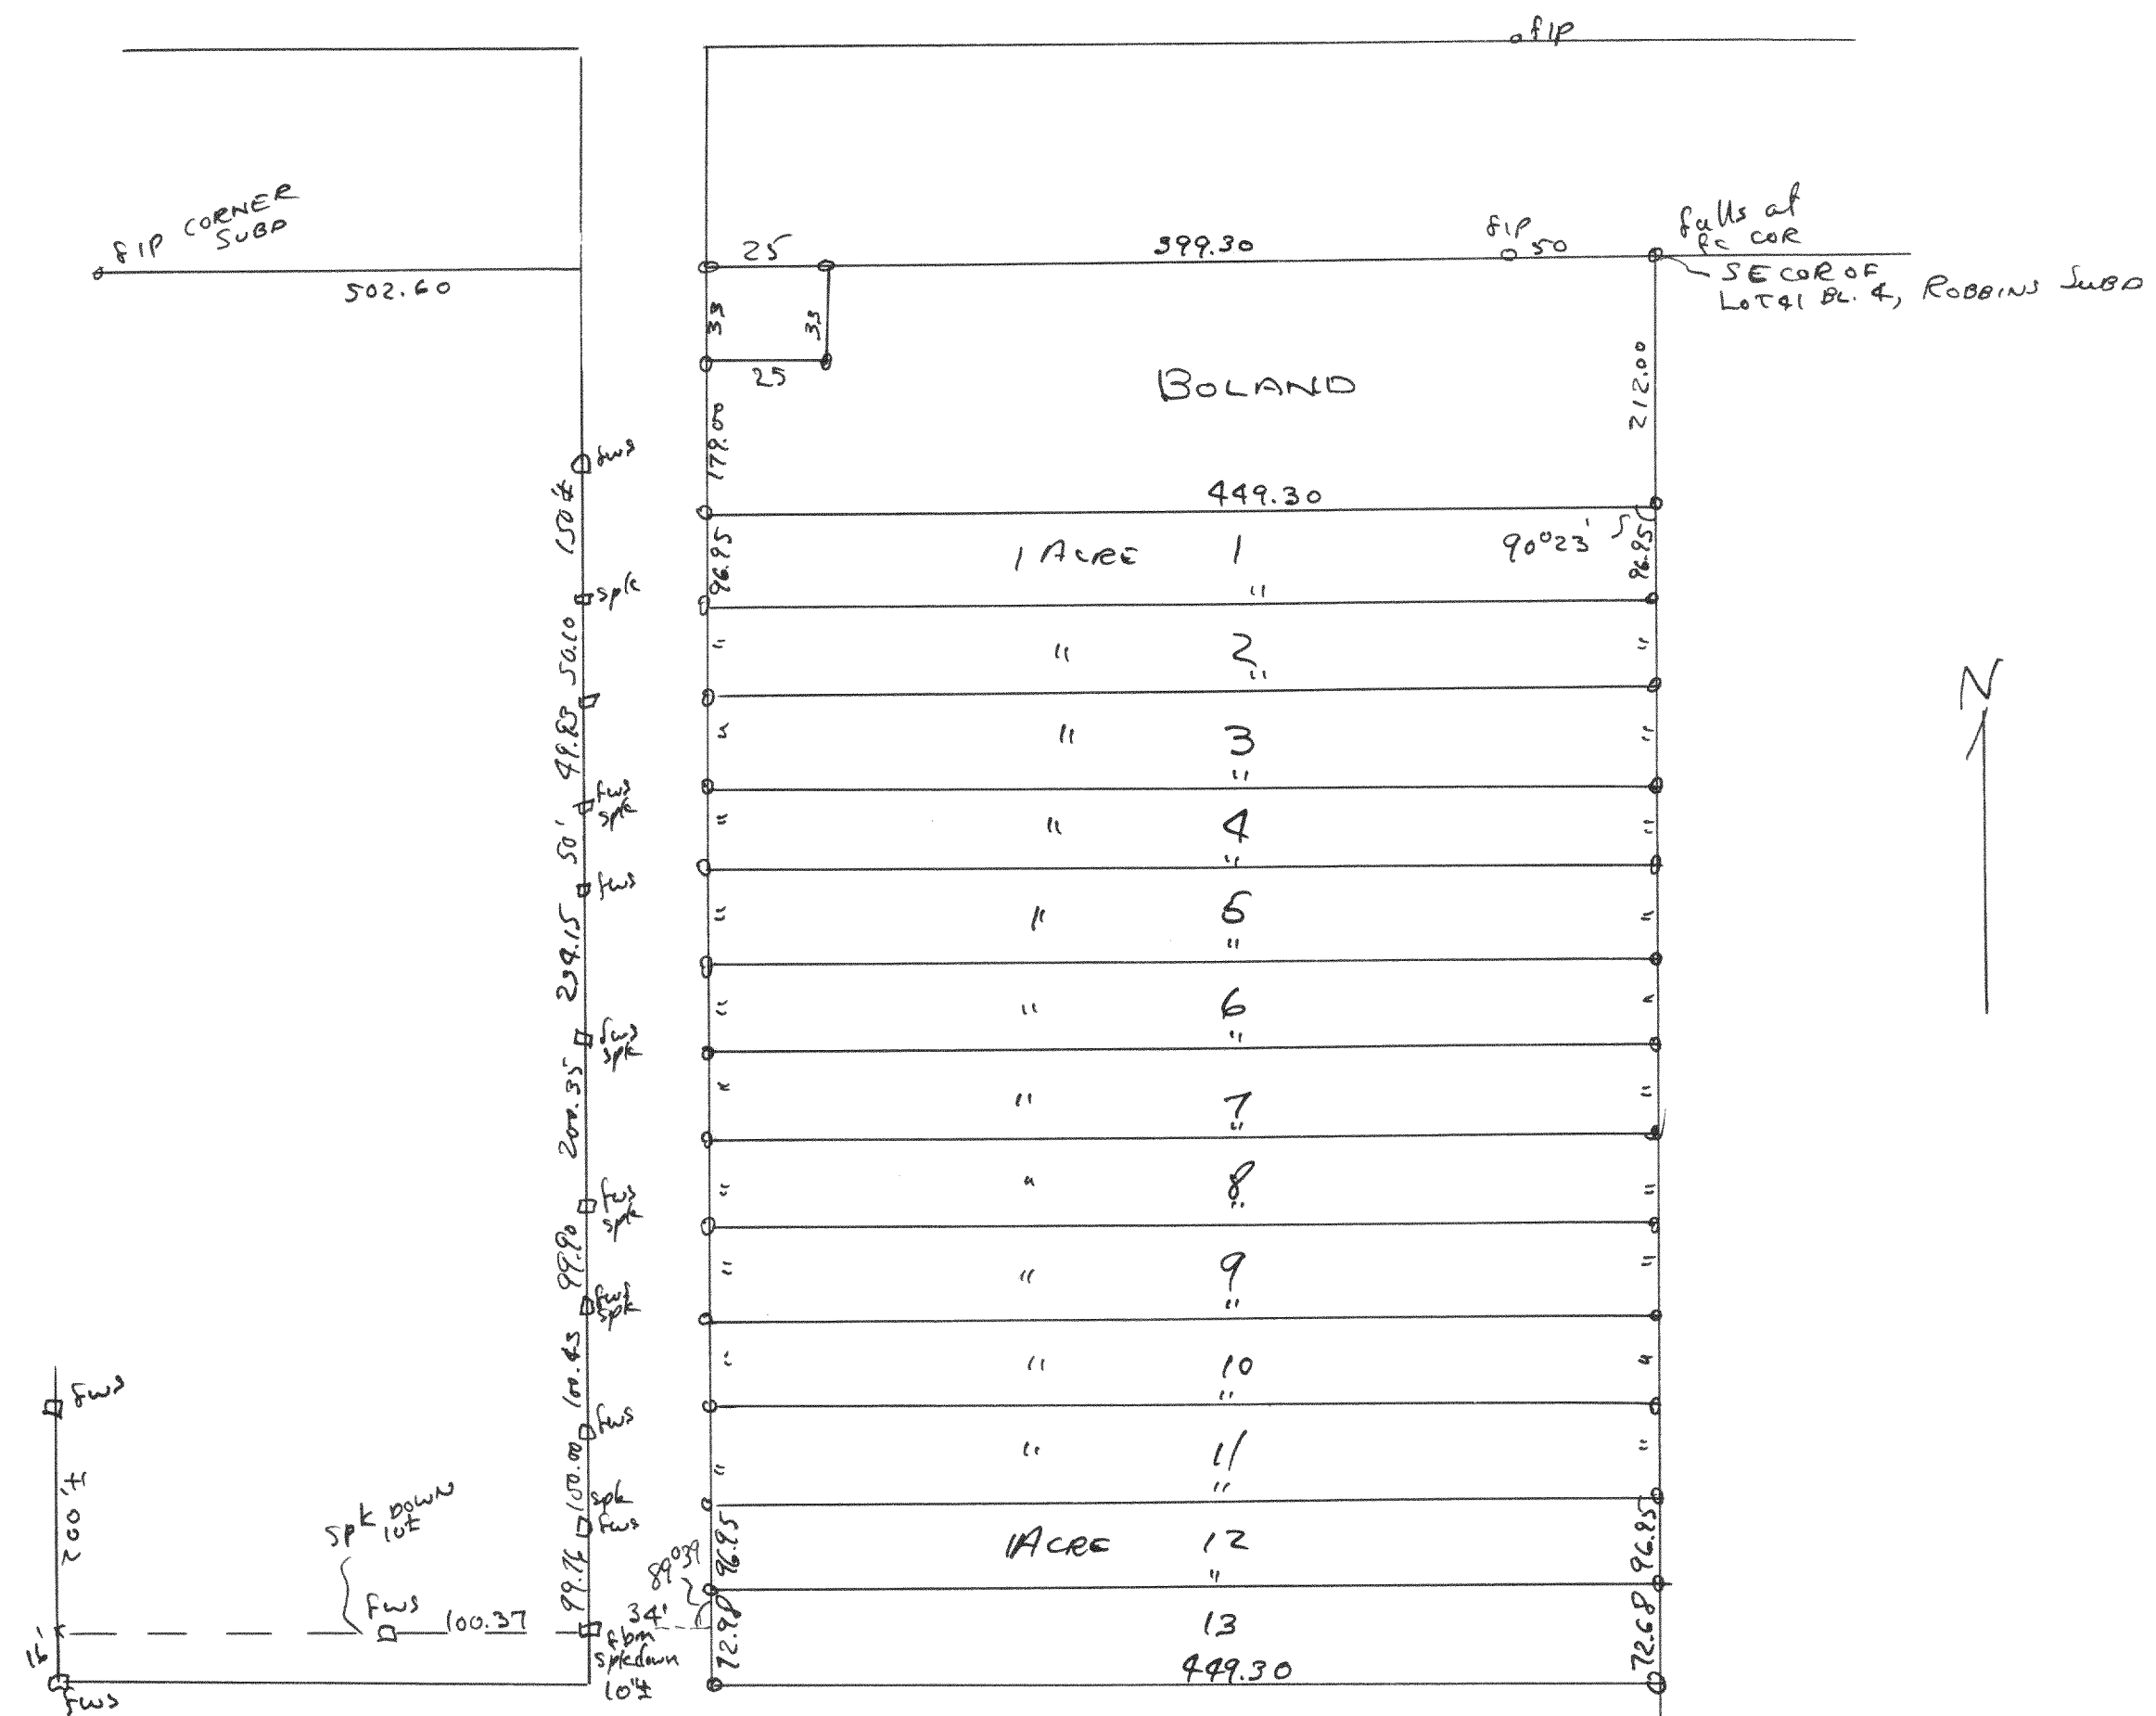

Plat of 1 acre parcels of land located on Robbins Farm
in Section 5, T14N16E, of Walworth Cty, Wis.
June 14, 1950
Lloyd S. Jensen
County Surveyor