



2203

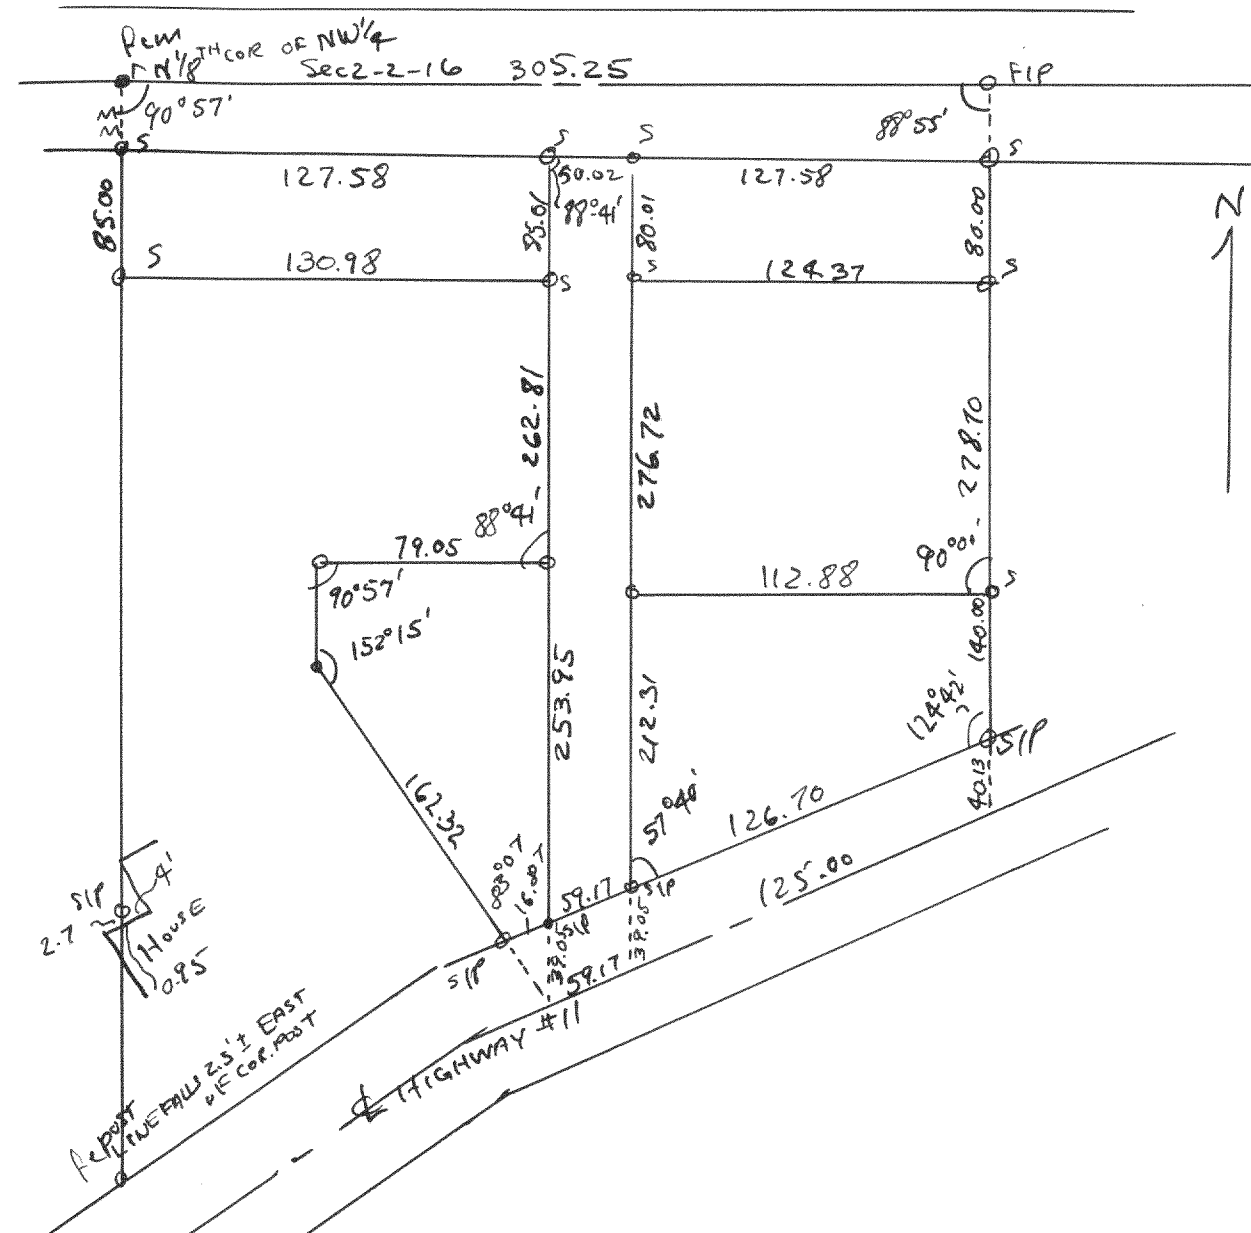

Plat of survey of parcels for Palmer & Dunker located
in the NE 1/4 of NW 1/4 of Sec 2, T2N R16E of Walworth Cty, Wis.
April 10, 1950
Floyd L. Jensen
County Surveyor

2204

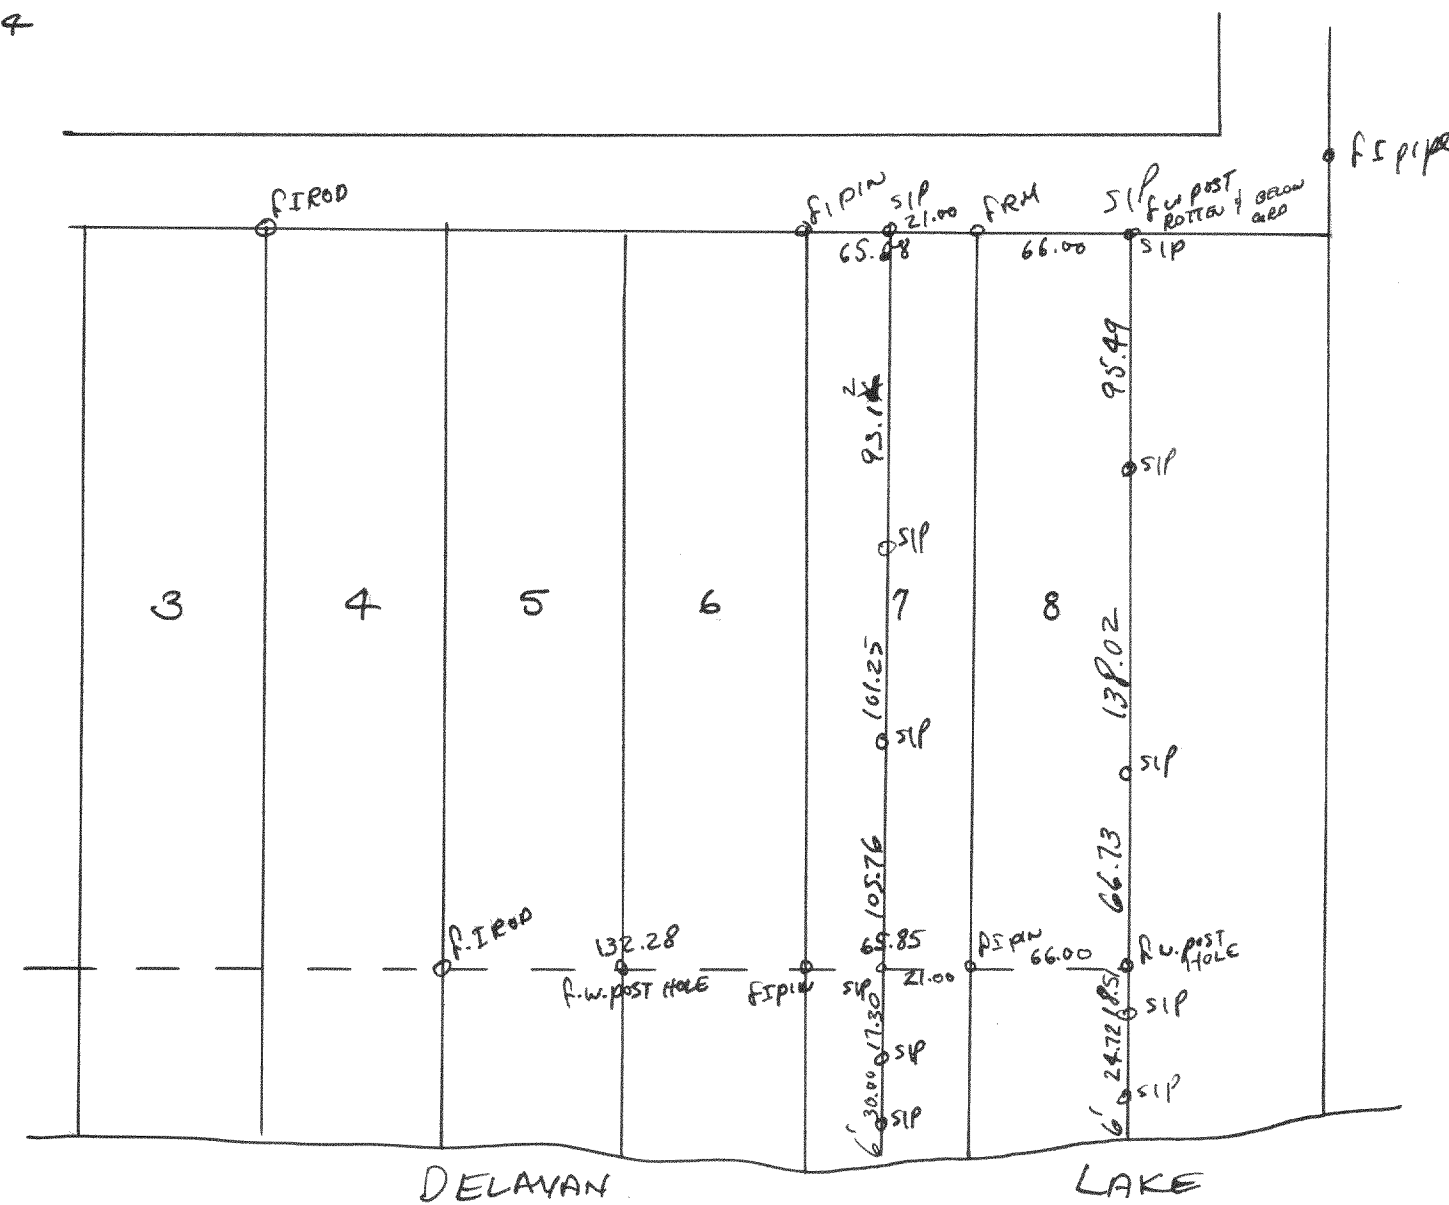

Plat of survey of Lot 8 and part of Lot 7 of
Cedar Point on Delavan Lake located in Sec 28
T2N R16E of Walworth, County, Wisconsin
April 18, 1950
Floyd L. Jensen
County Surveyor