


2205

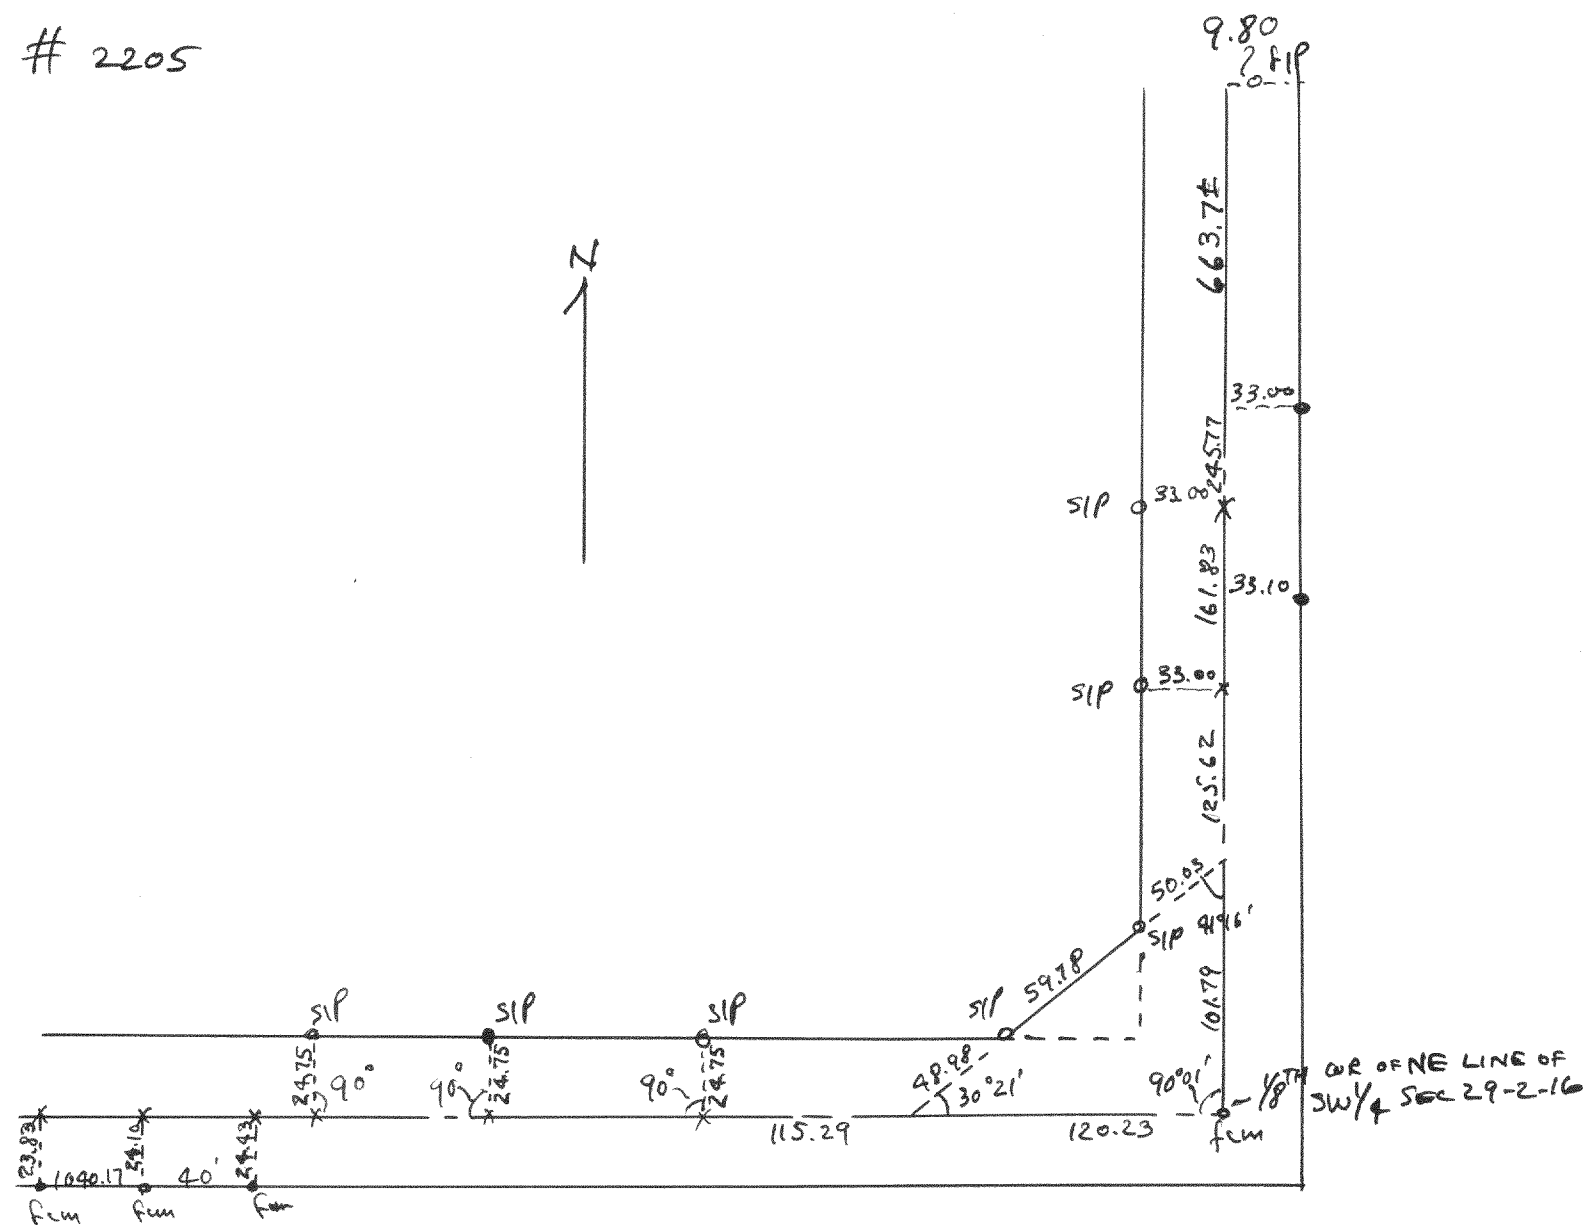


Plat of survey of road line on Little property
located in SW 1/4 of Sec 29, T2N R16E of Walworth Co
Wisconsin.

May 15, 1950

Floyd S. Jensen
County Surveyor

2206

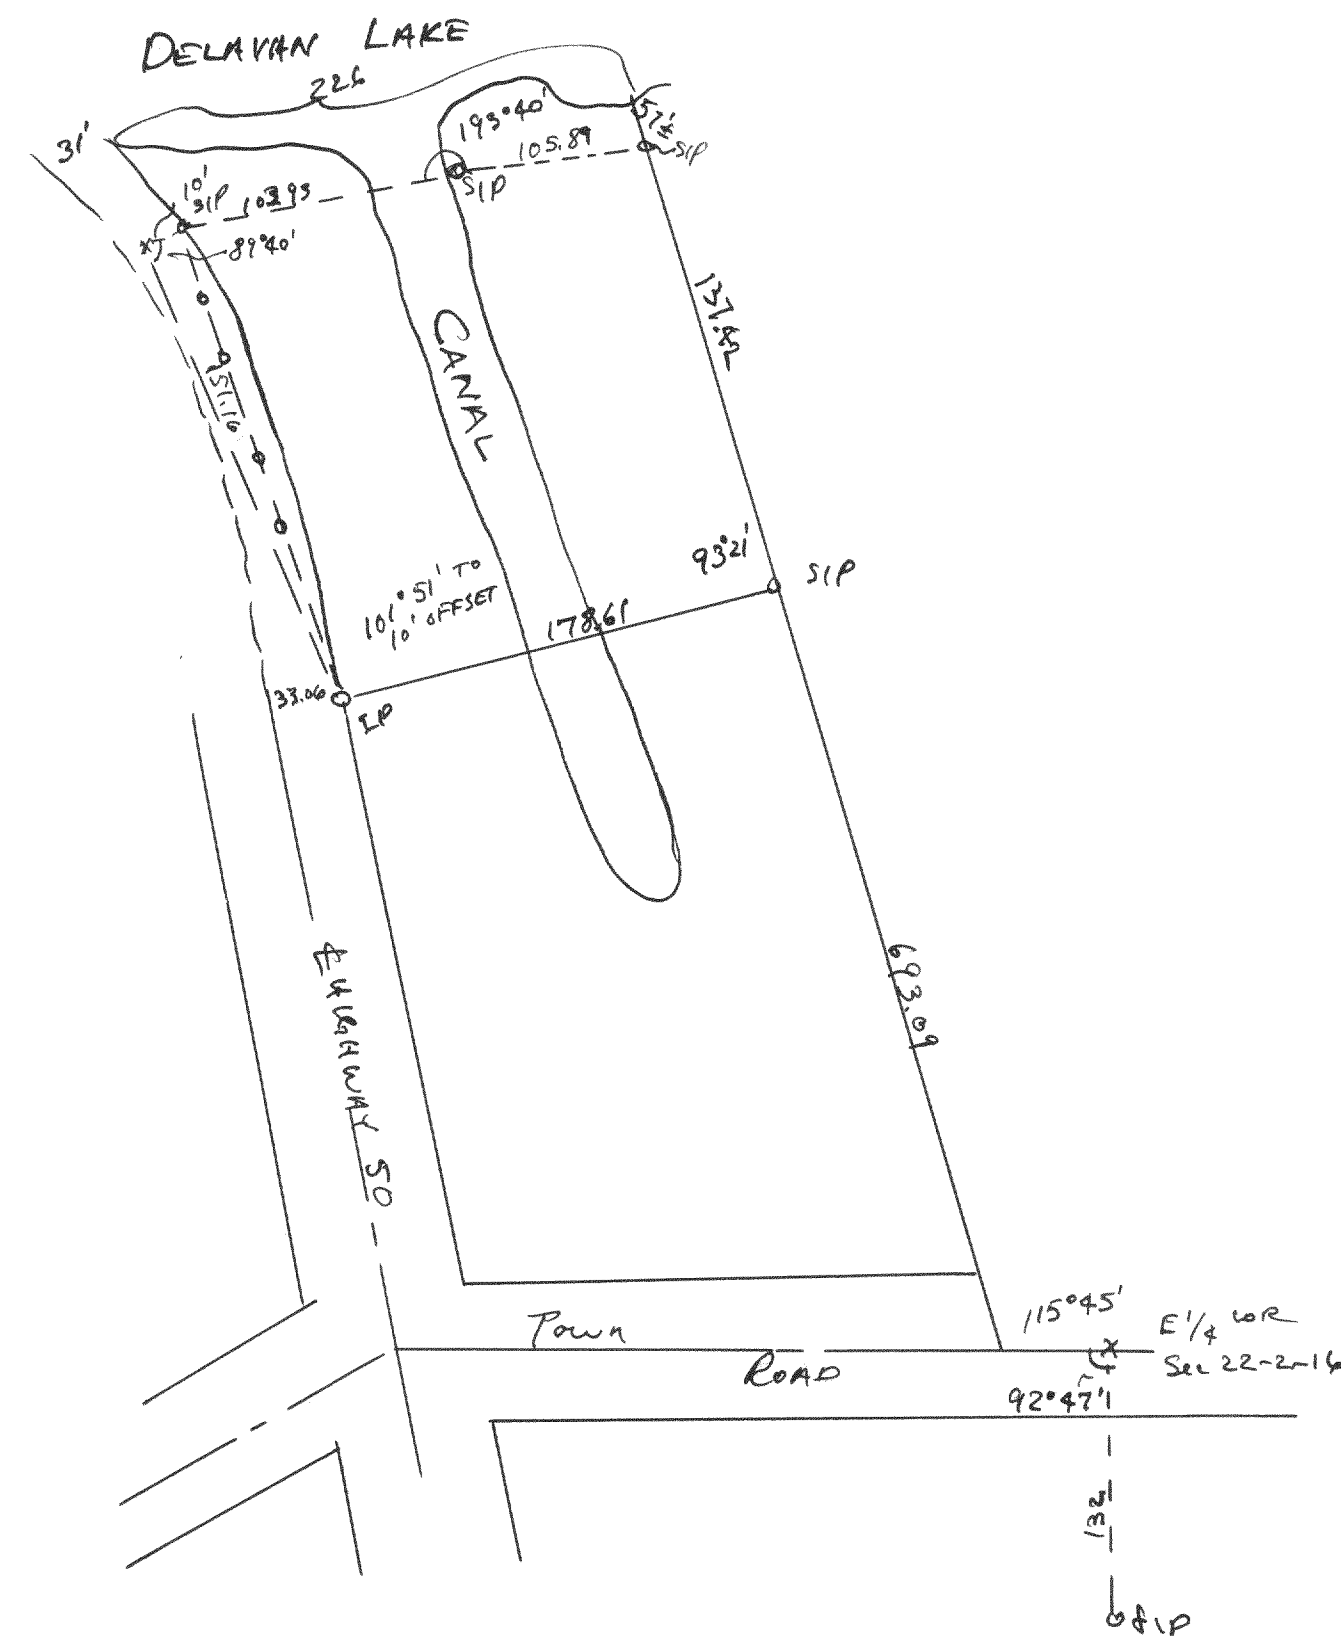

Plat of survey of a parcel of land on Humphrey property
located in NE 1/4 of Sec 23, T2N R16E of Walworth Co, Wis.
May 22, 1950

Floyd S. Jensen
County Surveyor