



2209

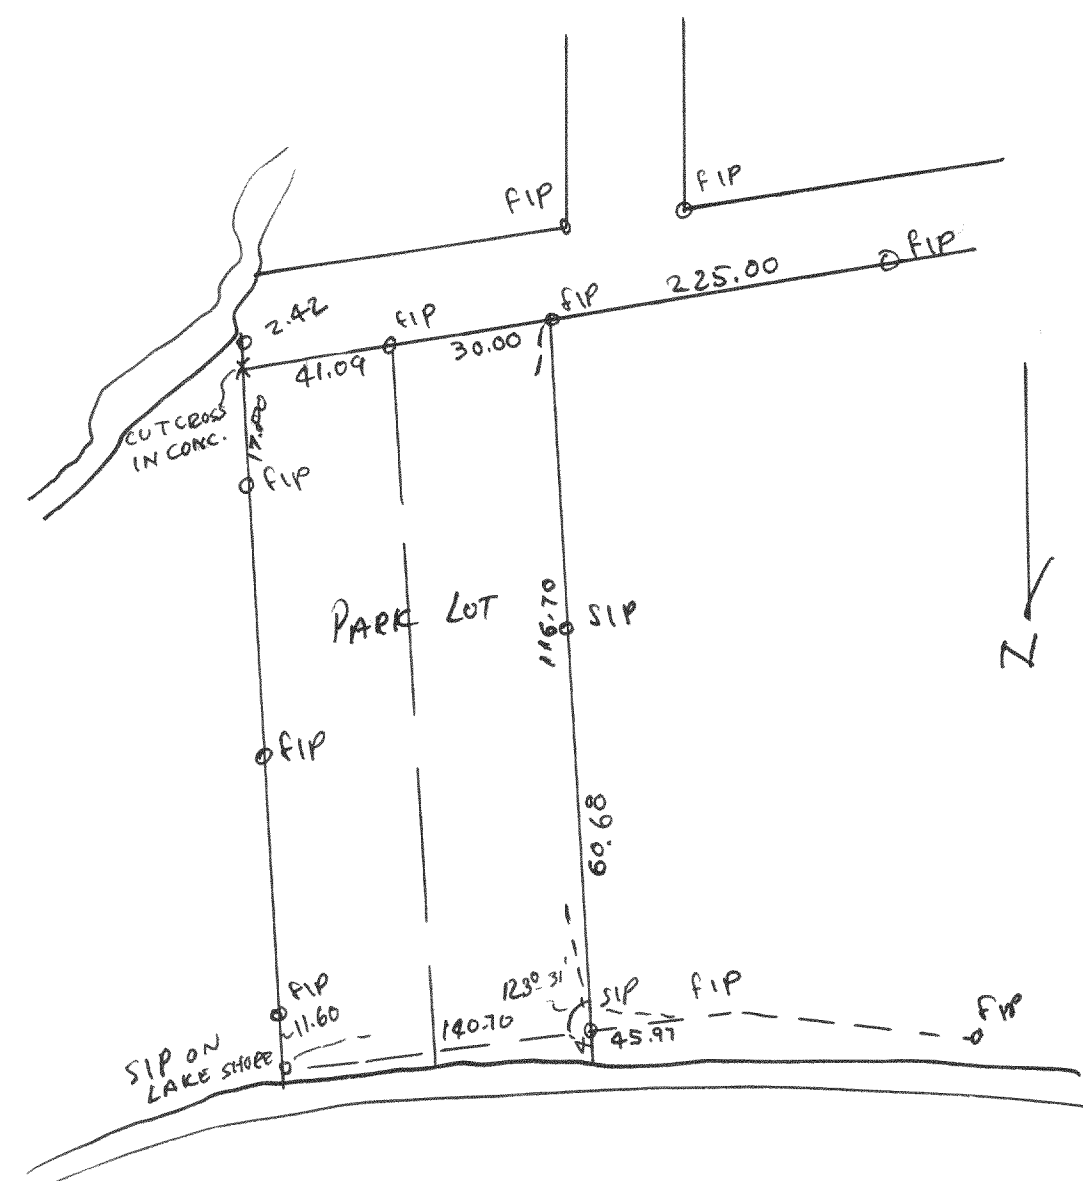

Plat of survey of the Community Park South shore
 Manor, located in Sec 32, T2N R16E of Walworth County, Wis.
 Aug. 4, 1950
 Lloyd L. Jensen
 County Surveyor

2210

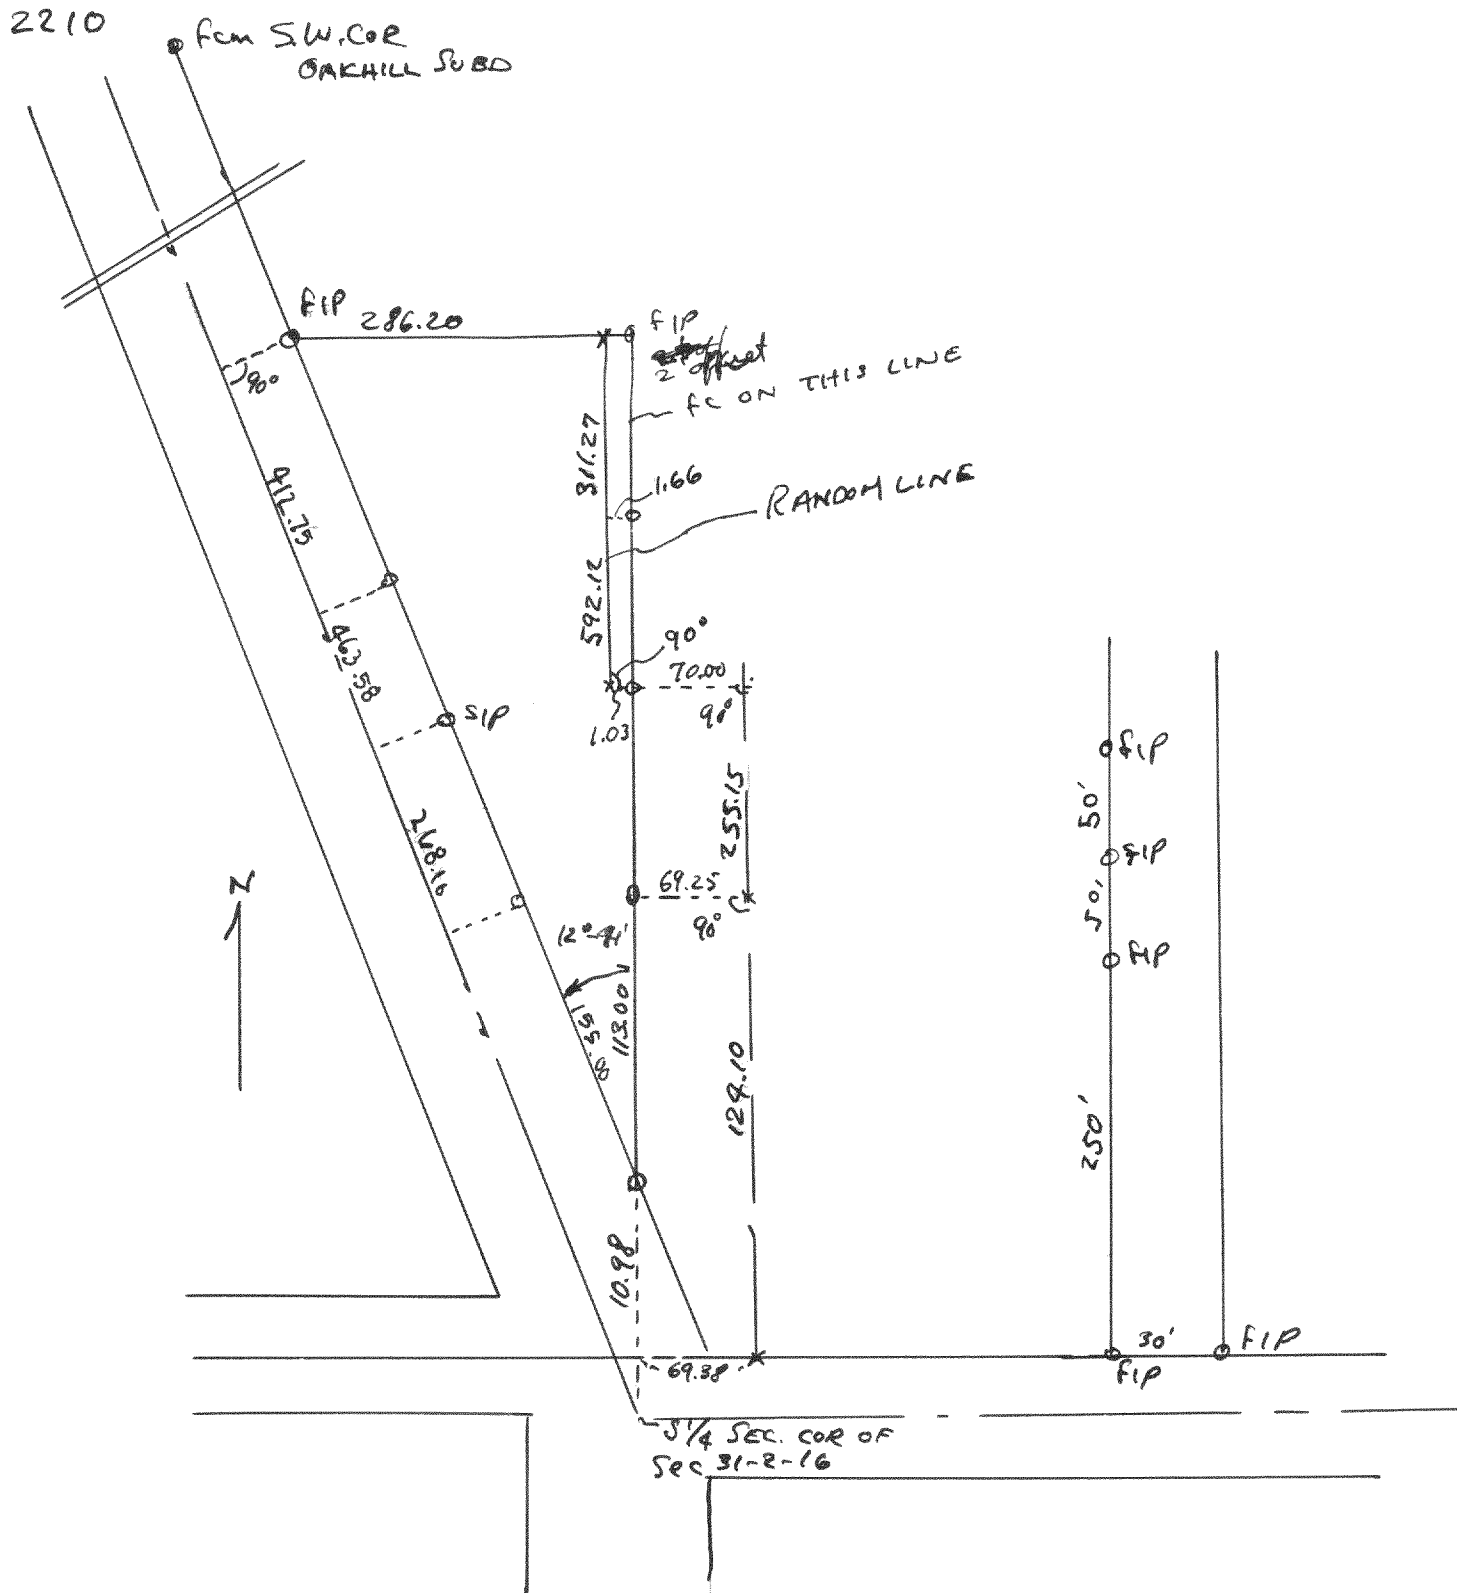

Plat of survey of Krueger property located in the SW 1/4 of Sec 31, T2N R16E,
 of Walworth County, Wis.
 Aug 8, 1950
 Lloyd L. Jensen
 County Surveyor