


#2211

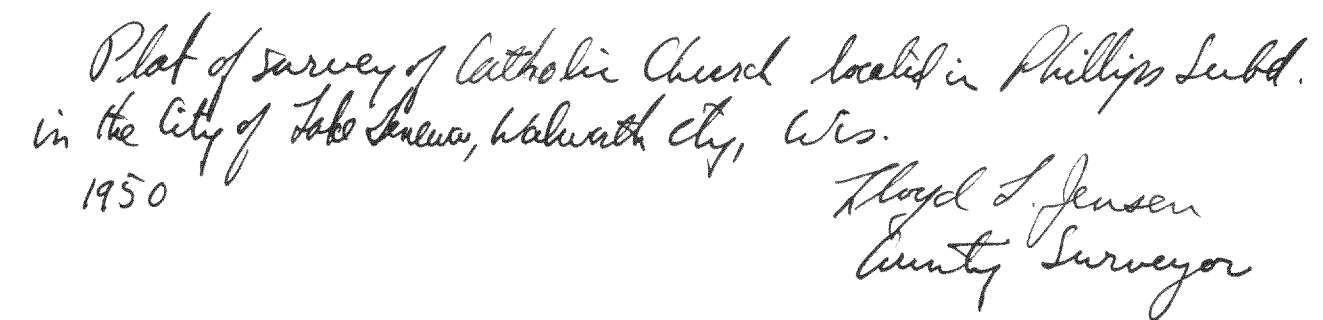

E 1/4 COR
SEC 17, T2N R16 E

N

SIP

92.22

$93^{\circ}05'$

162.96

16.92

89°27'

159.74

0.61 Acres

117.75

285.41

138.66

SIP

96.69

289.92

OSIP

92.51

90°26'

STONE PILLAR

92.56

Hwy 50

Plat of survey of the Wm. Smith Estate located in the
SE 1/4 of Sec 17, T19N16E of Walworth Co., Wis.
Aug 31, 1950