



498

2215

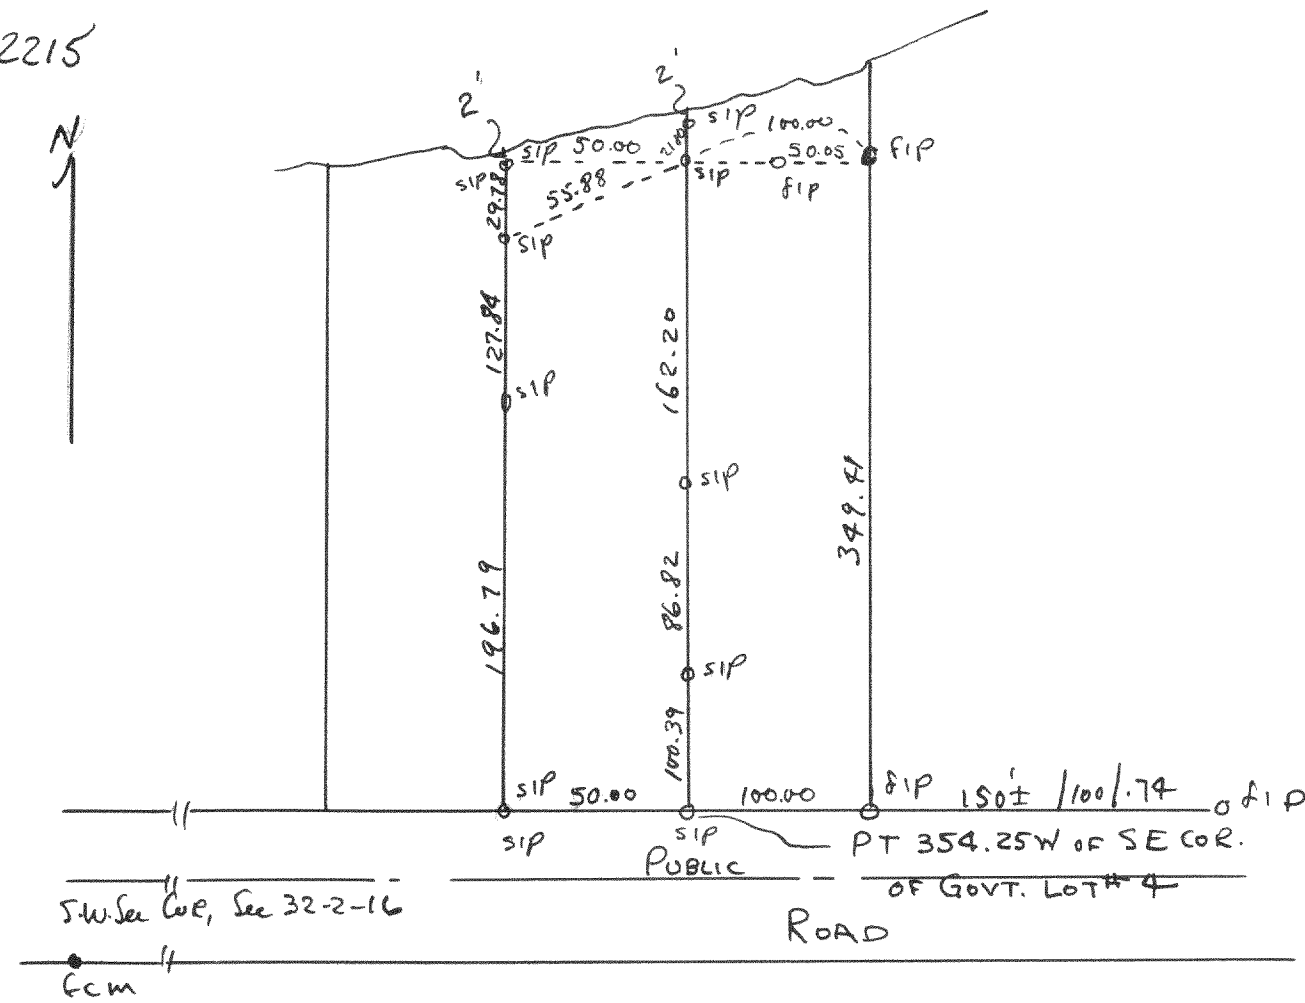

Plat of survey of Branning land located in $\frac{60}{100}$ Lot 4 of
Sec 32, T2N R16E of Walworth Co., Wisconsin
Oct 26, 1950
Lloyd L. Jensen
County Surveyor

2216

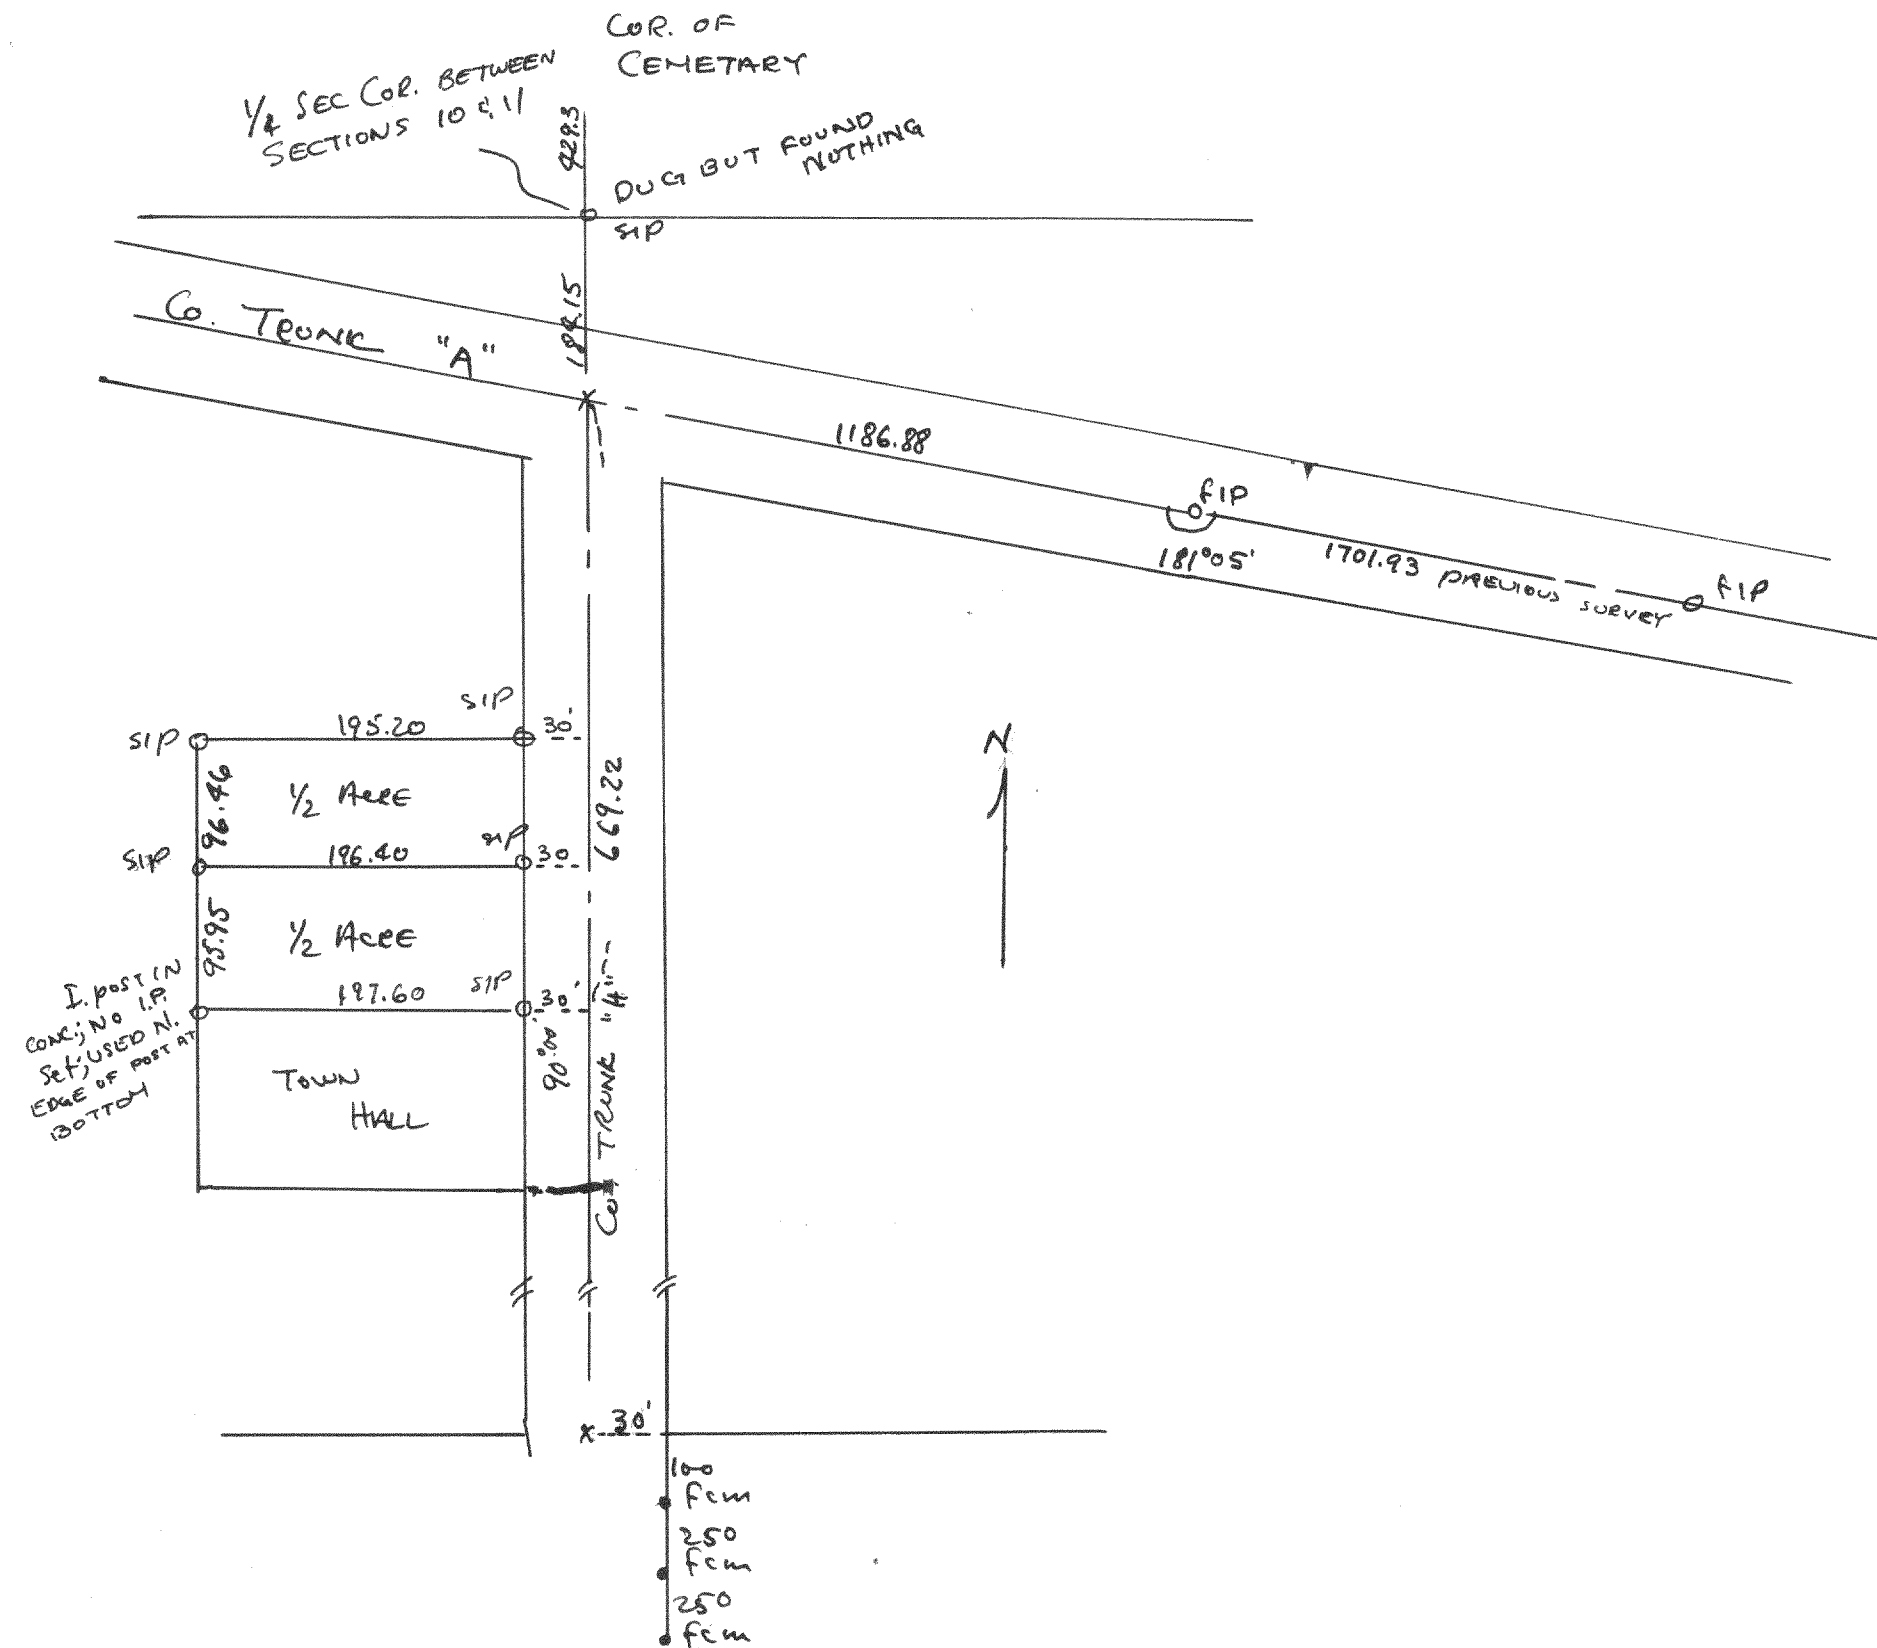

Plat of survey of $\frac{1}{2}$ acre parcels on the Newman Farm located
in the SE $\frac{1}{4}$ Section 10, T3N R16E
May 9, 1950
Lloyd L. Jensen
County Surveyor