


SURVEY NO. 1193

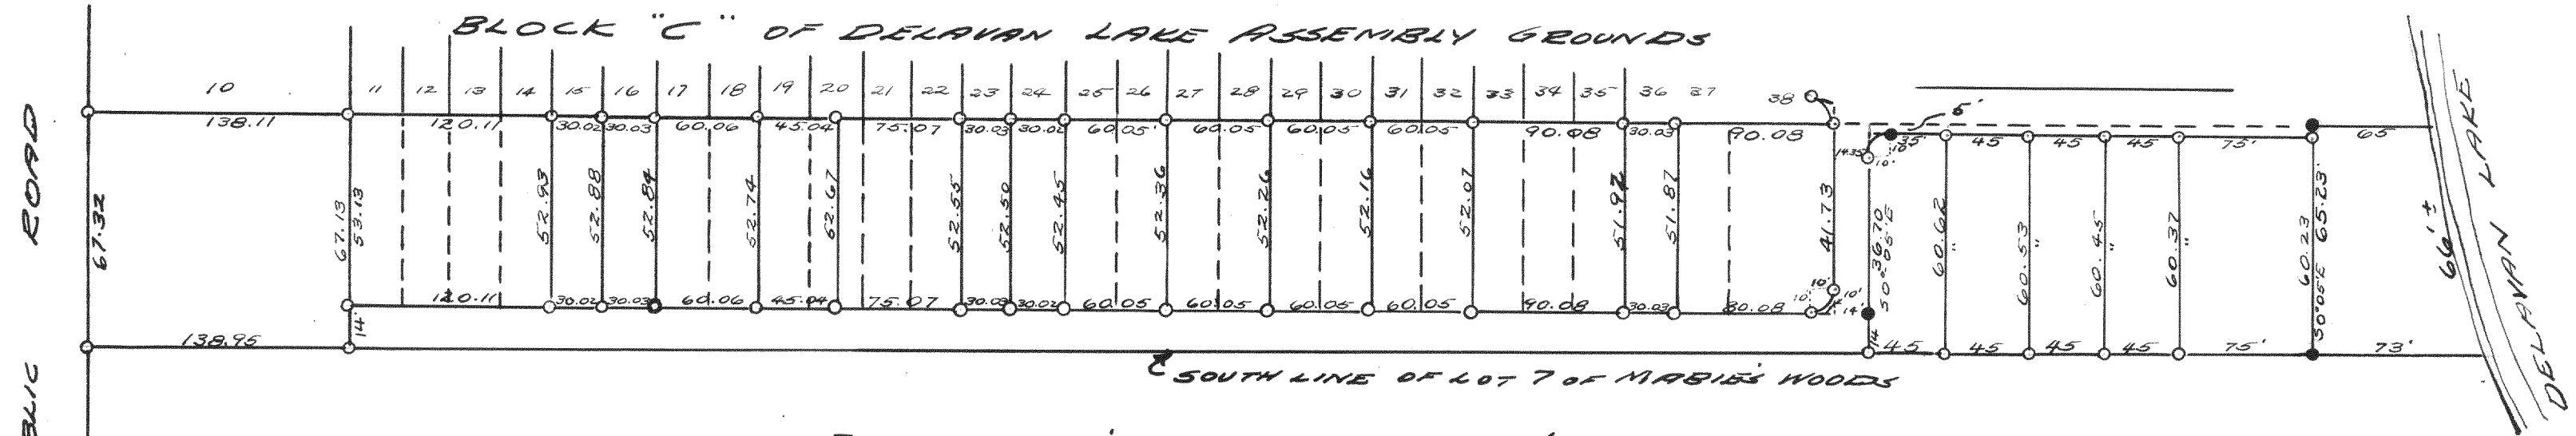


PLAT OF SURVEY OF LOT 7 OF MARBLE WOODS IN THE SE 1/4 OF SECTION 21 T2N R16E, WAL. CO. WISC.

OCT, 1941

Lloyd L. Jensen
N.E.J.

SURVEY NO. 1194

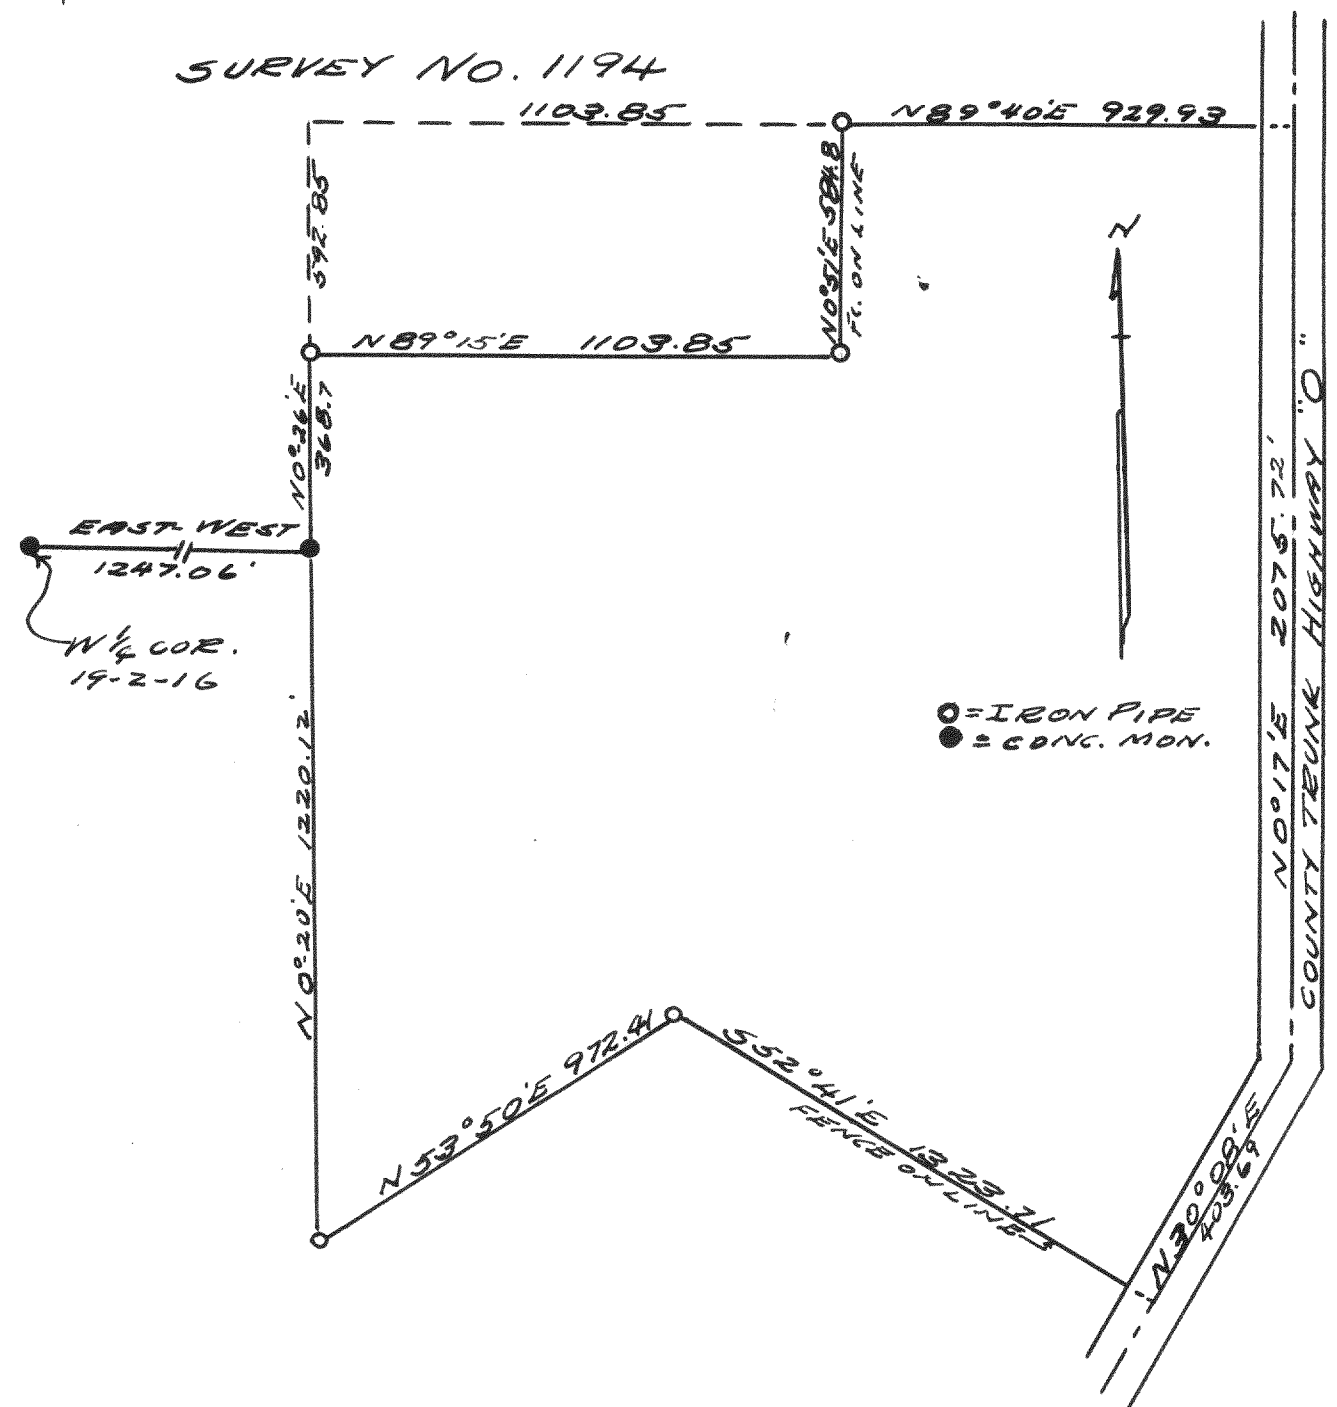


PLAT OF SURVEY OF LAND IN THE E 1/2 & W 1/2 OF SECTION 19 T2N R16E, WAL. CO. WISC.

DEC. 9, 1941

Lloyd L. Jensen
N.E.J.

SURVEY NO. 1195

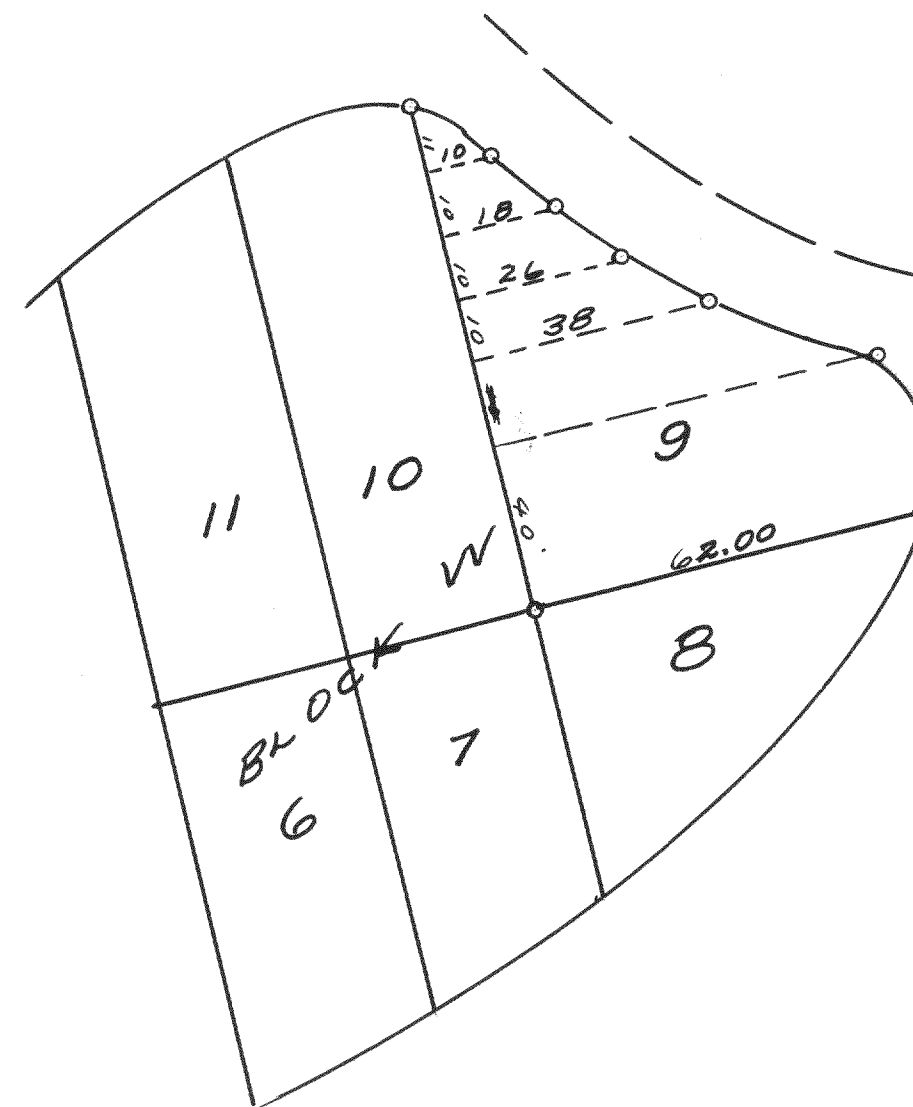

PLAT OF SURVEY OF LOT 9 BLOCK "W" OF DELAVAN LAKE ASSEMBLY GROUNDS, WALWORTH COUNTY, WISCONSIN.

OCT. 1941

Lloyd L. Jensen
N.E.J.