



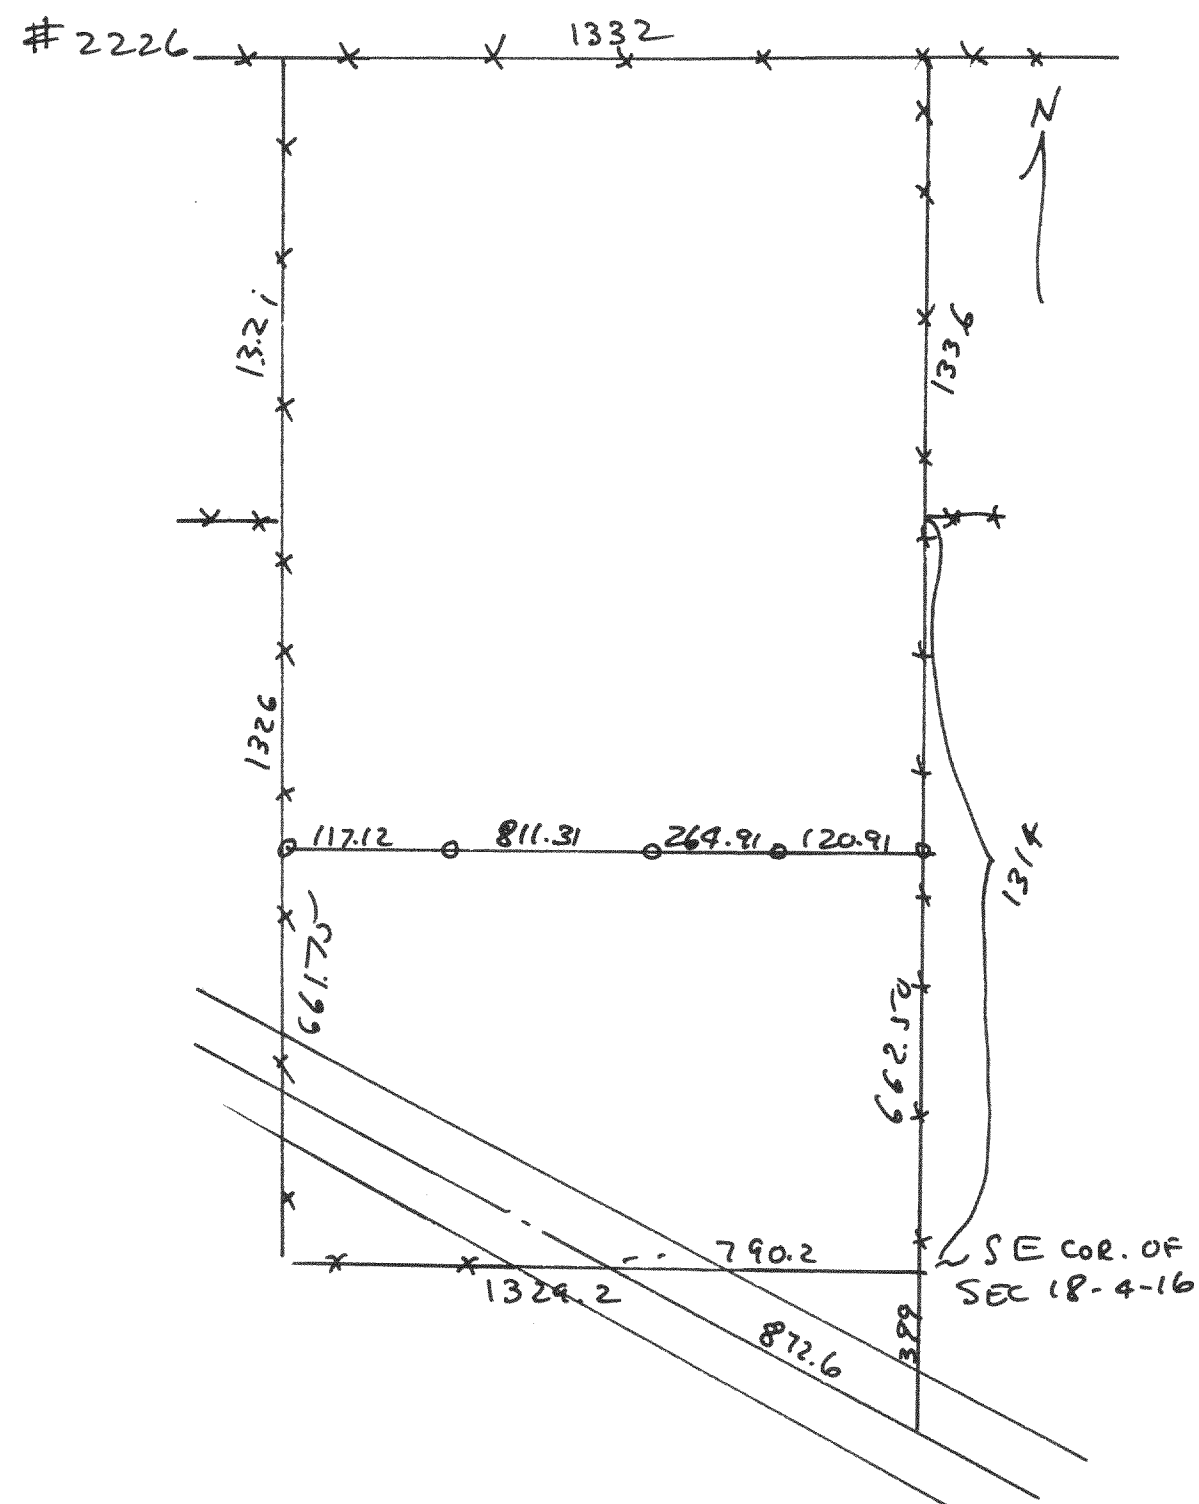

Survey of the $5\frac{1}{4}$ of 80 acres in the E $\frac{1}{2}$ of the SE $\frac{1}{4}$ of Sec 18, T4N R16E of Walworth County, Wis.
June 28, 1950
Lloyd L. Jensen
County Surveyor

2227

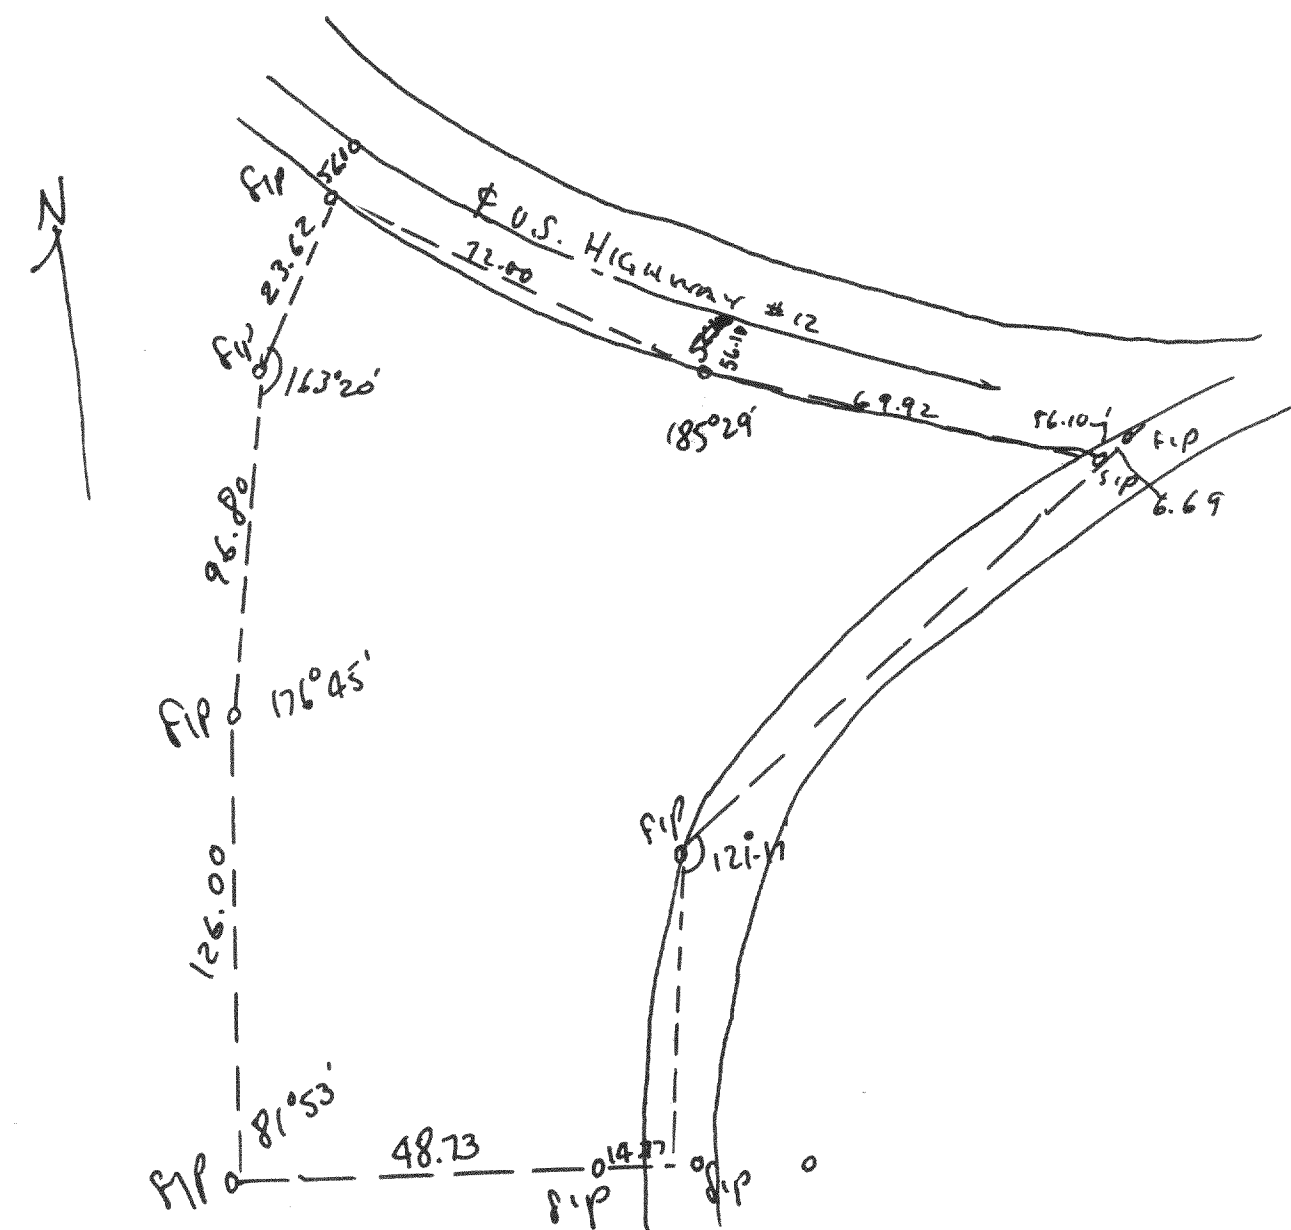

Plat of survey of a parcel of land located in the W $\frac{1}{2}$ of Section 36, T4N R16E, of Walworth County, Wis.
1950
Lloyd L. Jensen
County Surveyor