



2232

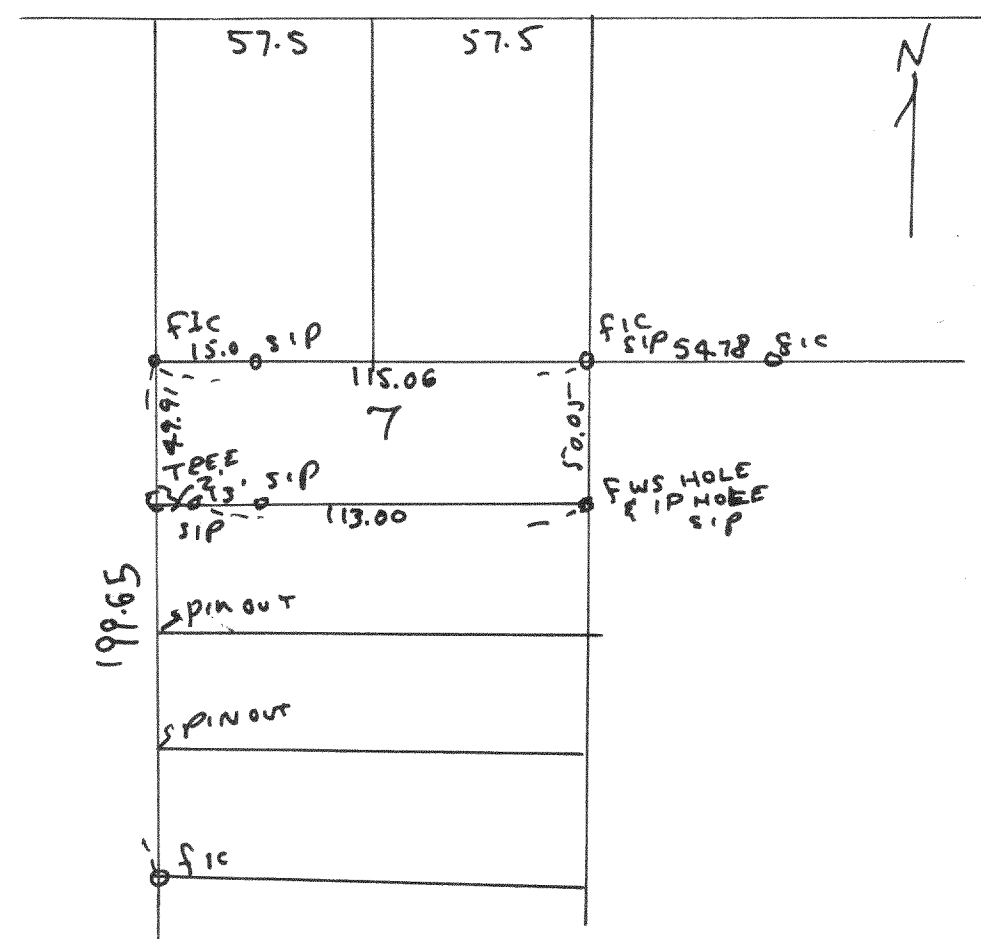

Plat of survey of Lot 7 Bl 25, of Sunset Hills Subd located in the SW $\frac{1}{4}$ of Section 33, T2N R1E of Walworth County, Wis.
April 4, 1950

Floyd L. Jensen
County Surveyor


2234

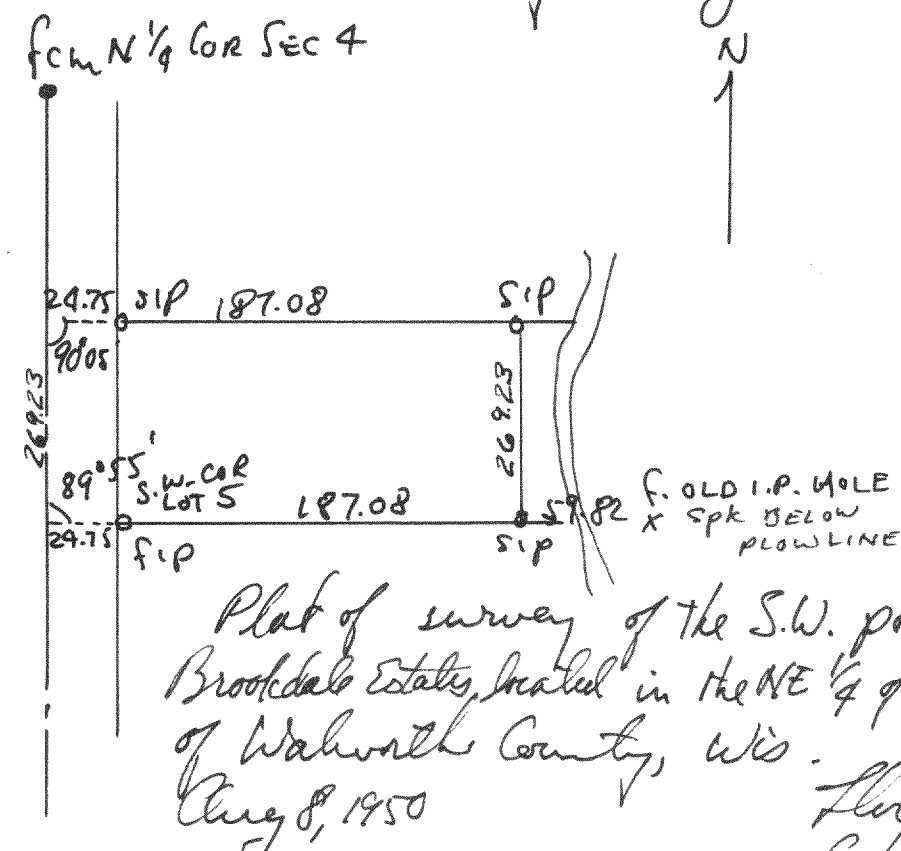

Plat of survey of the S.W. portion of Lot 5 Brookdale Estates located in the NE $\frac{1}{4}$ of Sec 4, T1N R1E of Walworth County, Wis.
Aug 8, 1950

Floyd L. Jensen
County Surveyor


2233

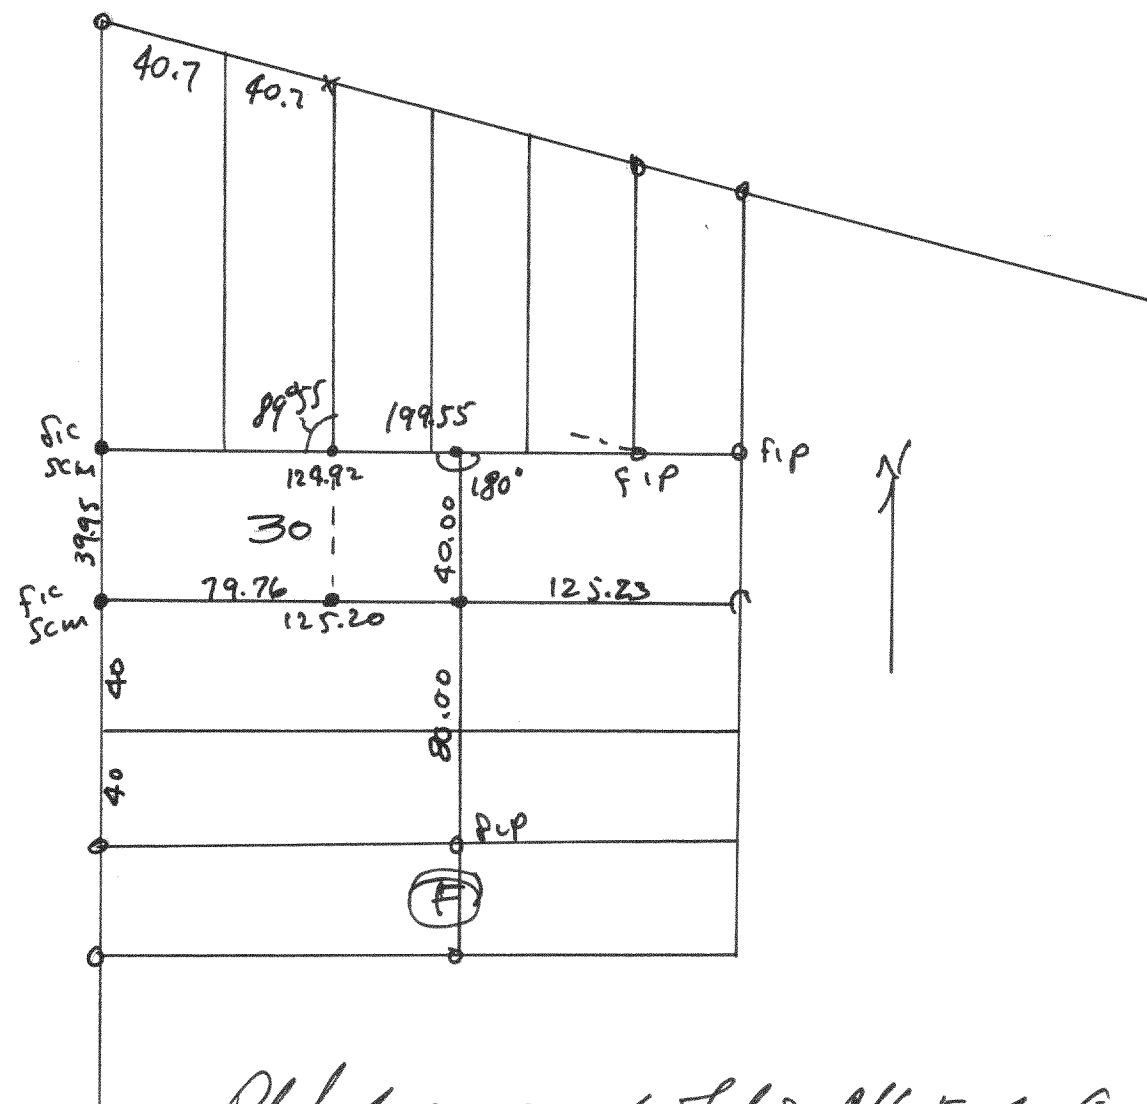

Plat of survey of Lot 30 Blk F of Cisco Beach located in Section 19 T1N R1E of Walworth County, Wis.
July 1950

Floyd L. Jensen
County Surveyor

2235

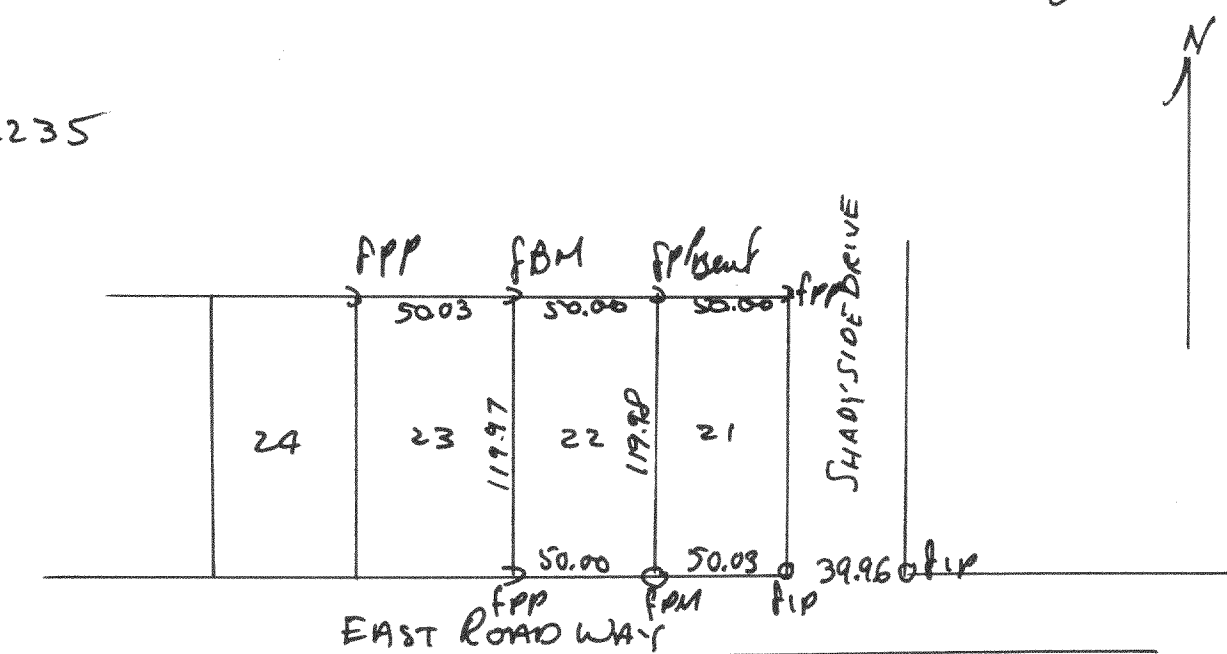

Plat of survey of Lot 22, Block 4, Sunset Hills Subd. located in Sec 4, T1N R1E Walworth County, Wis.
Sept 30, 1950

Floyd L. Jensen
County Surveyor