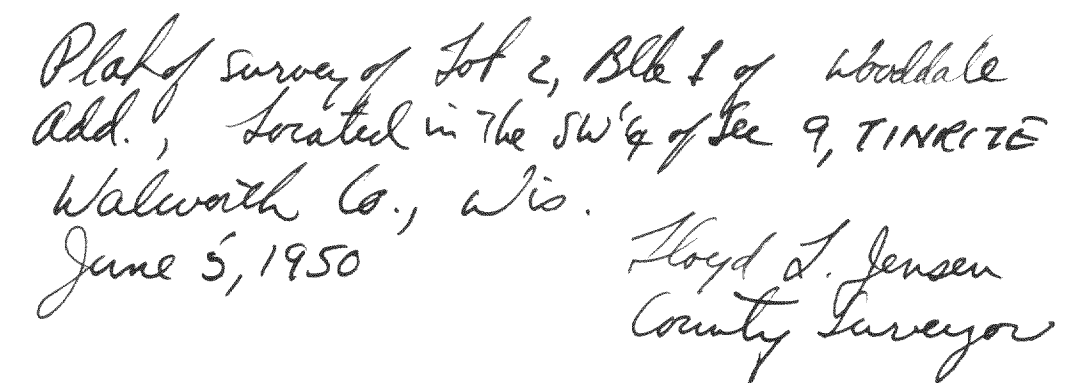


#2238

[illegible]

Plat of proposed road & division of Jacobs Property purchased from the
Hunt Estates located in Sec 11, T19N17E of Walworth Co., Wis.
Dec 28, 1949
Floyd L. Jensen
County Surveyor