



#2240

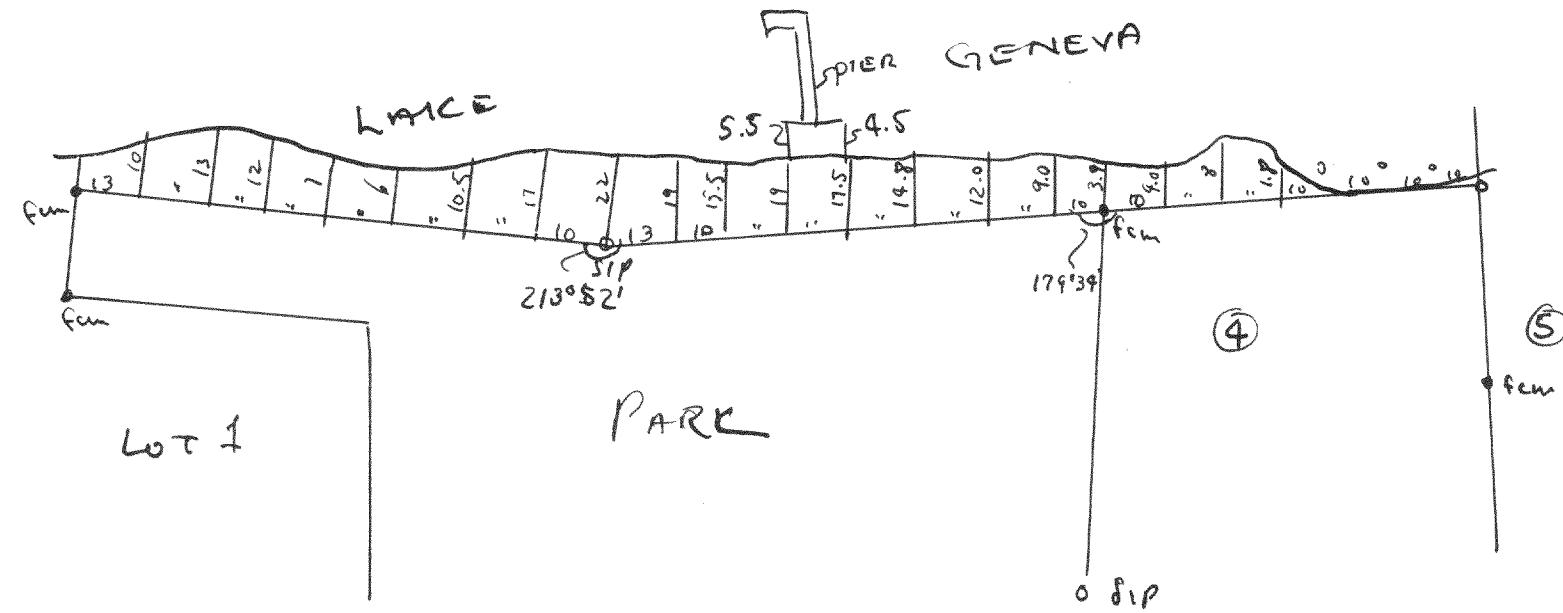


Plat of survey of the lake shore along the park area of Wooddale Subd located in Sec 9 T1N R1E, Walworth Co., Wis.
Sept 24, 1950
Hoyd S. Jensen
County Surveyor

#2241

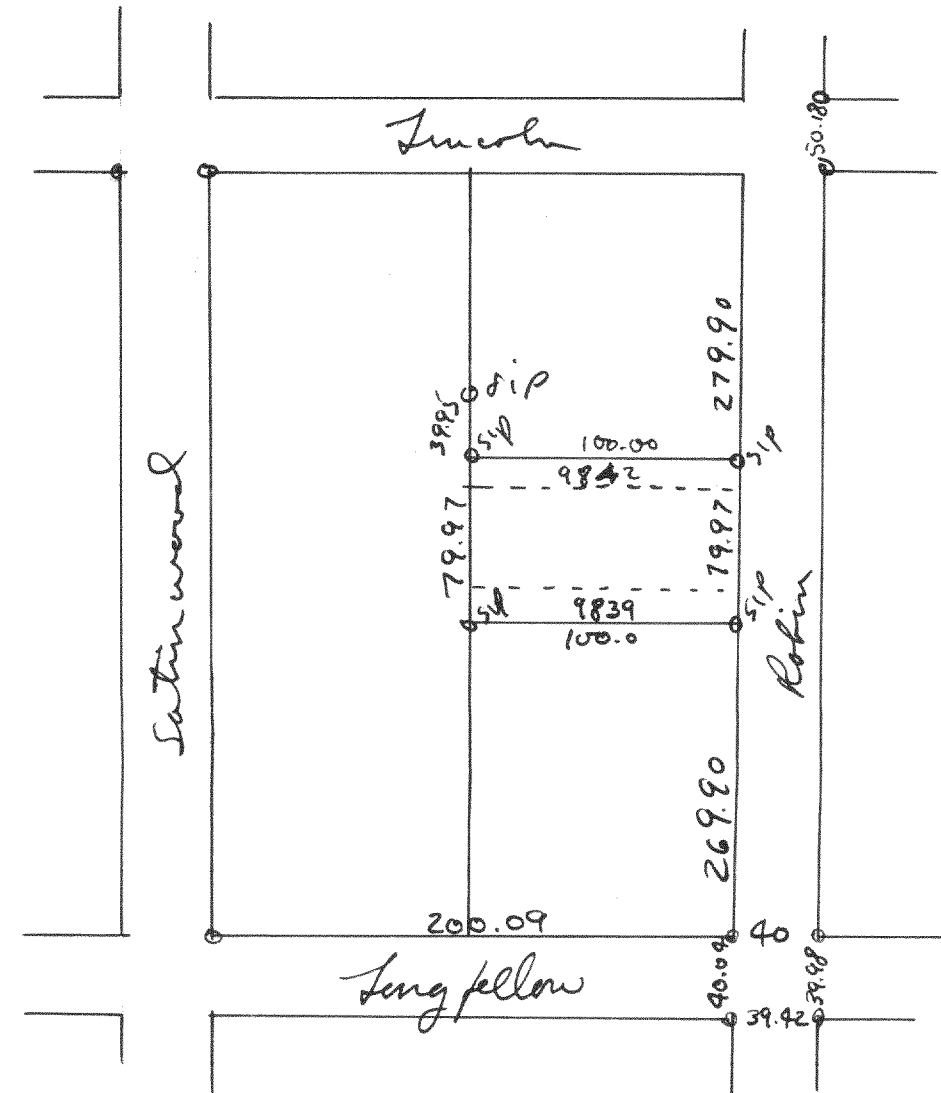


Plat of survey of lots 9839-9842, Lake Como Beach Subd located in Sec. 21 & 22, T2N R1E of Walworth Co., Wis.
April 5, 1950
Hoyd S. Jensen
County Surveyor

#2242

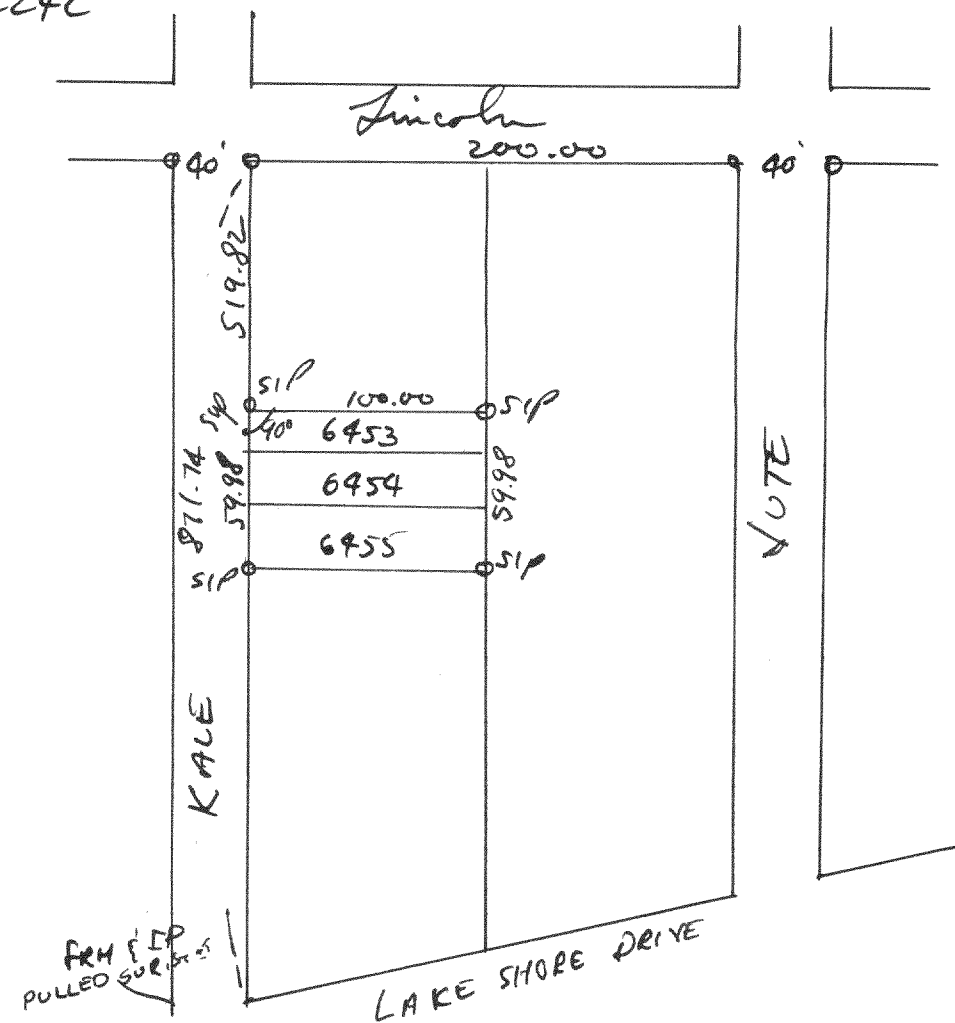

Plat of survey of lots 6453-6455 Lake Como Beach Subd. located in Sec 21 & 22, T2N R1E of Walworth County, Wis.
April 5, 1950
Hoyd S. Jensen
County Surveyor

#2243

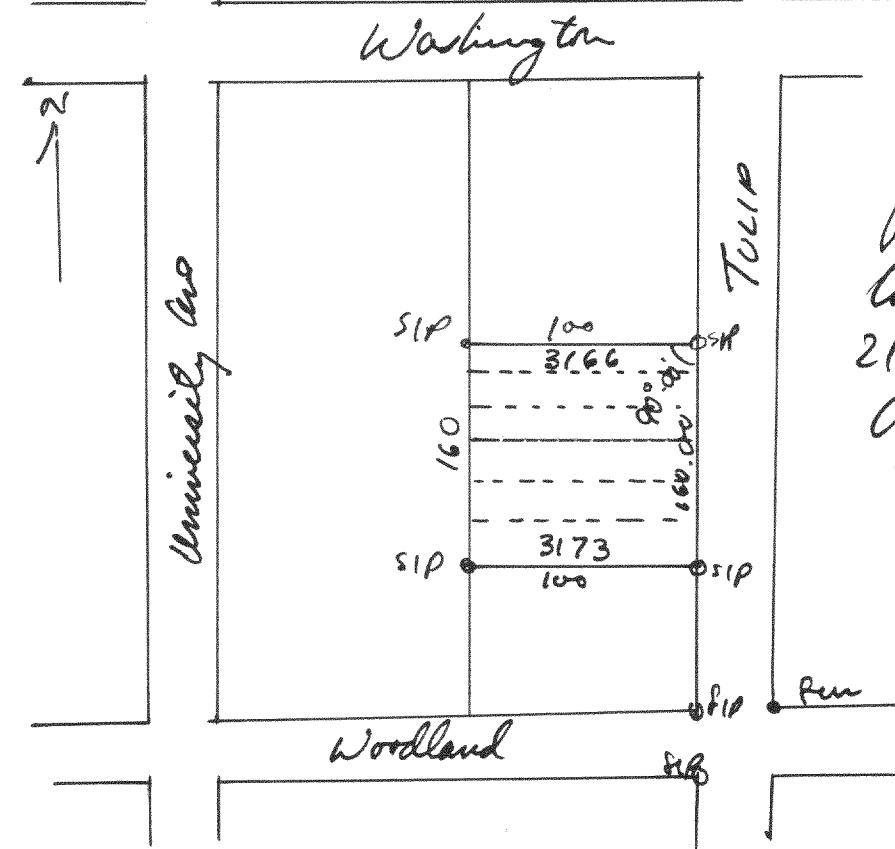

Plat of survey of lots 3166, 3173, Lake Como Beach Subd located in Sec 21 & 22, T2N R1E of Wal. Co., Wis.
April 5, 1950
Hoyd S. Jensen
County Surveyor