



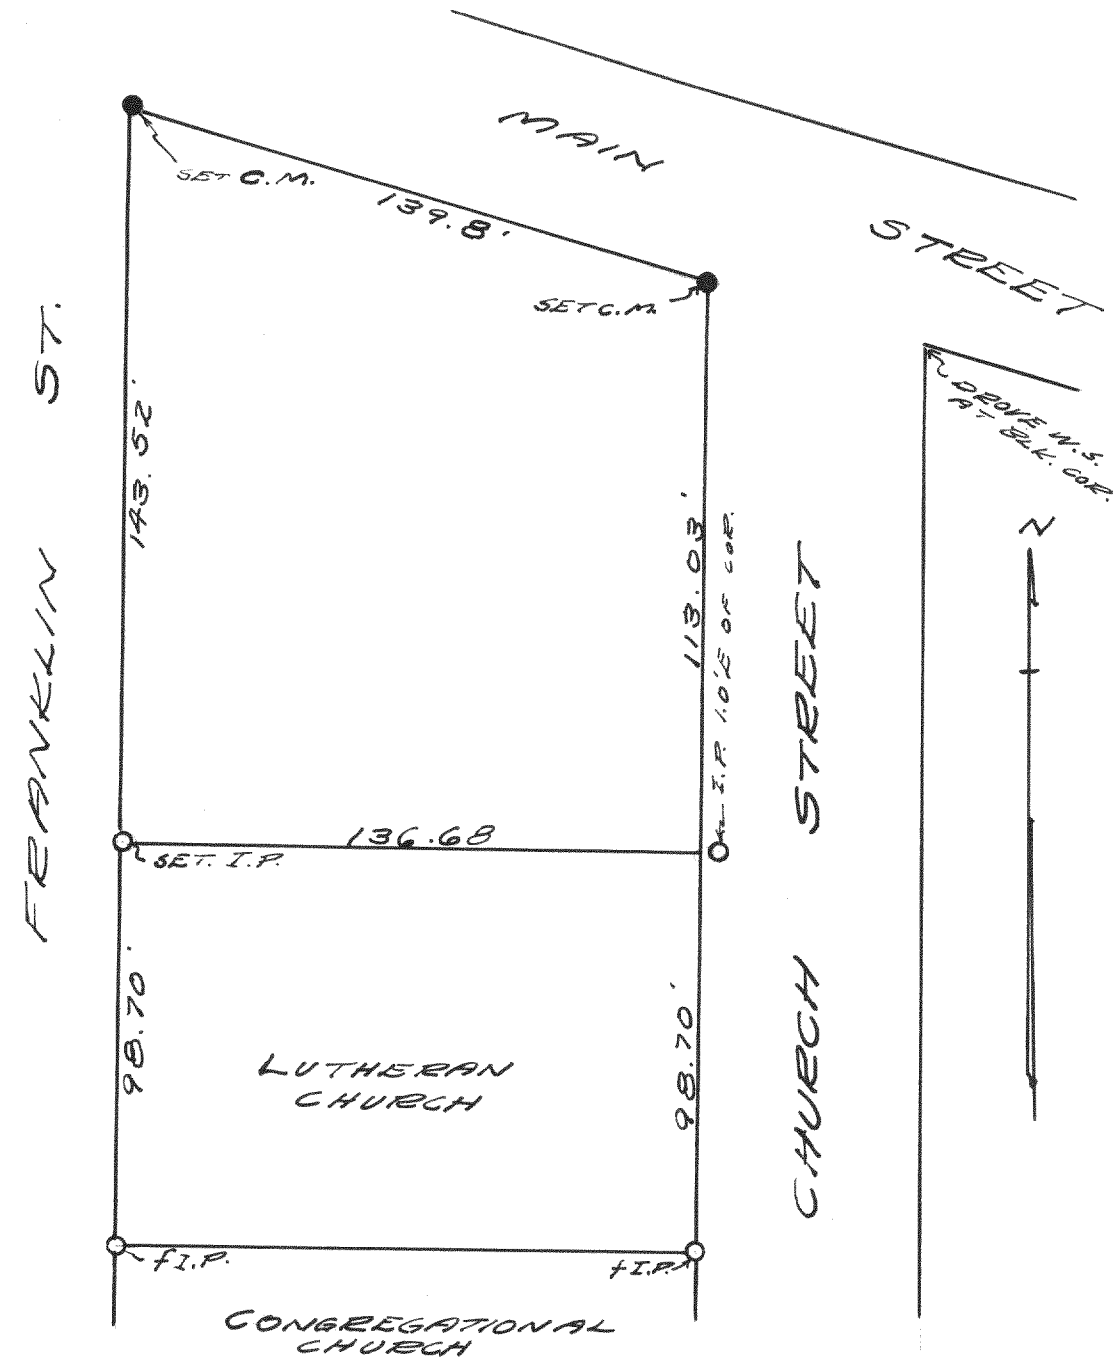

PLAT OF SURVEY OF PART OF THE
SW 1/4 OF SECTION 4 T4N R15E IN
THE CITY OF WHITEWATER, WALWORTH
COUNTY, WISCONSIN
MAY 13, 1941
Lloyd L. Jensen
R.E.G.

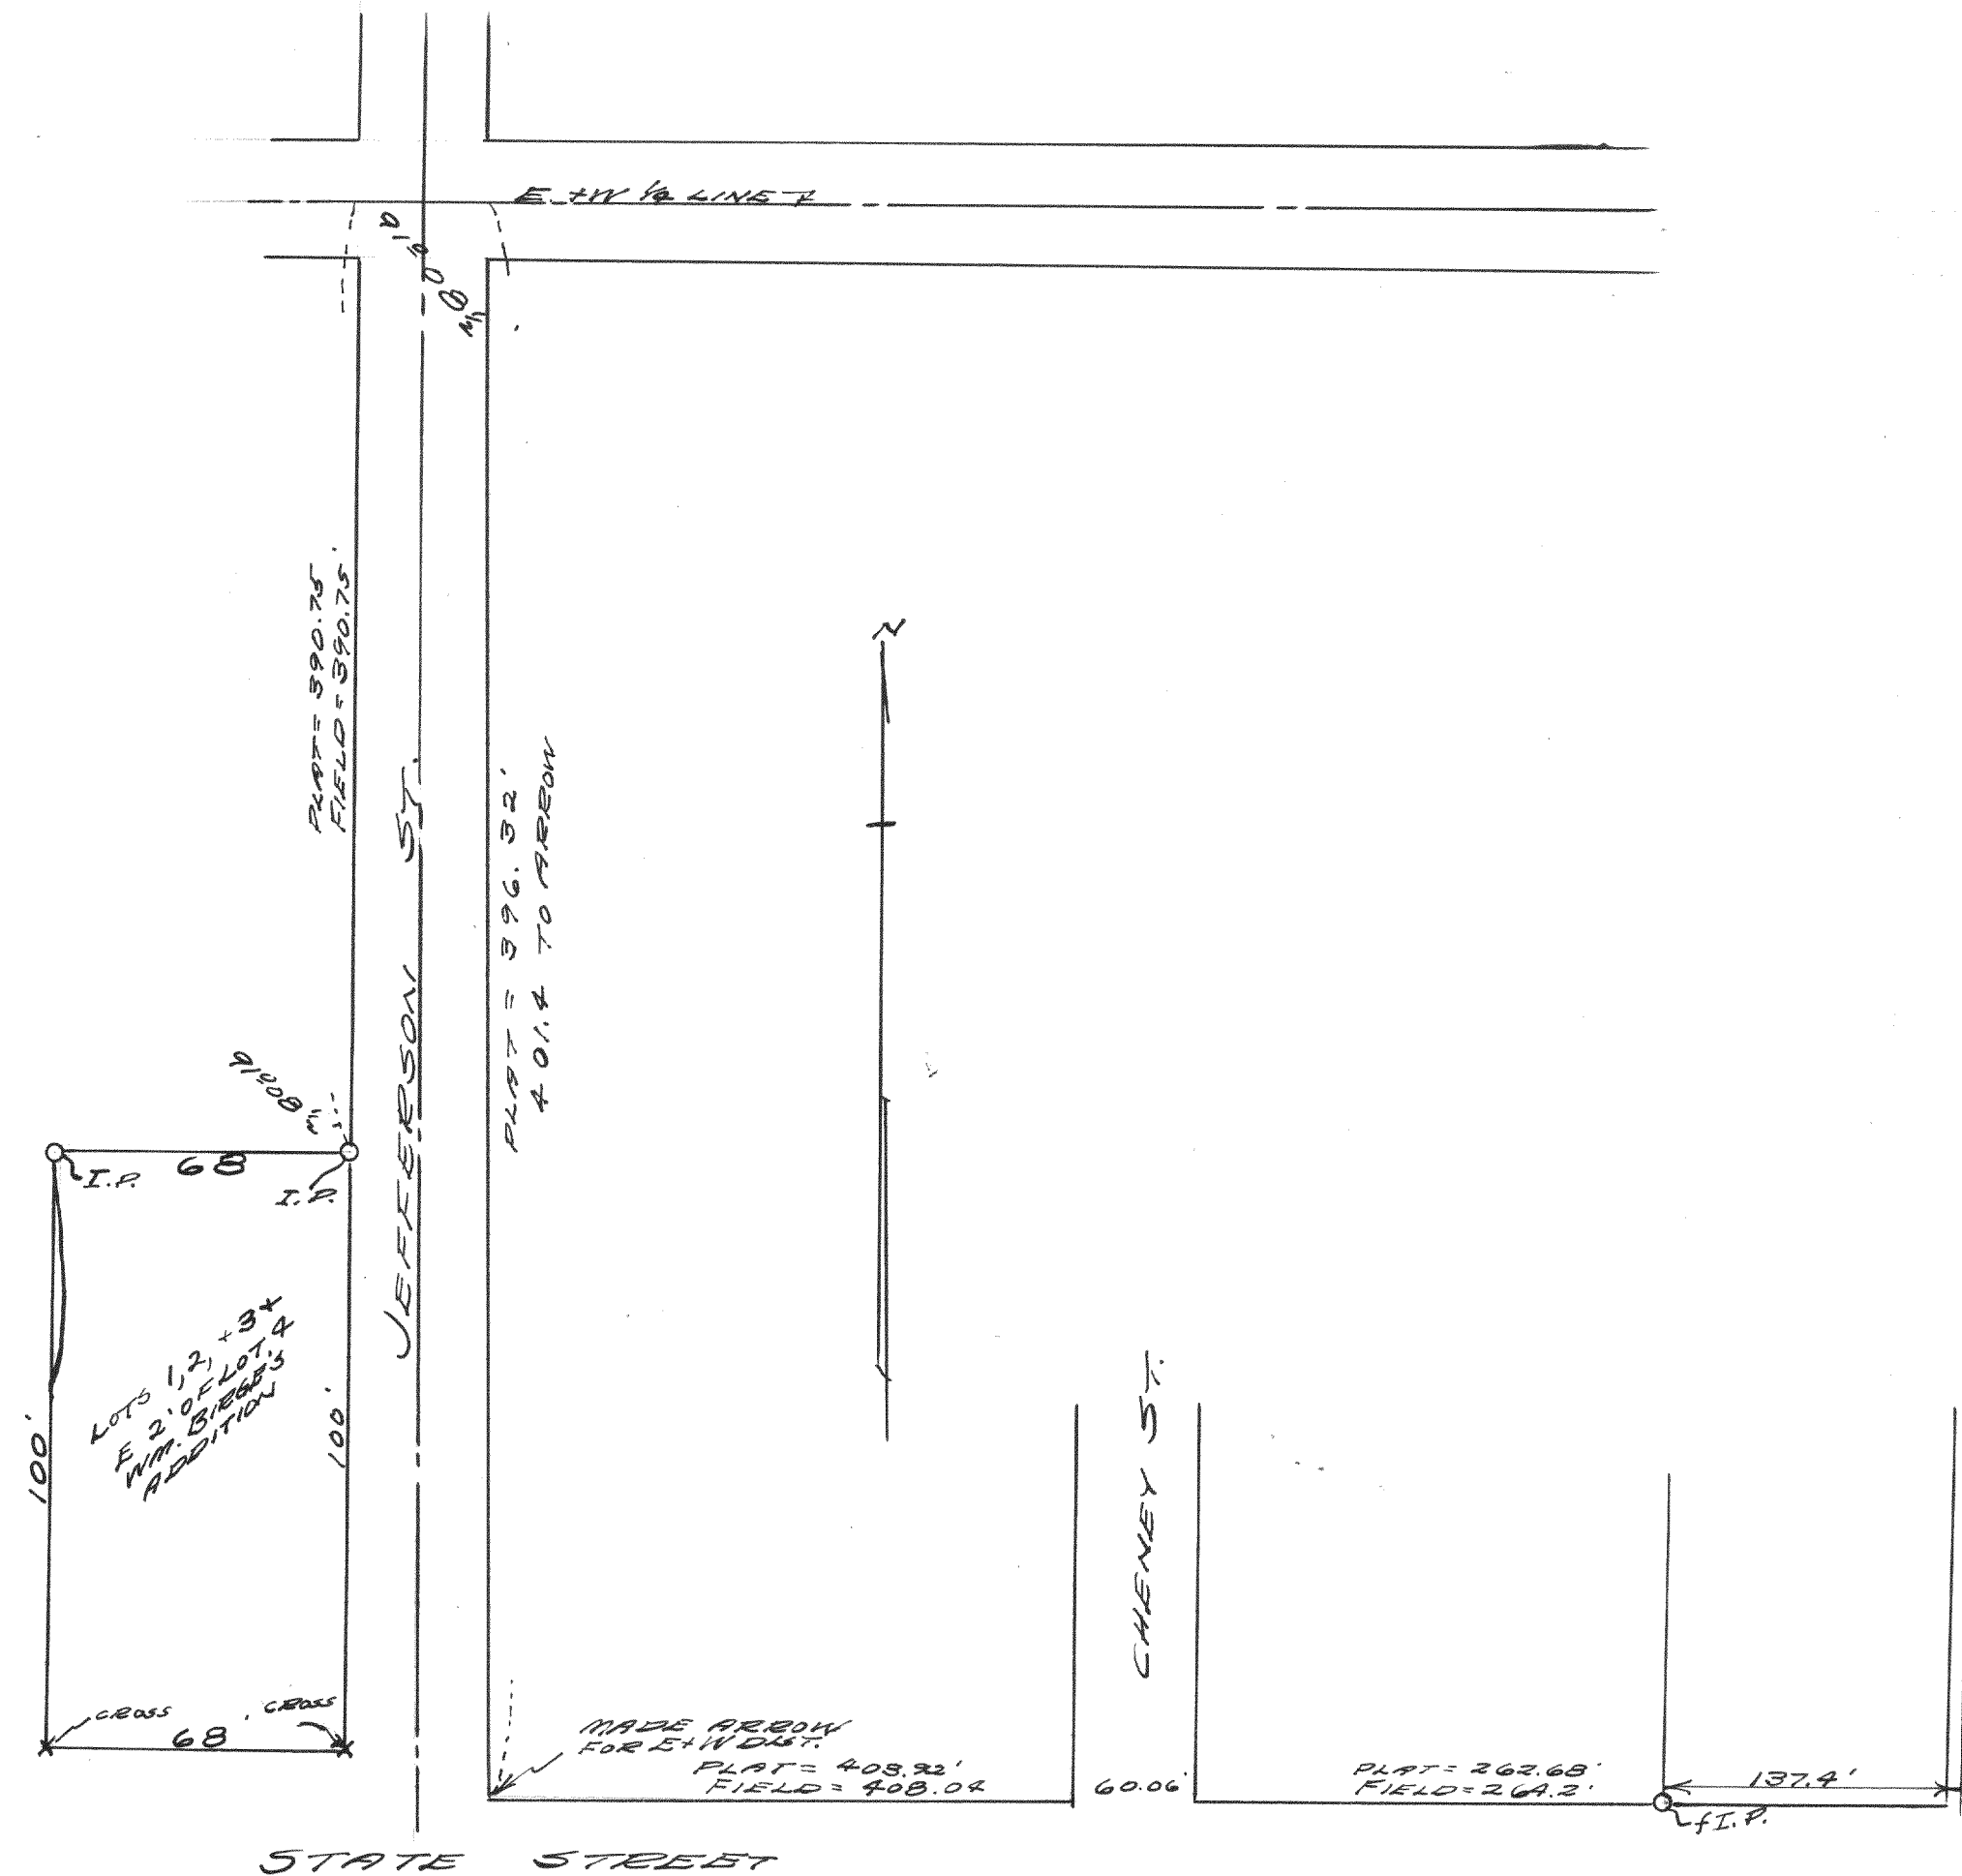

PLAT OF SURVEY OF LOTS 1, 2, 3 AND THE EAST 2' OF LOT 4 OF
WM. BIERGES ADD. TO THE CITY OF WHITEWATER, WALWORTH
COUNTY, WISCONSIN
JUNE, 1941
Lloyd L. Jensen
R.E.G.