



2244

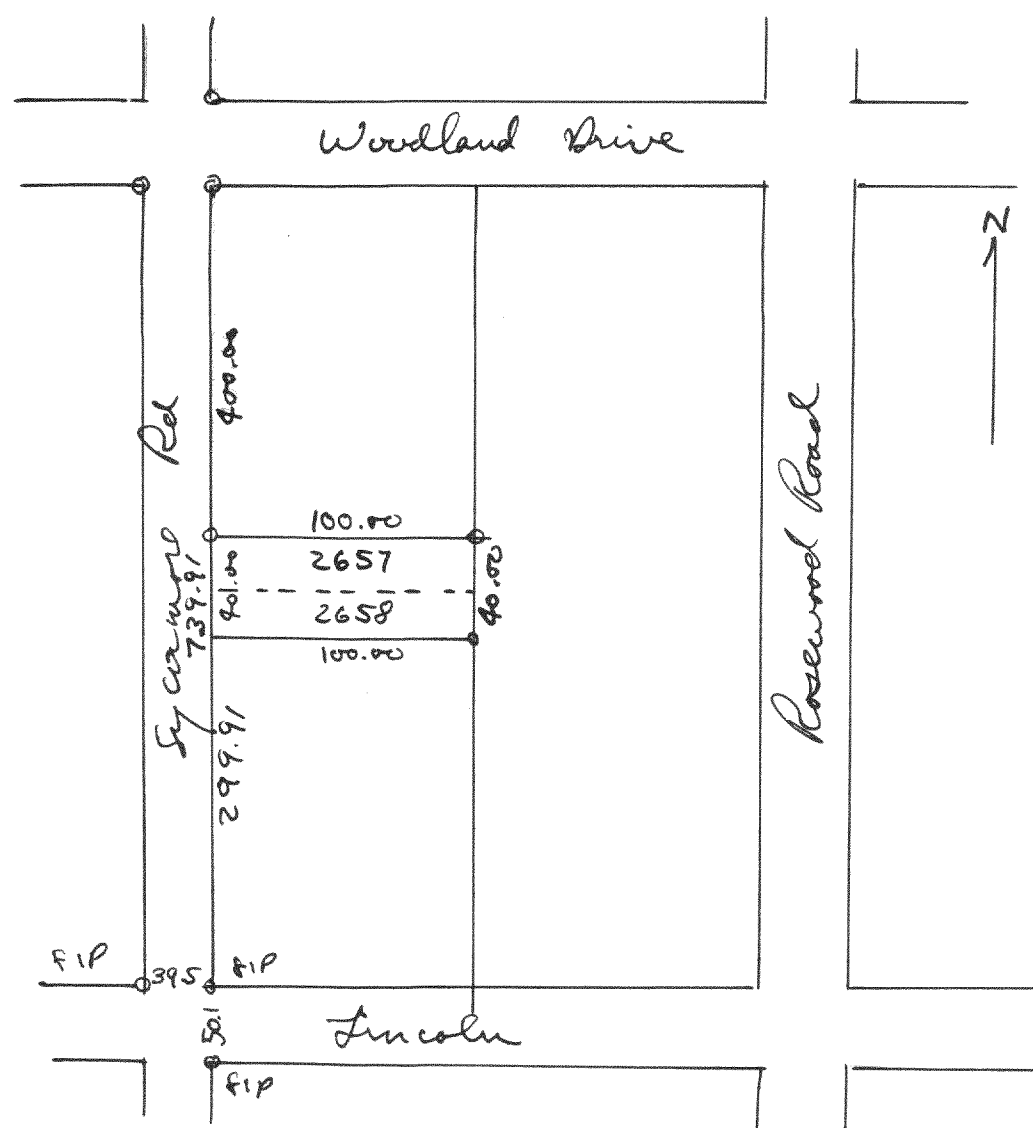


Plat of survey of lots 2657-2658 of Lake Como Beach
Subd located in Sec 21 & 22, T2N R17E of Walworth County, Wis.
May 1, 1950
Floyd L. Jensen
County Surveyor

2245

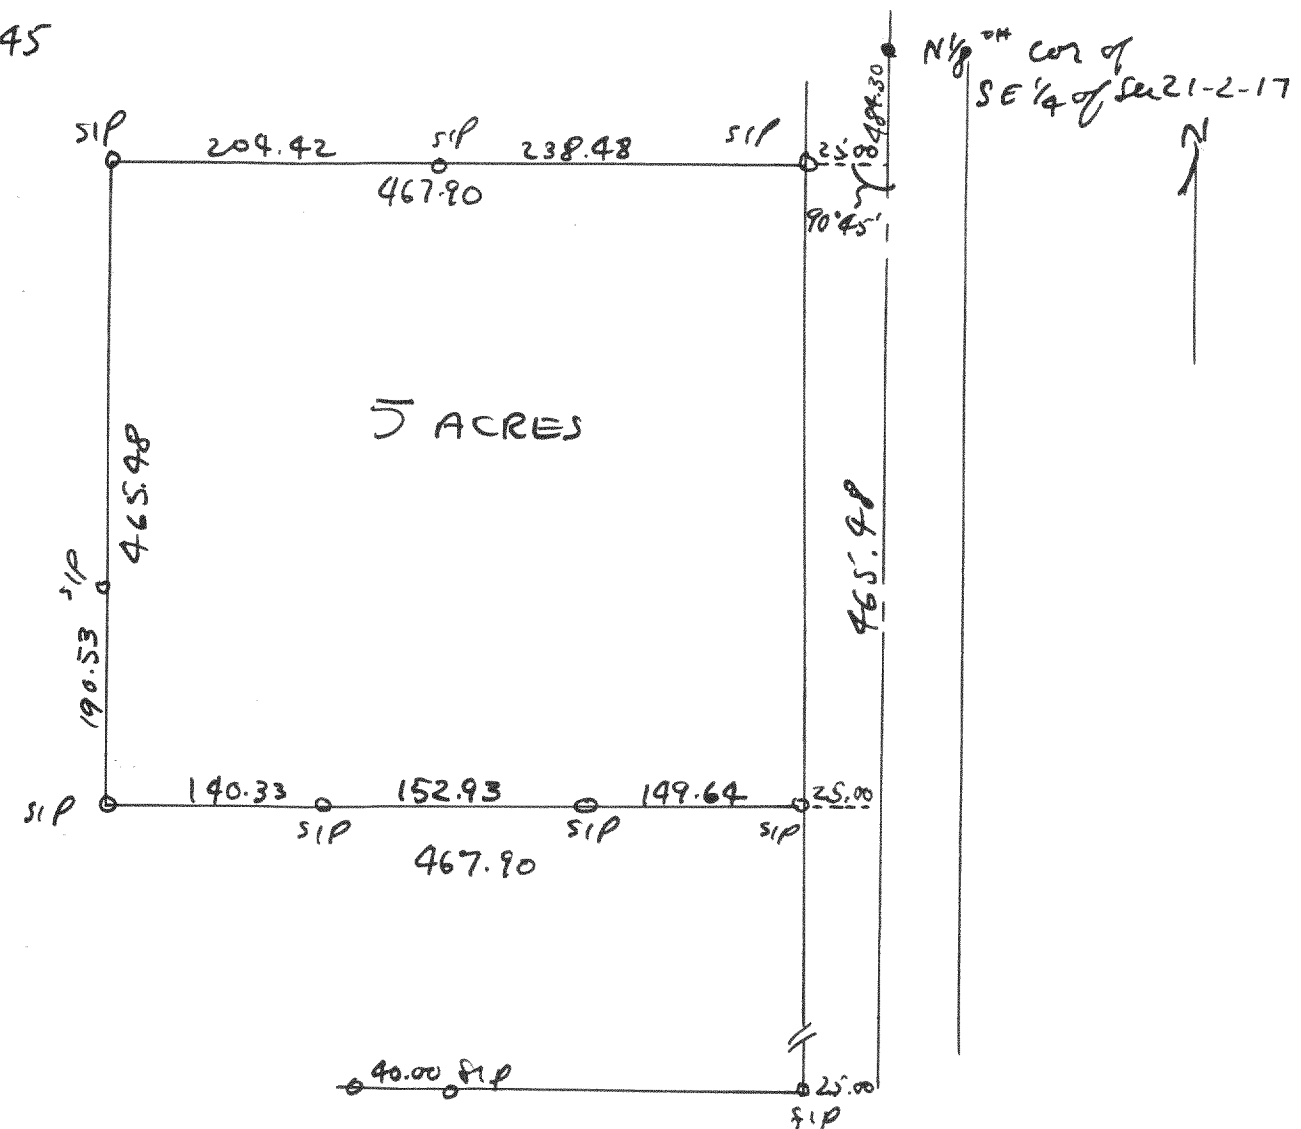


Plat of survey of the same parcel for Como School located in
the SE 1/4 of Sec 21 T2N R17E of Walworth County, Wis.
May 10, 1950
Floyd L. Jensen
County Surveyor

2246

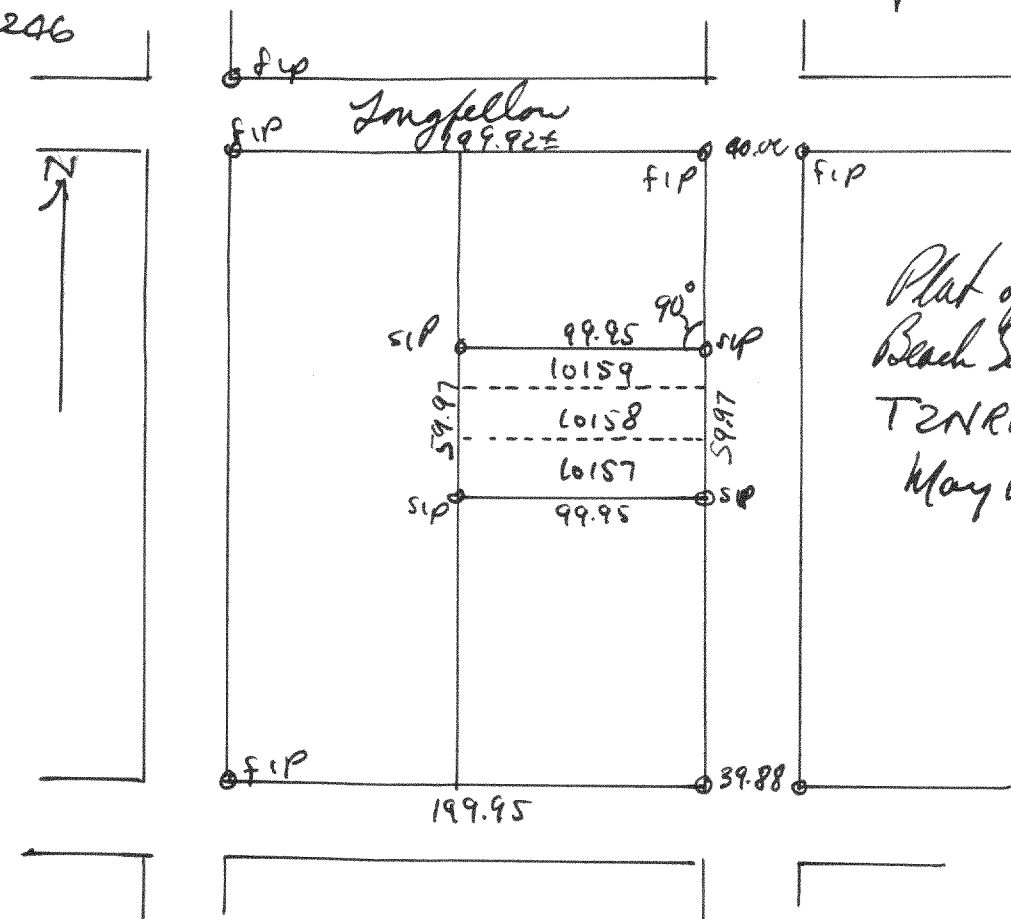

Plat of survey of lots 10157-10159 Lake Como
Beach Subd located in Sec 21 & 22
T2N R17E of Walworth County, Wis.
May 12, 1950
Floyd L. Jensen
County Surveyor

2247

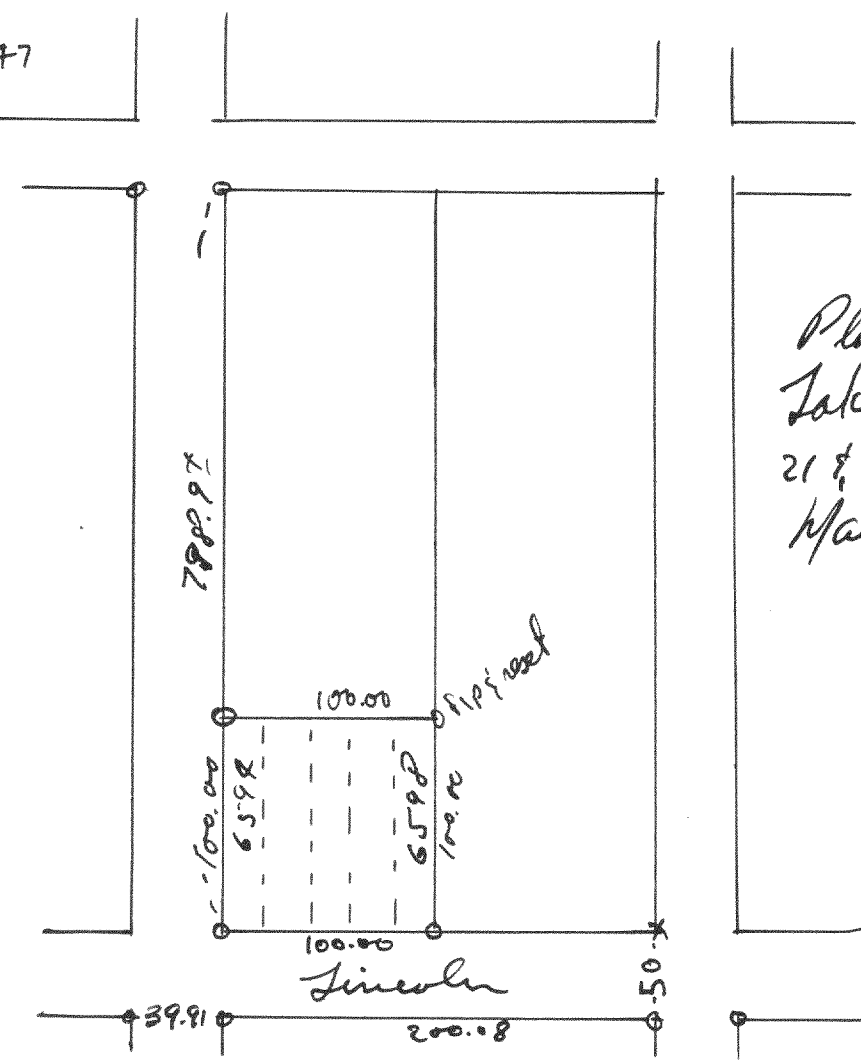

Plat of Survey of lots 6598-6599 of
Lake Como Beach Subd located in Sec.
21 & 22, T2N R17E of Walworth County, Wis.
May 31, 1950
Floyd L. Jensen
County Surveyor